


JUL 15 2011

SURVEY OF ACREAGE PARCEL

LOCATED IN VIRGINIA MILITARY SURVEY NO. 1462
CITY OF COLUMBUS, FRANKLIN COUNTY, OHIO

Franklin County Engineer
Dean C. Ringle, P.E., P.S.

The Basis of Bearings shown hereon was transferred from a GPS survey of Franklin County Monuments "FCGS 4432" and "FCGS 4448" performed by the Franklin County Engineer's Office, and is based upon the NAD83 Ohio State Plane Coordinate System, South Zone, 1986 adjustment, and determines the bearing between said monuments as N 87° 12' 51" W.

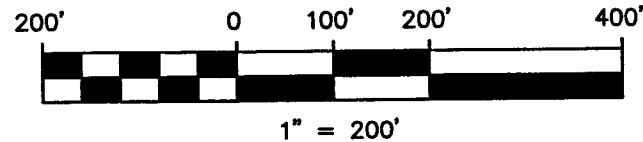


LEGEND

- Iron Pipe Found ○ Iron Pin Set
- ✕ PK Nail Found ✕ PK Nail Set
- ▲ RR Spike Found △ RR Spike Set
- ◻ Monument Box ◻ Monument

All iron pins set are 3/4" diameter, 30" long with plastic cap inscribed "Advanced 7661".

We do hereby certify that we have surveyed the above premises, prepared the attached plat, and that said plat is correct. All dimensions are in feet and decimal parts thereof.

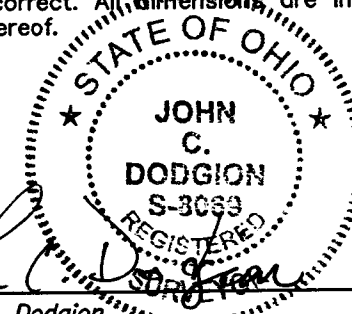

John C. Dodgion
John C. Dodgion
Professional Surveyor No. 8069
Date: *07/15/2011*

*Georgesville Square Subdivision and Dedication of Holt Road P.B. 87, Pg. 11

GEORGESVILLE ROAD

City of Columbus
2.979 Ac.
D.B. 3633, Pg. 798

Robert Eickholt
Orig. 16.715 Ac.
I.N. 200505230098299

Georgesville TD LLC
1.501 Ac.
I.N. 200606130115127

EZG LLC & H and J II LLC
1.280 Ac.
I.N. 200701030001024

KFC US Properties, Inc.
1.112 Ac.
I.N. 20031220400647

Glimcher Properties LLC
6.657 Ac.
O.R. 30328D19

"Vacant Land"

This survey is based on existing records and an actual field survey performed by Advanced Civil Design, Inc. in April 2004.

DRAWN BY: <i>CEW</i>	JOB NO.: 04-0001-88
DATE: 04/04/06	CHECKED BY: DRH

Rev.: 07/01/2011



422 Beecher Road
Gahanna, Ohio 43230
ph 614.428.7750
fax 614.428.7755