C-2-F

SURVEY OF ACREAGE PARCEL

FARM LOTS 59 & 60, QUARTER TOWNSHIP 2, TOWNSHIP 2, RANGE 18
UNITED STATES MILITARY LANDS
CITY OF COLUMBUS, COUNTY OF FRANKLIN, STATE OF OHIO

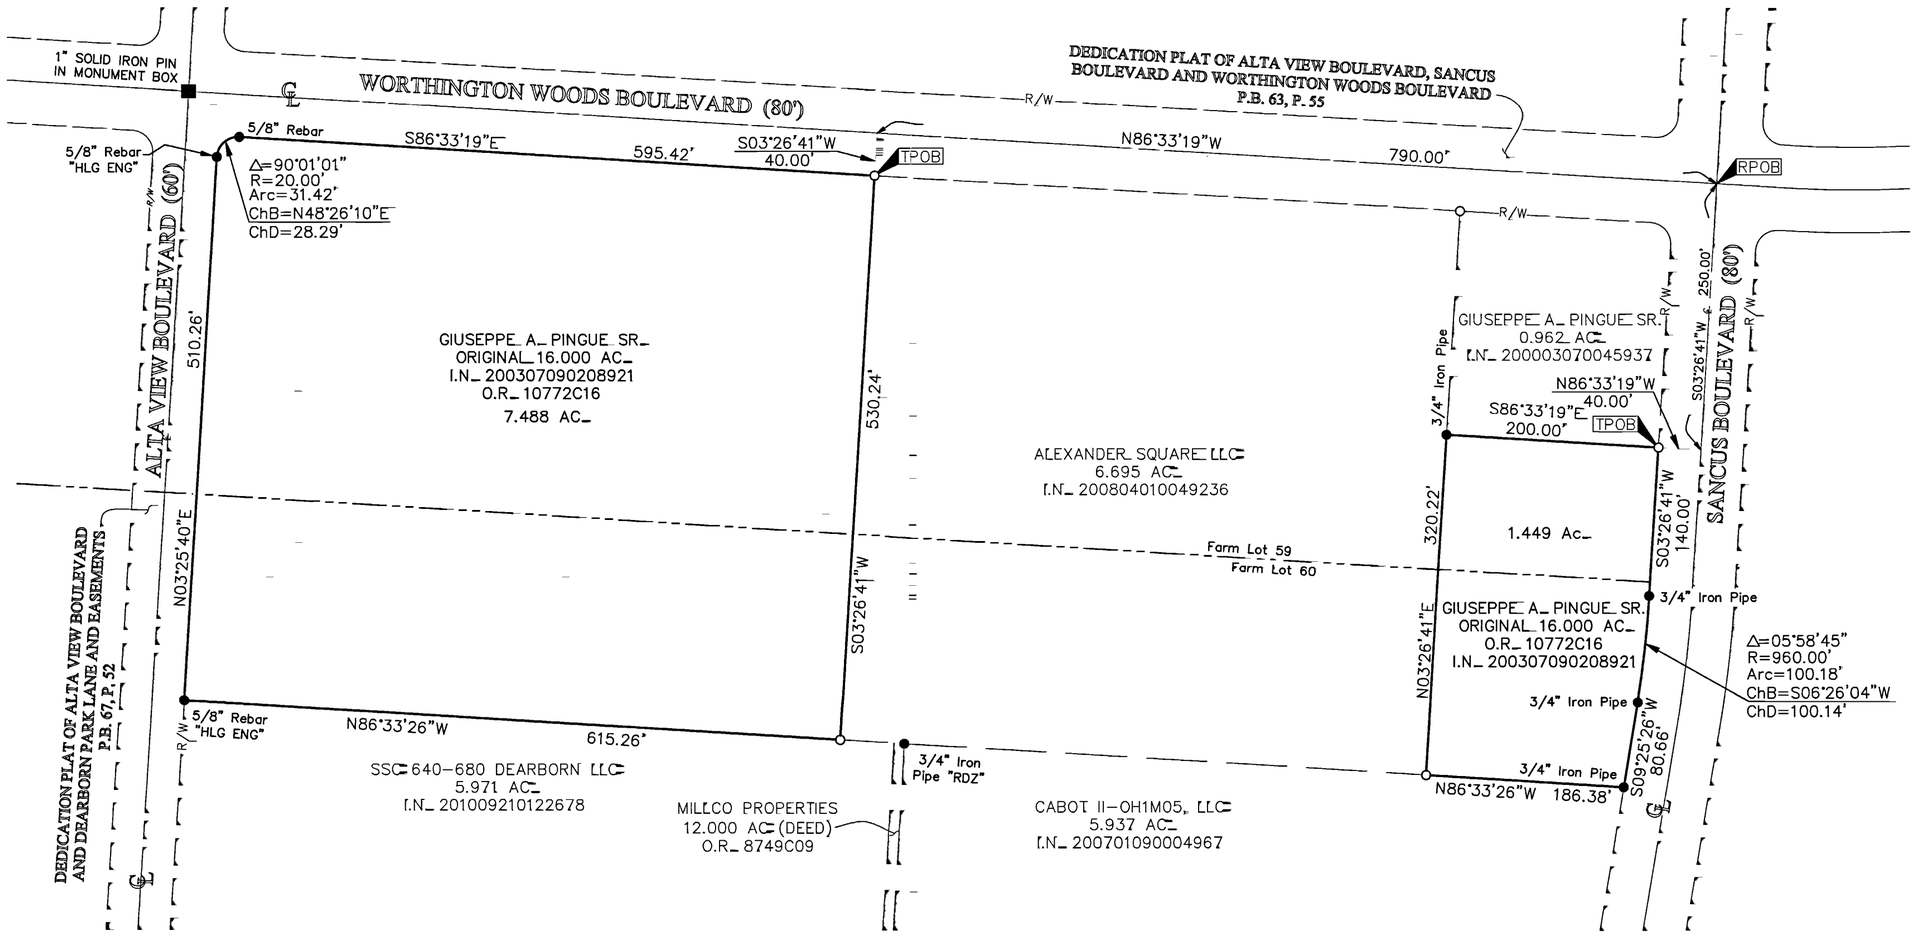

● = STONE FND.
■ = MON. FND.
● = I.P. FND.
○ = I.P. SET
⬟ = MAG. NAIL FND.
○ = MAG. NAIL SET
▲ = R.R. SPK. FND.
△ = R.R. SPK. SET
⬟ = P.K. NAIL FND.
I.P. Set are 13/16" I.D. iron pipe with cap inscribed EMHT INC

100' 0 100' 200'
GRAPHIC SCALE (in feet)

BASIS OF BEARINGS: The bearings shown on this survey are based on the Ohio State Plane Coordinate System, South Zone, NAD83 (CORS96). Said bearings originated from a field traverse which was tied (referenced) to said coordinate system by GPS observations and observations of selected CORS base stations in the National Spatial Reference System. The portion of the centerline of Worthington Woods Boulevard, having a bearing of North 86° 33' 19" West and monumented as shown hereon, is designated the "basis of bearing" for this survey.

FEMA NOTE:
According to the Federal Emergency Management Agency's Flood Insurance Rate Map (dated June 17, 2008), the subject tract shown hereon lies within Zone X (areas determined to be outside of the 0.2% annual chance floodplain), Community Panel Nos. 39049C0157K and 39049C0176K.

SURVEY NOTE:
This survey was prepared using documents of record, prior plats of survey, and observed evidence located by an actual field survey.

STATE OF OHIO
HEATHER L. KING
8307
REGISTERED
PROFESSIONAL SURVEYOR

By Heather L. King 3/13/12
Heather L. King
Professional Surveyor No. 8307
Date

RECEIVED
MAR 13 2012
Franklin County Engineer
Dean C. Ringle, P.E., P.S.

EMH&T
Evans, Mechwart, Hambleton & Tilton, Inc.
Engineers • Surveyors • Planners • Scientists
5500 New Albany Road, Columbus, OH 43054
Phone: 614.775.4500 Toll Free: 888.775.3648
emht.com

Date: March 12, 2012
Scale: 1" = 100'
Job No: 2012-0433
Sheet: 1 of 1

REVISIONS

MARK	DATE	DESCRIPTION

ZZ Design Inc. / Worthington Woods Lot Split / 2012-0433 / 20120433BNDY

J:\20120433\20120433SVY\DWG\20120433BNDY.DWG plotted by KING, HEATHER on 3/13/2012 9:42:43 AM last saved by HKING on 3/13/2012 9:39:58 AM EDT