


# Lot Split Exhibit

Quarter Township 3, Township 1, Range 16, United States Military District  
City of Gahanna, Franklin County, Ohio

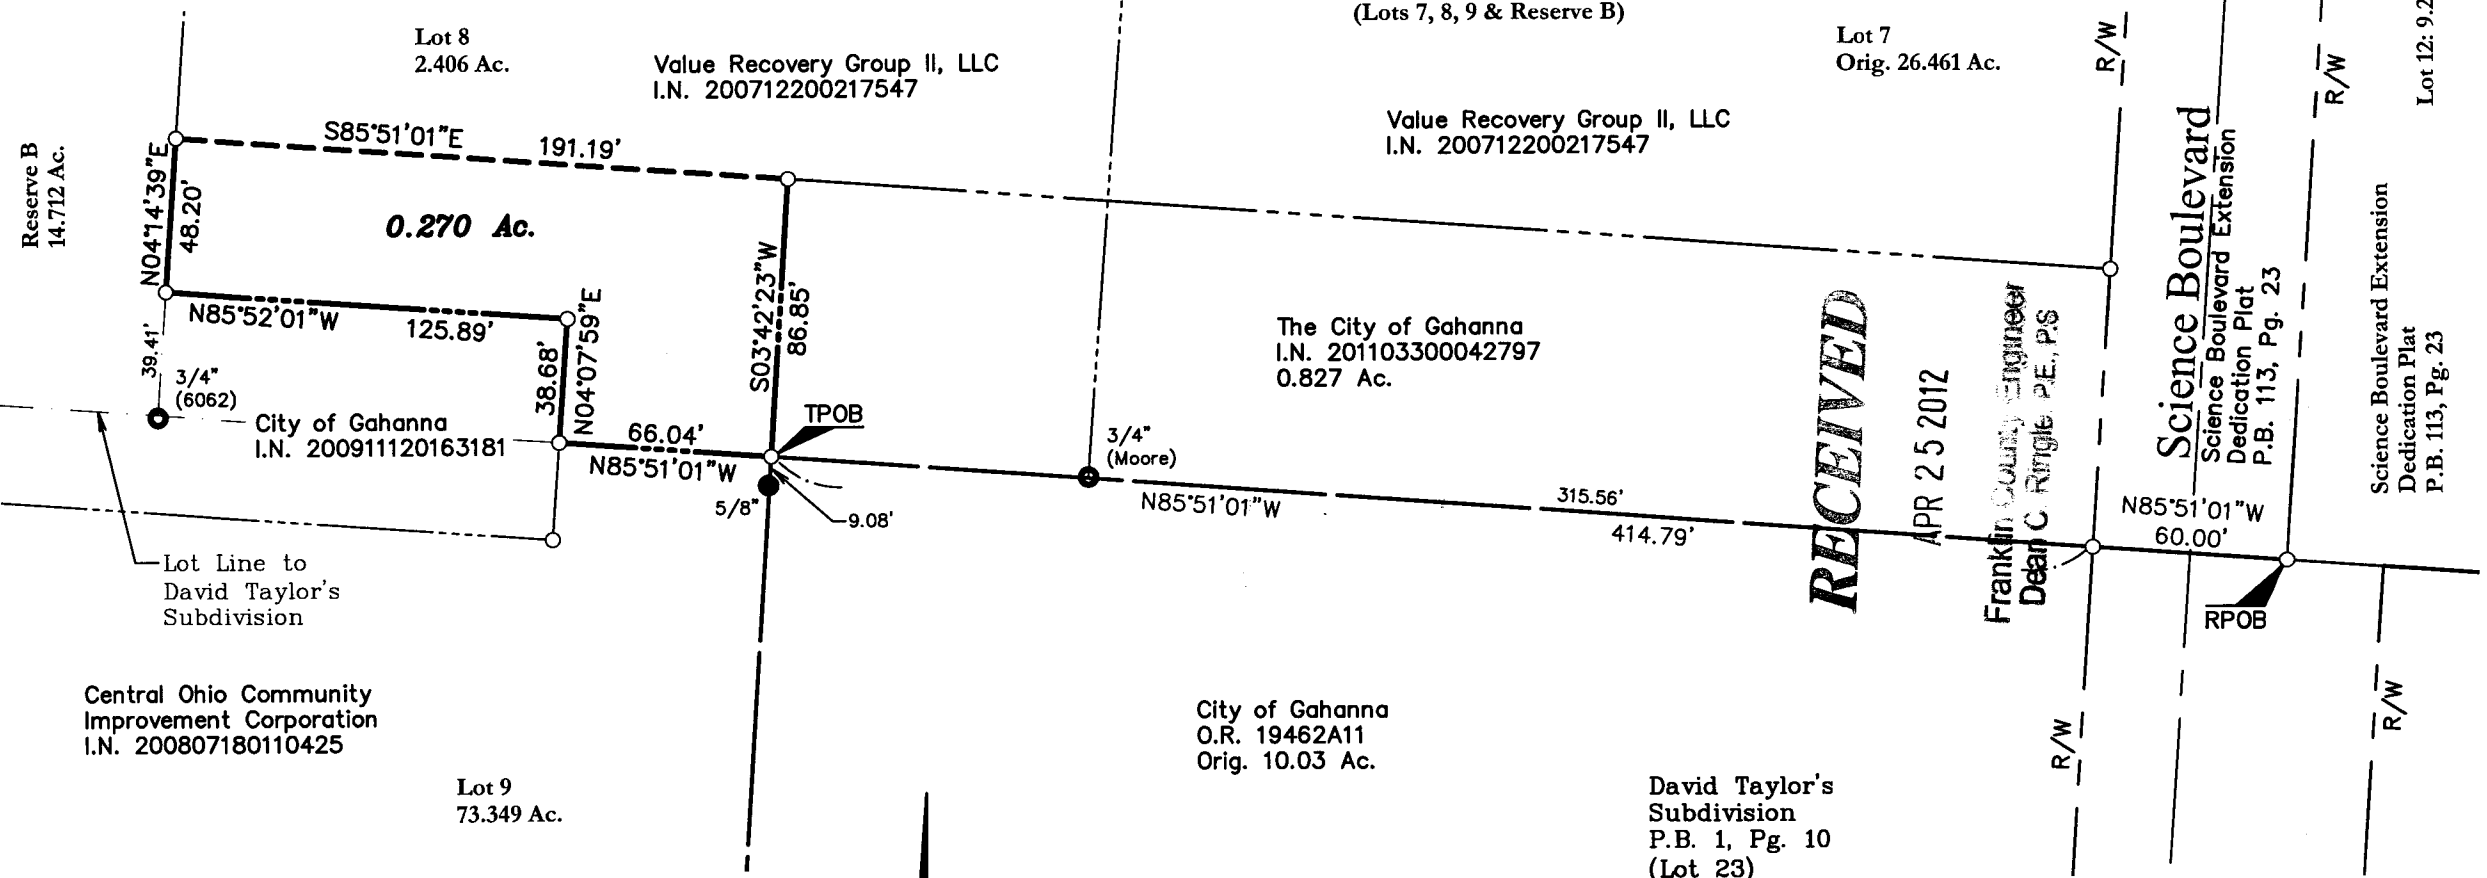

**RECEIVED**


APR 25 2012

Franklin County Engineer  
Dean C. Ringle, P.E., P.S.


Science Boulevard  
Science Boulevard Extension  
Dedication Plat  
P.B. 113, Pg. 23

Iron pins set are 3/4" diameter, 30" long iron pipe with a plastic cap inscribed "Advanced 7661".

Bearings are based on the Ohio State Plane Coordinate System, NAD83 South Zone (1986 Adj.). A bearing of S 33° 55' 24" W was held between Franklin County Monuments FCGS 5524 and FCGS 1164 Reset.

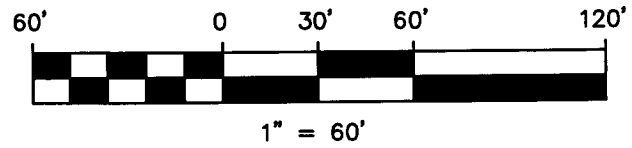

- Iron Pin Set
- ⊗ PK Nail Set
- Iron Rod Found
- ⦿ Iron Pipe Found
- ▲ RR Spike Found
- ☐ Monument Box

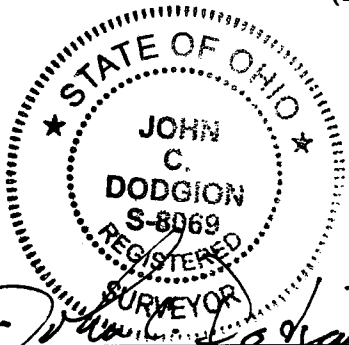

*John C. Dodgion*  
John C. Dodgion, P.S. 8069  
04/24/2012

DRAWN BY: JCD	JOB NO.: 08-0006-188
DATE: 04/13/2012	CHECKED BY: JCD

**ADVANCED**  
CIVIL DESIGN  
ENGINEERS SURVEYORS

422 Beecher Road  
Gahanna, Ohio 43230  
ph 614.428.7750  
fax 614.428.7755