
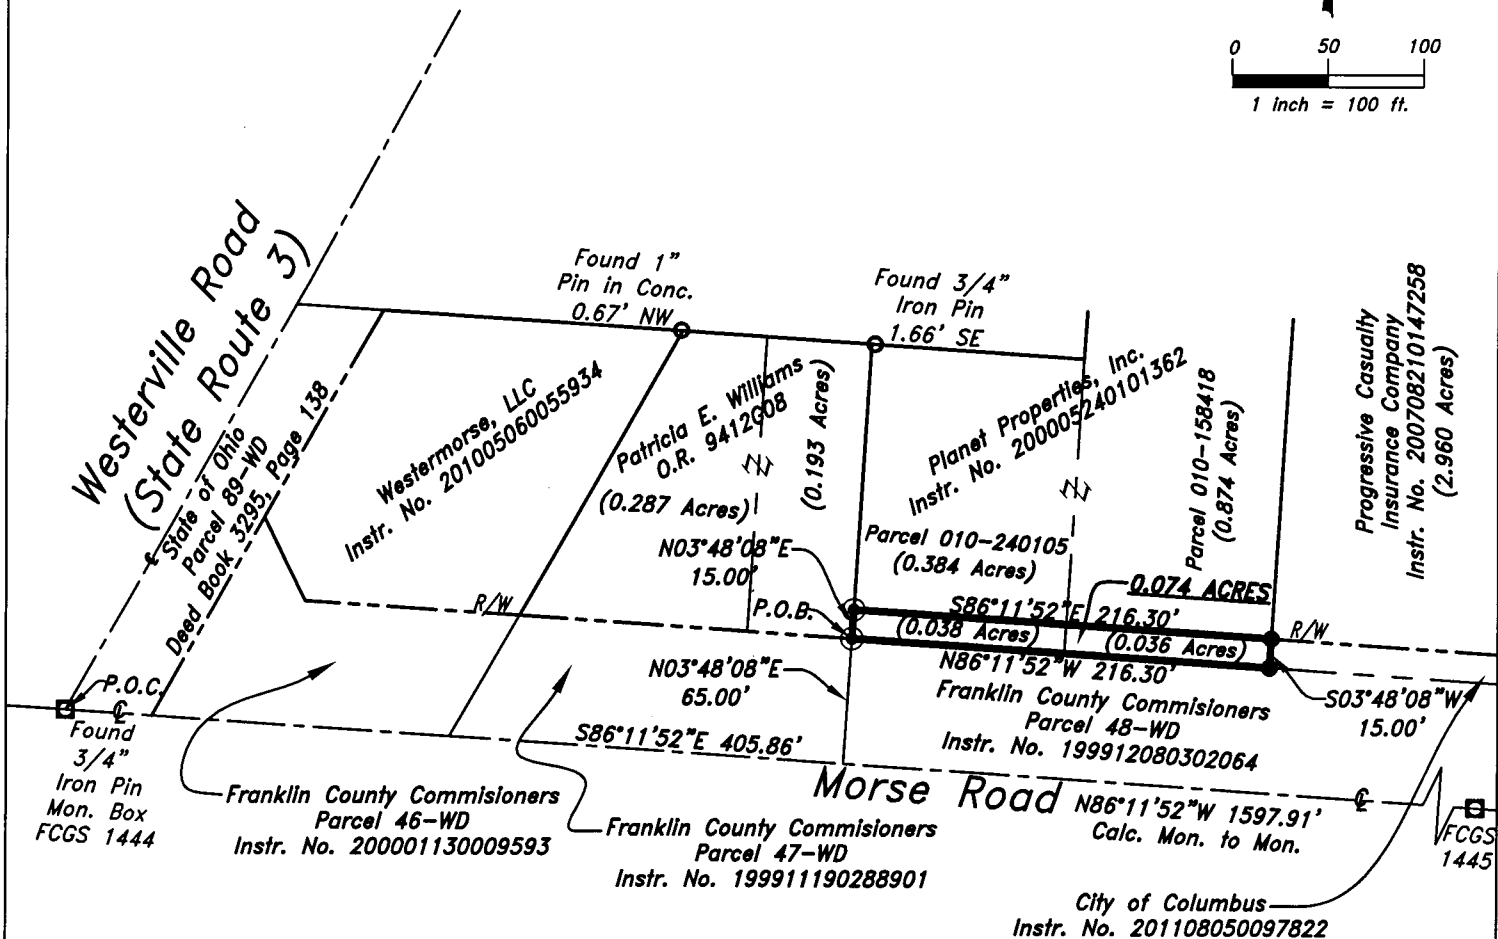


0.074 ACRE PARCEL
Quarter Township 3, Township 2, Range 17
United States Military Lands
City of Columbus, Franklin County, Ohio

LEGEND

- Found Iron Pin
- Set Mag Nail
- Set Iron Pin
- Found Conc Monument
- ↔ Indicates Mutual Ownership
- R/W Right of Way
- ⊕ Centerline

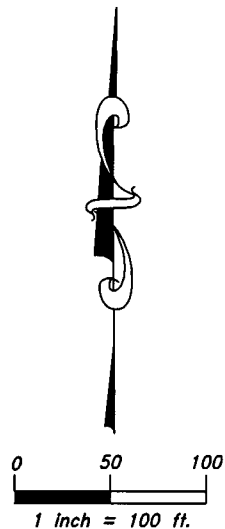

NOTES:

1. Basis of Bearing: Centerline of Morse Road bearing S86°11'52"E, of record in Instrument No. 200708210147258, Recorder's Office, Franklin County, Ohio.
2. Lines of occupation, wherever they exist, generally agree with boundary lines.
3. All monumentation shown in good condition unless otherwise noted.
4. All documents used as shown
5. Prior Deed Reference: Instrument No. 200708210147258.
6. All set iron pins are 5/8" diameter by 30" in length with a plastic cap bearing the number 7911.

RECEIVED

JUL 31 2012

Franklin County Engineer
Dean C. Ringle, P.E., P.S.

Certification:

This survey was prepared under my direct supervision on March 13, 2012 and is correct to the best of my knowledge and belief.

David J. Kueth 7-30-12
 David J. Kueth
 Ohio P.S. No. 7911



BOCK & CLARK

7370 Kingsgate Way, Suite H
West Chester, OH 45069
1-800-787-8392