

P & L SYSTEMS, INC.

SURVEYORS & ENGINEERS

171 CHARRING CROSS DRIVE
WESTERVILLE, OHIO 43081

RECEIVED

SEP 14 2012


28.426 AC. LOT SPLIT PARCEL "A"

Franklin County Engineer
Dean C Ringle P.E., P.S.


SITUATED IN THE STATE OF OHIO, COUNTY OF FRANKLIN, CITY OF HILLIARD AND VIRGINIA MILITARY SURVEY NUMBER 3000, AND BEING A 28.426 ACRE LOT SPLIT OUT OF THE ORIGINAL 62.711 ACRE TRACT CONVEYED TO FIRST INDUSTRIAL, LP IN INSTRUMENT NUMBER 199712300178695, WITH ALL RECORD REFERENCES CITED HEREIN BEING TO THE RECORDS OF THE FRANKLIN COUNTY RECORDER'S OFFICE, COLUMBUS OHIO.

0 150' 300' 600'

SCALE: 1"=300'

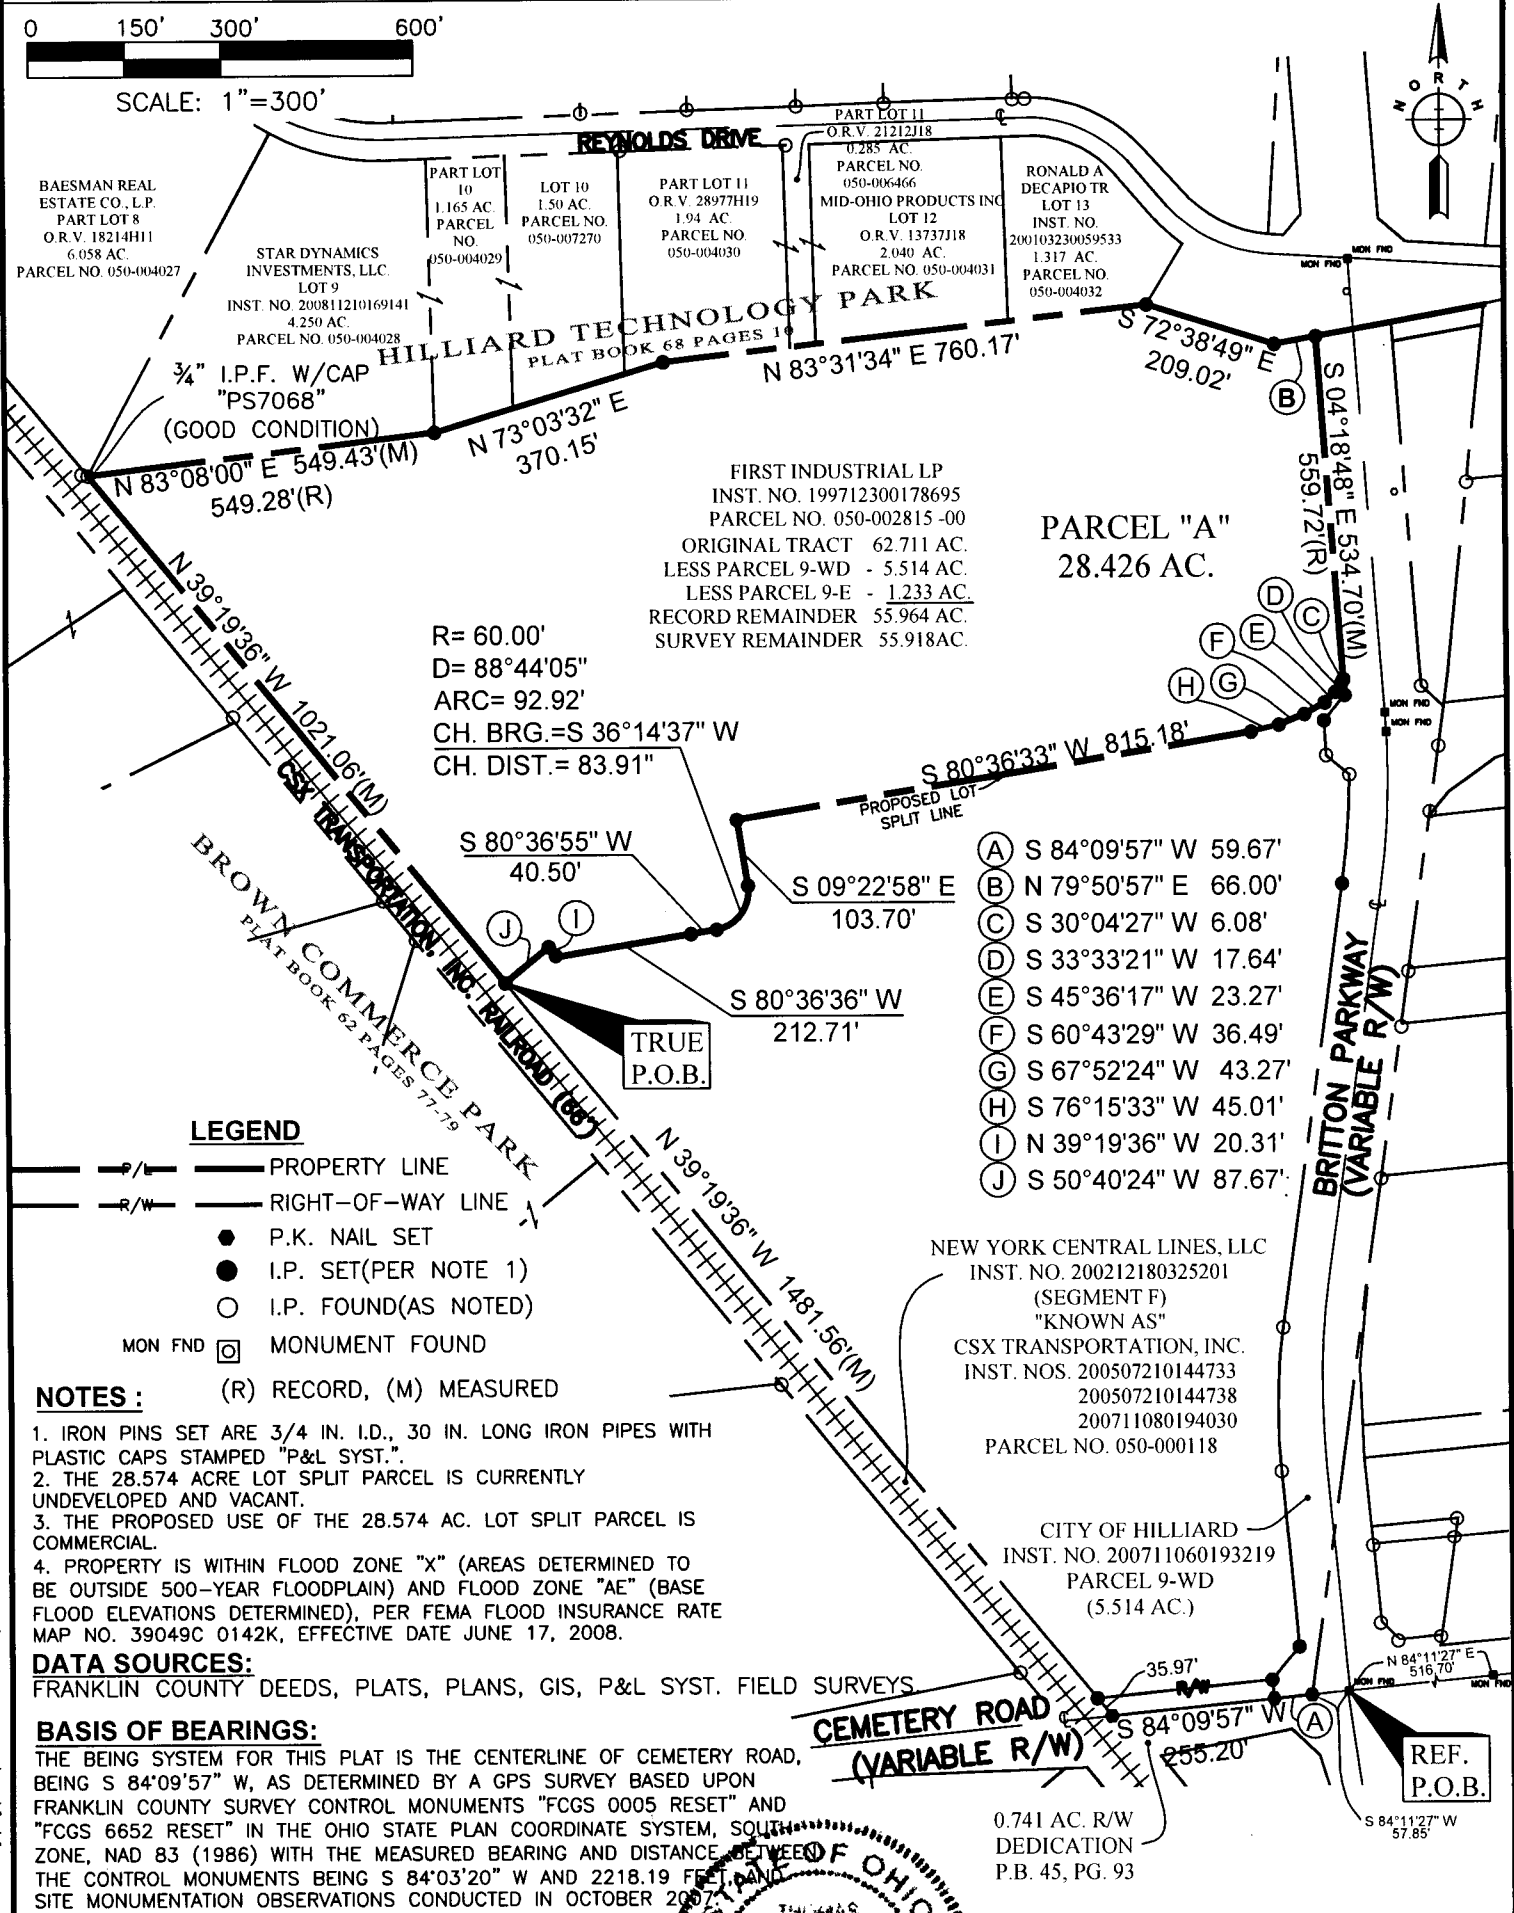

P:\Land Projects 3\Utilities Group\Cemetery-Britton Parkway\Fig\Lot Split 28.546 Ac. Cemetery-Britton Parkway.dwg by drh on 09/12/2012 11:04:55 am for P & L Systems, Inc.

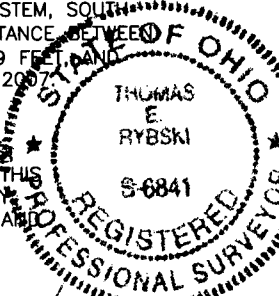

SIGNATURE: *Thomas E. Rybski* DATE: 9/13/12

P & L Systems, Inc.
Surveyors • Engineers
Planners
171 Charring Cross Dr.
Westerville, Ohio 43081
Phone: (614) 891-4970
Fax: (614) 891-4984