RECEIVED

OCT 10 2012

Franklin County Engineer
Dean C. Ringle, P.E., P.S.

J-4-F

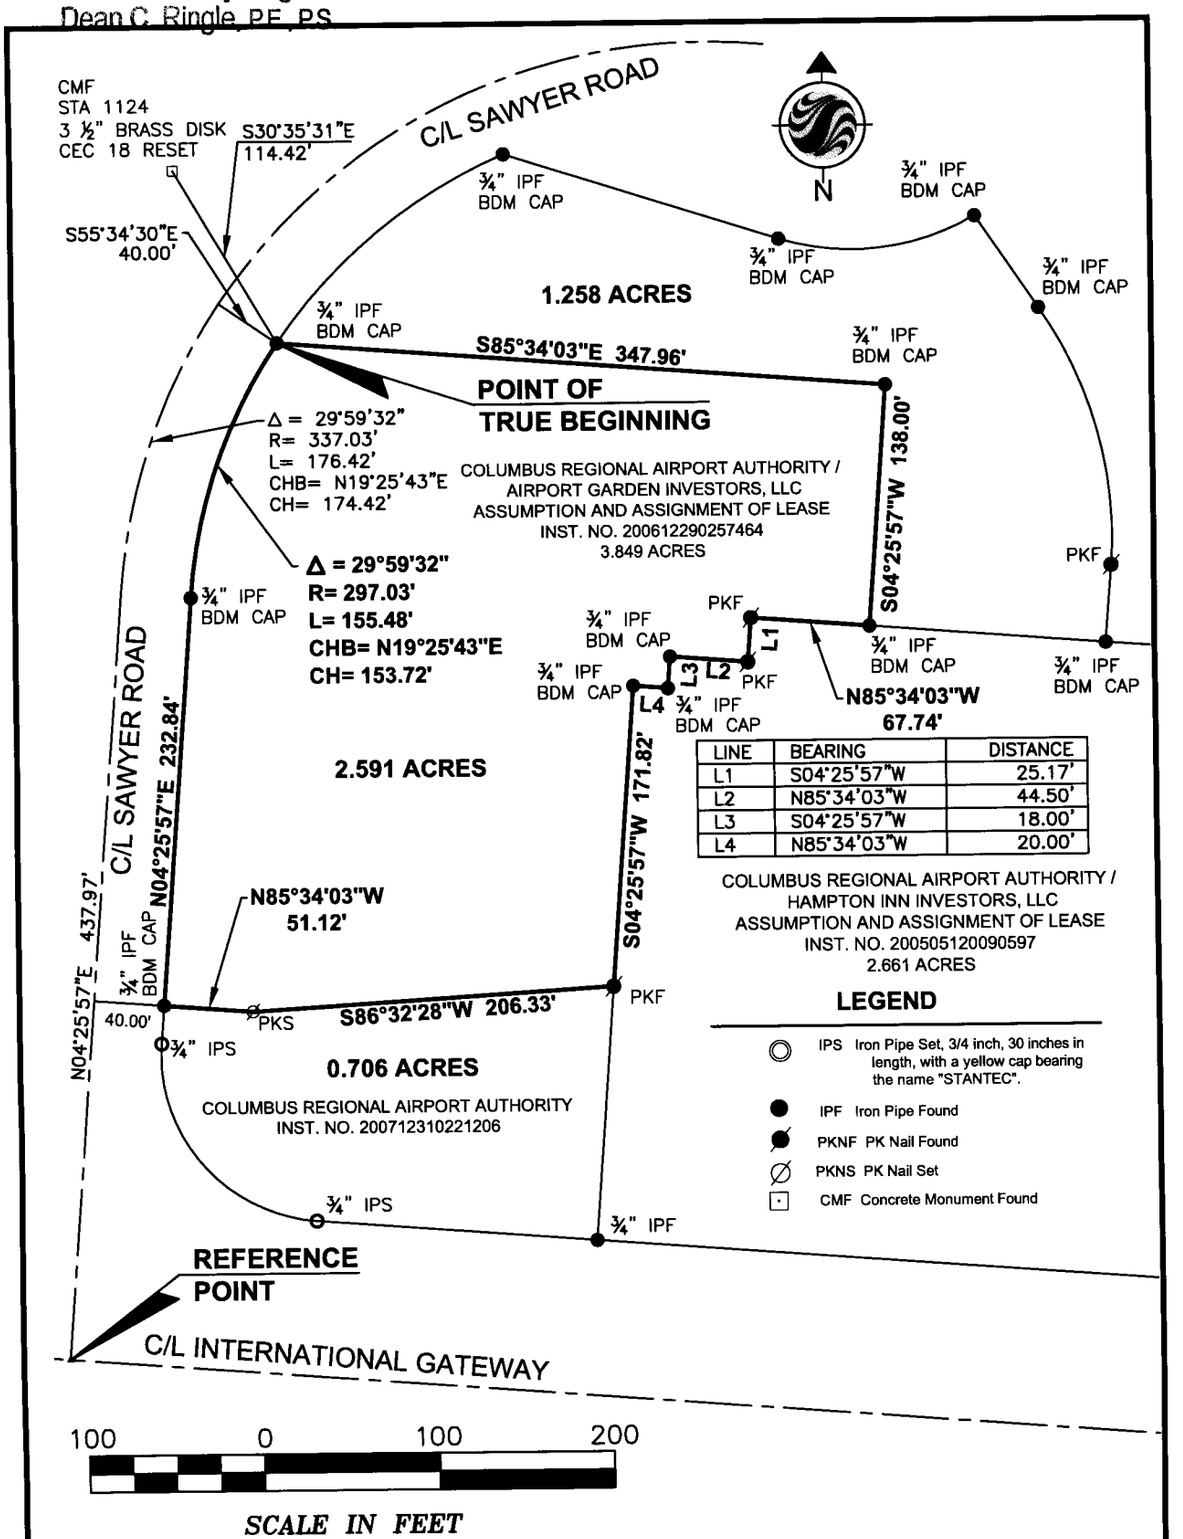

LINE	BEARING	DISTANCE
L1	S04°25'57"W	25.17'
L2	N85°34'03"W	44.50'
L3	S04°25'57"W	18.00'
L4	N85°34'03"W	20.00'

COLUMBUS REGIONAL AIRPORT AUTHORITY /
HAMPTON INN INVESTORS, LLC
ASSUMPTION AND ASSIGNMENT OF LEASE
INST. NO. 200505120090597
2.661 ACRES

LEGEND

- IPS Iron Pipe Set, 3/4 inch, 30 inches in length, with a yellow cap bearing the name "STANTEC".
- IPF Iron Pipe Found
- PKNF PK Nail Found
- PKNS PK Nail Set
- CMF Concrete Monument Found

BASIS OF BEARINGS:

The bearings shown hereon are based on the Grid Bearing of South 53°08'13" West between Port Columbus International Airport Control Stations 1124 and 1146 as determined by a GPS network of field observations performed in September, 2012, State Plane Coordinate System, South Zone, NAD83 (2007).

CERTIFICATION:

I hereby certify that this survey shown on the attached plat was prepared from an on the ground survey on September 27, 2012 made under my direct supervision and that it and the information, courses and distances as shown are correct to the best of my knowledge.

STANTEC CONSULTING SERVICES INC.

STATE OF OHIO ROBERT J. SANDS S-8053 REGISTERED PROFESSIONAL SURVEYOR

10/02/12

Robert J. Sands Date
Professional Surveyor No. S-8053

BOUNDARY SURVEY OF

2.591 ACRES

Lying in

Quarter Township 4, Township 1, Range 17

UNITED STATES MILITARY LANDS

CITY OF COLUMBUS, FRANKLIN COUNTY, OHIO

Scale: 1 inch = 100 Feet

Prepared by:

1500 Lake Shore Drive
Columbus, Ohio 43204
Phone: (614) 486-4383
Fax: (614) 486-1046

Stantec

Copyright Reserved
The Contractor shall verify and be responsible for all dimensions. DO Not scale the drawing – any errors or omissions shall be reported to Stantec without delay. The Copyrights to all designs and drawings are the property of Stantec. Reproduction or use for any purposes other than that authorized by Stantec is forbidden.

U:\173410229\survey\CRA Hilton Property\173410229 hilton-crao area 2.dwg Layout1 Oct 03, 2012 – 11:07:30am rwallace