




635 Brookside Boulevard
Westerville, OH 43081
Contact: BOB WYND
614-818-4900
Fax: 614-818-4902
www.mecompanies.com

PROPERTY SPLIT EXHIBIT
PITMAN PROPERTY
6891 RINGS ROAD
WASHINGTON TOWNSHIP,
FRANKLIN COUNTY, OHIO

GRAPHIC SCALE


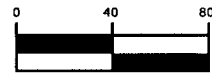


(IN FEET)

1 inch = 80 ft.



STATE OF OHIO, COUNTY OF FRANKLIN,
TOWNSHIP OF WASHINGTON
VIRGINIA MILITARY SURVEY No. 6953

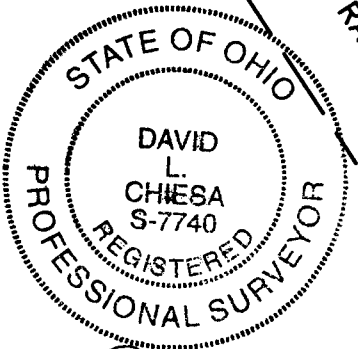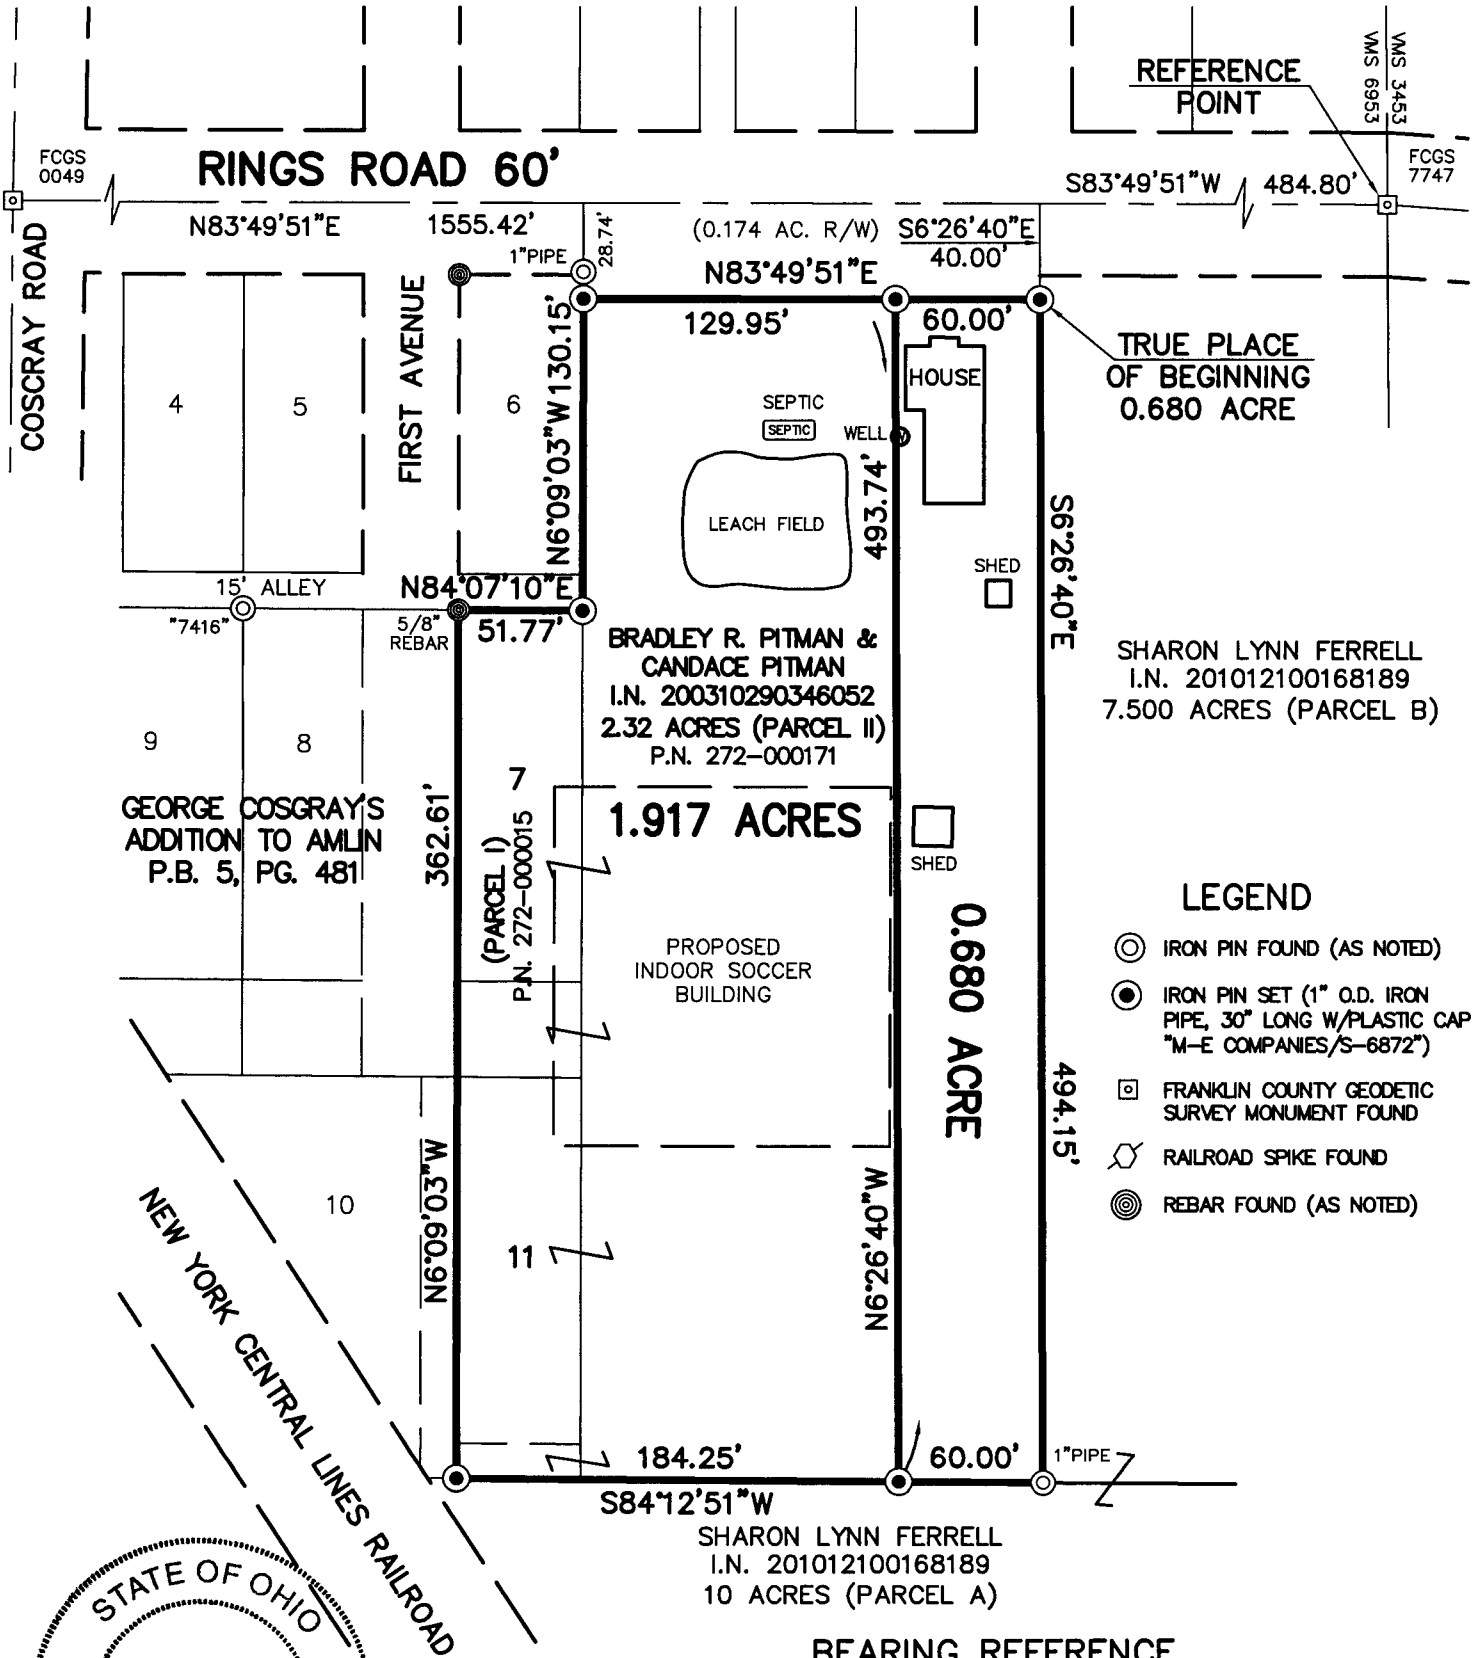

BEARING REFERENCE
BEARINGS HEREON ARE BASED ON A BEARING OF NORTH 83°49'51" EAST FOR RINGS ROAD ESTABLISHED FROM FRANKLIN COUNTY ENGINEERS SURVEY OF FRANKLIN COUNTY GEODETIC SURVEY MONUMENTS FCGS 0049 AND FCGS 7747.

David L. Chiesa 7740
REGISTERED SURVEYOR NO. DATE 7/3/13