


**LEGEND**

- 1/2" IRON AUTO AXEL (FOUND)
- 1/4" CONCRETE FENCE POST (FOUN)
- 1/2" IRON PIPE (FOUND)
- 2" IRON TEE BAR B. CAP (FOUND)
- 2" DIA. SOLID IRON PIN (FOUND)
- SURVEY MONUMENT 3/8" IRON PIN IN CONCRETE IN 10" IRON PIPE (FOUND)
- ▲ 4" CONCRETE R/W MONUMENT (FOLD)
- RAIL ROAD SPIKE (FOUND)
- MAG. NAIL (SET)
- 5/8" x 3" REBAR IN YELLOW PLASTIC CAP STAMPED "COTTRILL 5855" (SET)
- ALL MONUMENTS FOUND OR SET ARE IN GOOD CONDITION UNLESS OTHERWISE NOTED.
- TAX MAP PARCEL NUMBER

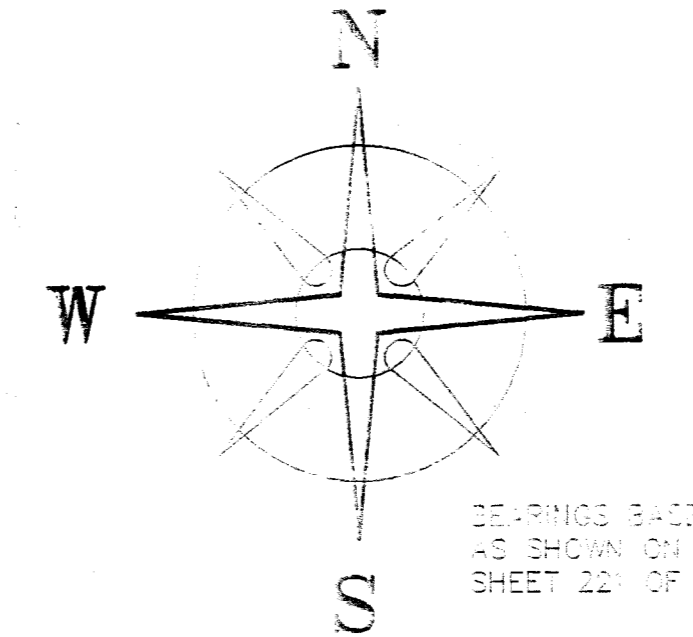

BEARINGS BASED ON THE C. OF I. T. (S61°04'10"E)  
AS SHOWN ON DOT R/W PLAN JOB # FRA-82-2.12  
SHEET 22 OF 240.

**142.3793+/- ACRES**

**GENEVIEVE & EDWARD E. SHEETS (TRUSTEE)**  
107.78 ORIG. ACRES  
D.B. 3606 PG 174  
INST. NO. 199904210099140  
#230-000264  
93.1067 +/- ACRES

**GENEVIEVE & EDWARD E. SHEETS (TRUSTEE)**  
74.63 ORIG. ACRES  
INST. NO. 199904210099140  
230-000506  
49.2726 +/- ACRES

**RONALD L. & NANCY A. BUCHANAN**  
28.2936 ACRES  
VOL. 15478 PG. B-19  
#230-002915

33.5121 ACRES  
#230-002916

**BETTY A. & RONALD V. SHEPPARD**  
26.3571 ACRES  
VOL. 31999 PG. F-11  
#230-002894

**ELLA M. BELT**  
132.368 ACRES  
INST. NO. 199711080138109  
#230-000508


2.0691 ACRES  
#230-000115

**STEVEN A. ZORUM**  
5.010 ACRES  
VOL. 19980086111904  
#230-000121

2.0374 ACRES  
#230-000175

**JAMES R. COTTRILL P.S.**  
5256 S.R. 207 NE MT STERLING, OHIO 43143 PH. (740) 869-3811

PLAT OF  
**142.3793± ACRES, VMS 931,6178,  
& 1019, PLEASANT TOWNSHIP,  
FRANKLIN COUNTY, OHIO.  
SURVEYED FOR ED SHEETS.**

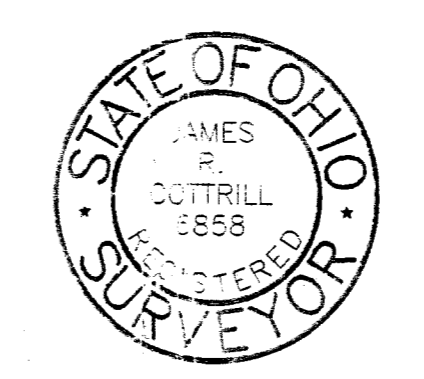

I HEREBY CERTIFY THAT THIS PLAT DEPICTS AN ACTUAL FIELD SURVEY PERFORMED BY JAMES R. COTTRILL P.S. #6858  
DATE: 4-4-00

DATE DRAWN: 2-22-00	SCALE: 1"=200' 200' 100' 0' 200'	CREW: MW, JB
JOB# S000204 F.B. # 24		OWN. BY: RC
		CK. BY: