

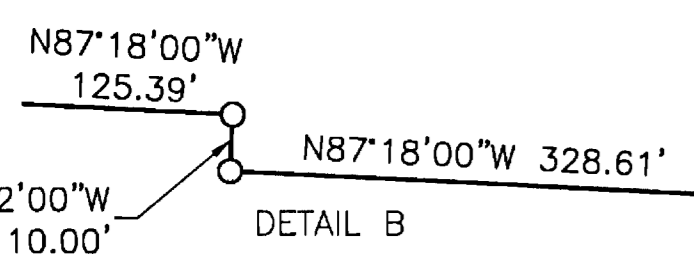
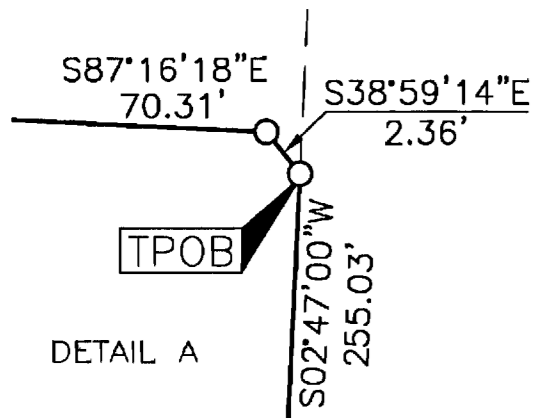


SURVEY OF ACREAGE PARCEL

VIRGINIA MILITARY SURVEY NO. 1434
TOWNSHIP OF JACKSON, CITY OF GROVE CITY, COUNTY OF FRANKLIN, STATE OF OHIO

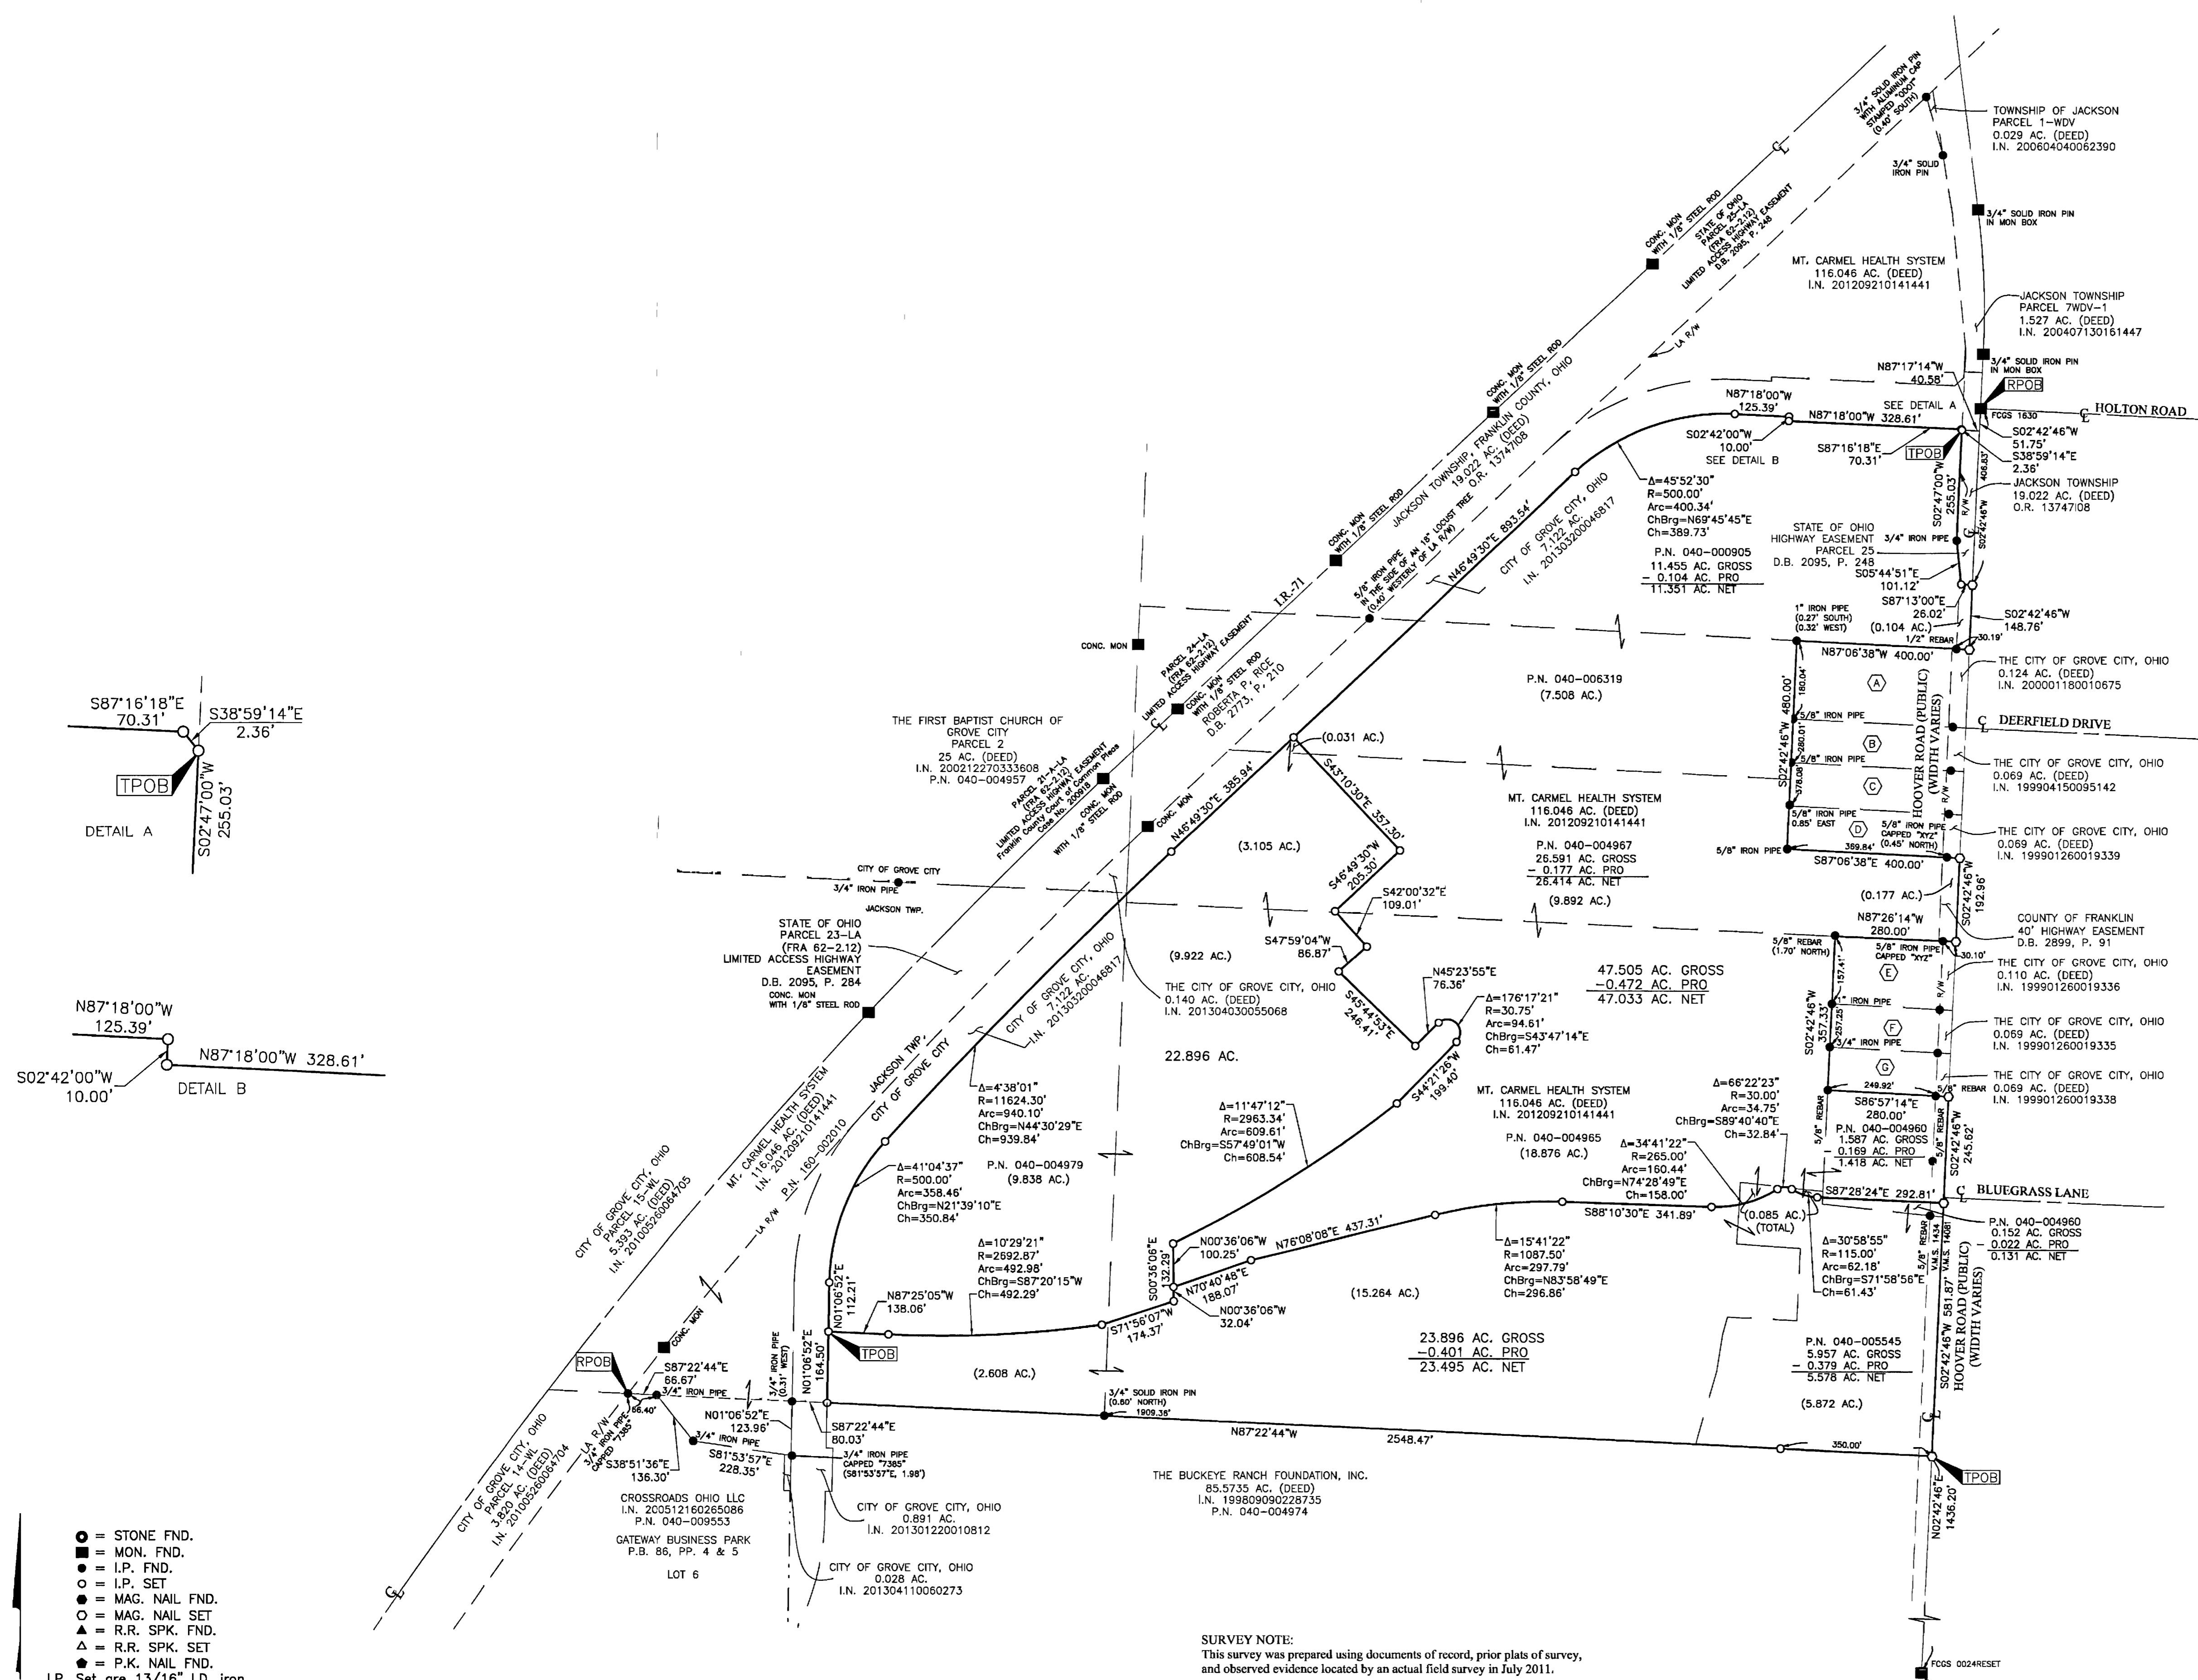

- = STONE FND.
 - = MON. FND.
 - = I.P. FND.
 - = I.P. SET
 - = MAG. NAIL FND.
 - = MAG. NAIL SET
 - ▲ = R.R. SPK. FND.
 - = R.R. SPK. SET
 - = P.K. NAIL FND.
- I.P. Set are 13/16" I.D. iron pipe with cap inscribed EMHT INC

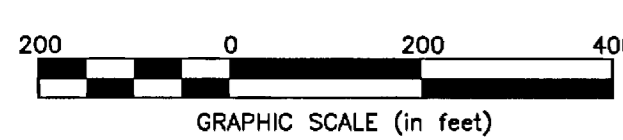


BASIS OF BEARINGS:
Bearings are based on the Ohio State Plane Coordinate System, South Zone, per NAD83 (1986 adjustment). Control for bearings was from coordinates of monuments FCGS 5548 and FCGS 5539, having a bearing of North 00 degrees 21 minutes 40 seconds East from the centerline of Hoover Road, established by the Franklin County Engineering Department.

SURVEY NOTE:
This survey was prepared using documents of record, prior plats of survey, and observed evidence located by an actual field survey in July 2011.

REFERENCE DOCUMENT USED:
-Deeds and Plats as shown hereon.
-Right-of-way plan set FRA-62-2.12, dated 1957, on file with ODOT.
-Roadway plan set for Borrows Corners and Stringtown Road, dated 1937, on file with Franklin County Engineer.

- (A) WILLIAM M. PLANK AND KIMBERLY D. PLANK
1.537 AC. (DEED)
I.N. 200310020316295
P.N. 040-004973
- (B) DONALD J. RIFE AND LINDA L. RIFE
ORIGINAL 0.918 AC. (DEED)
O.R. 15350A14
P.N. 040-005227
- (C) THE RICE FAMILY LIVING TRUST
MARY P. RICE, TRUSTEE
0.918 AC. (DEED)
I.N. 201007260094467
I.N. 199909240241709
P.N. 040-005221
- (D) WALLACE D. LEWELLYN AND ELIZABETH S. LEWELLYN
0.918 AC. (DEED)
D.B. 3612, P. 226
P.N. 040-005213
- (E) SHIRLEY A. ARICK, TRUSTEE OF THE SHIRLEY A. ARICK REVOCABLE TRUST DATED AUGUST 8TH, 2007
0.908 AC. (DEED)
I.N. 200810080150626
P.N. 040-005220
- (F) JOHN A. TILLEY, III AND AMY M. TILLEY
0.574 AC. (DEED)
I.N. 201009280126795
P.N. 040-005229
- (G) VINSON P. LEWIS AND DAWN M. LEWIS
ORIGINAL 0.643 AC. (DEED)
O.R. 9751H10
P.N. 040-005230

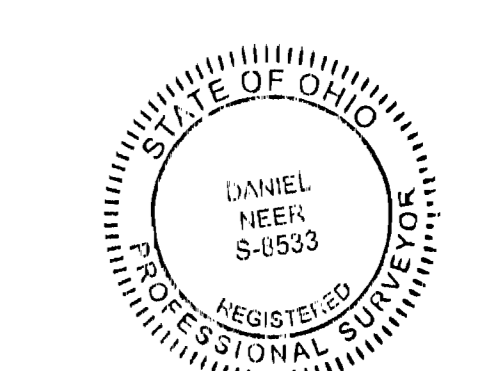

By DAN Neer 6/13/13
Daniel A. Neer Date
Professional Surveyor No. 8533

EMHT		Date: April 22, 2013															
Evans, Mechwart, Hambleton & Tilton, Inc. Engineers • Surveyors • Planners • Scientists 5500 New Albany Road, Columbus, OH 43244 Phone: 614.775.4500 Toll Free: 888.775.3448 emht.com		Scale: 1" = 200'															
Job No: 2013-0559		Sheet: 1 of 1															
<table border="1"> <thead> <tr> <th colspan="3">REVISIONS</th> </tr> <tr> <th>MARK</th> <th>DATE</th> <th>DESCRIPTION</th> </tr> </thead> <tbody> <tr> <td> </td> <td> </td> <td> </td> </tr> <tr> <td> </td> <td> </td> <td> </td> </tr> <tr> <td> </td> <td> </td> <td> </td> </tr> </tbody> </table>			REVISIONS			MARK	DATE	DESCRIPTION									
REVISIONS																	
MARK	DATE	DESCRIPTION															

RECEIVED
JUN 14 2013
Franklin County Engineer
Dean C. Ringle, P.E., P.S.