F-8-E

EMH&T
Evans, Mechwart, Hambleton & Tilton, Inc.
Engineers • Surveyors • Planners • Scientists
5500 New Albany Road, Columbus, OH 43054
Phone: 614.775.4500 Toll Free: 888.775.3648
emht.com

SURVEY OF ACREAGE PARCEL

HALF SECTION 7, TOWNSHIP 5, RANGE 22
REFUGEE LANDS
CITY OF GRANDVIEW HEIGHTS, COUNTY OF FRANKLIN, STATE OF OHIO

Date: May 2, 2013	Job No. 2013-0661	Scale: 1" = 100'

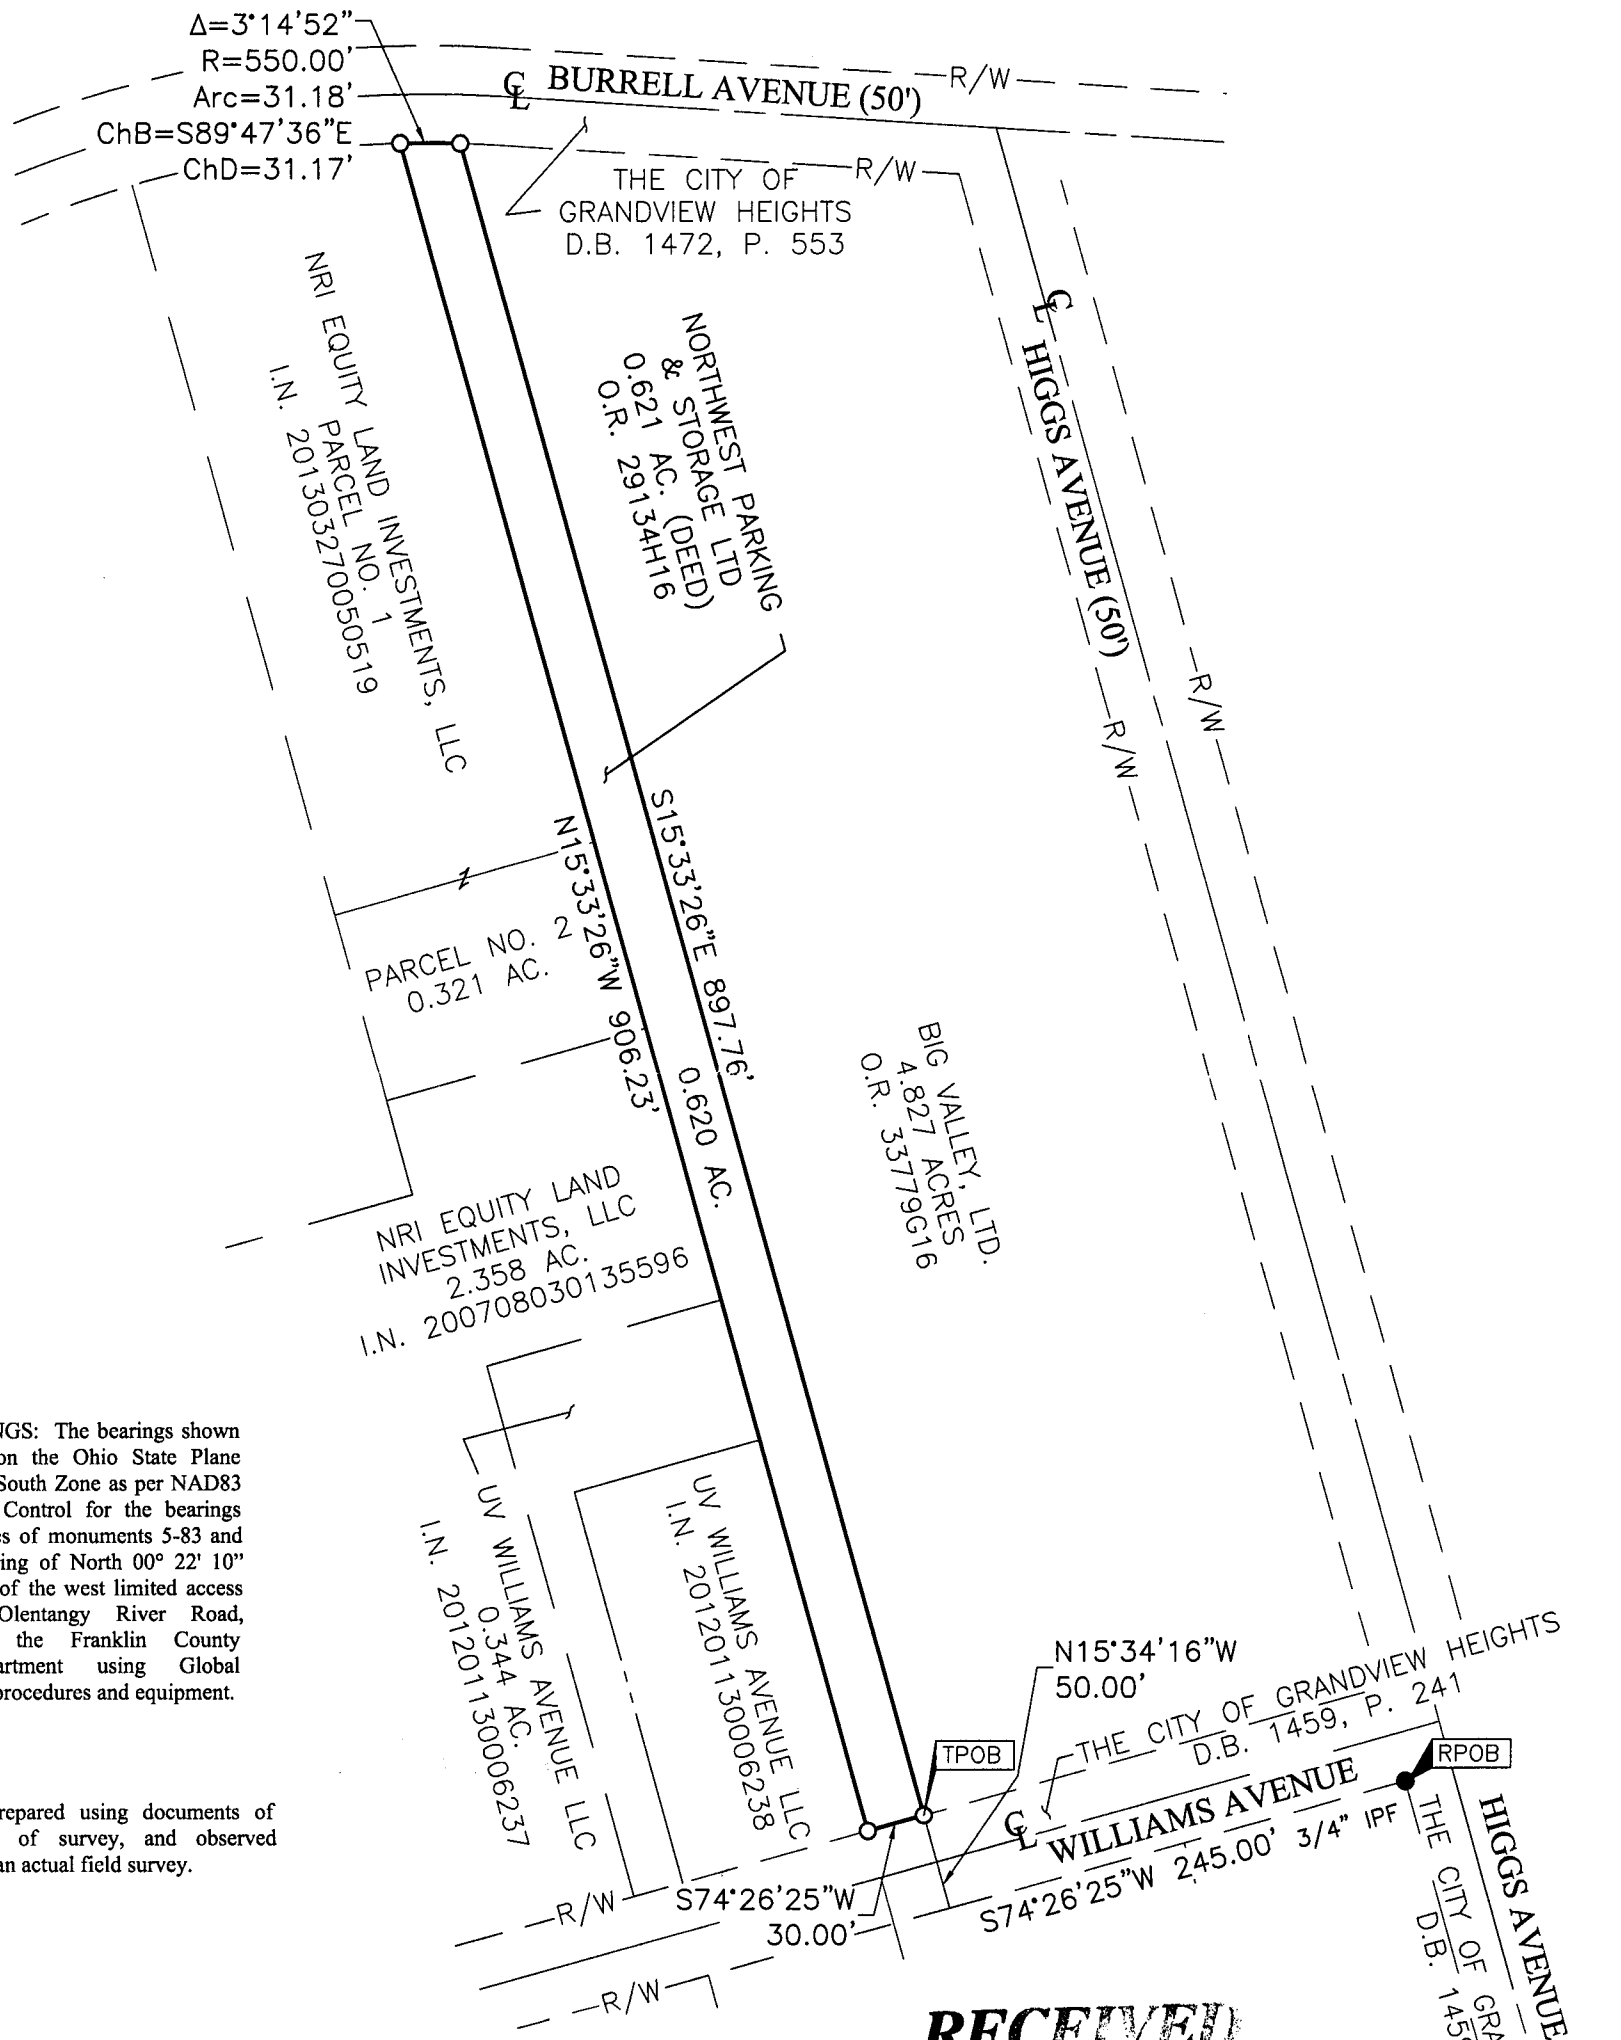

BASIS OF BEARINGS: The bearings shown hereon are based on the Ohio State Plane Coordinate System South Zone as per NAD83 (1986 adjustment). Control for the bearings was from coordinates of monuments 5-83 and 4-83, having a bearing of North 00° 22' 10" West, for a portion of the west limited access right-of-way of Olentangy River Road, established by the Franklin County Engineering Department using Global Positioning System procedures and equipment.

SURVEY NOTE:
This survey was prepared using documents of record, prior plats of survey, and observed evidence located by an actual field survey.

● = STONE FND.
■ = MON. FND.
● = I.P. FND.
○ = I.P. SET
⬢ = MAG. NAIL FND.
⬡ = MAG. NAIL SET
▲ = R.R. SPK. FND.
△ = R.R. SPK. SET
⬟ = P.K. NAIL FND.
I.P. Set are 13/16" I.D. iron pipe with cap inscribed EMHT INC

100 0 100 200
GRAPHIC SCALE (in feet)

RECEIVED
MAY 30 2013
Franklin County Engineer
Dean C. Ringle, P.E., P.S.

STATE OF OHIO
EDWARD J. MILLER 8250
REGISTERED PROFESSIONAL SURVEYOR

By _____ Date
Edward J. Miller
Professional Surveyor No. 8250

J:\20130661\DWG\04SHEETS\BOUNDARY\20130661-VS-BNDY-04.DWG plotted by NEER, DANIEL on 5/8/2013 4:35:44 PM last saved by DNEER on 5/8/2013 11:45:06 AM
Xrefs: