BOUNDARY SURVEY

LOT 145 ~ CHASELAND MANOR

P.B. 22, PG. 50

COLUMBUS, FRANKLIN CO., OHIO

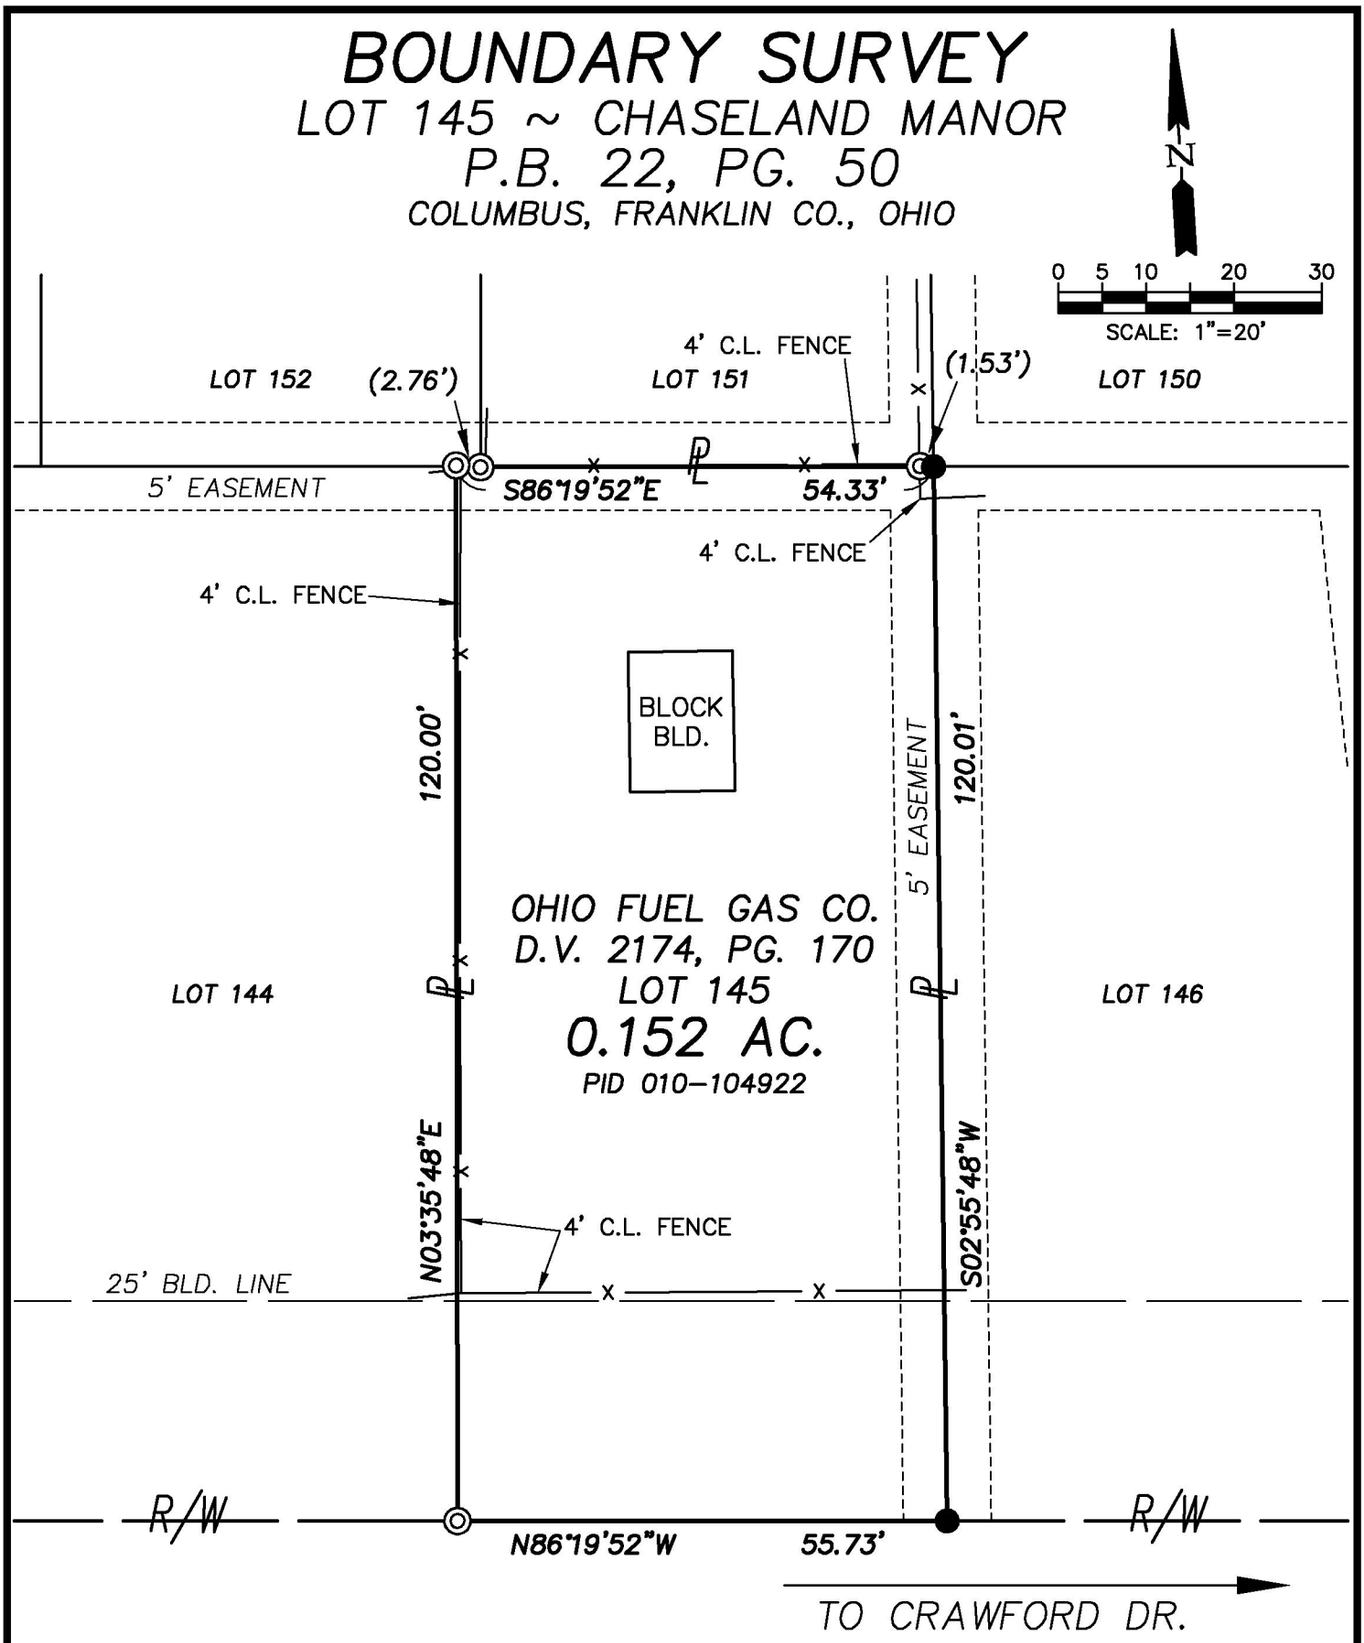

SWEETING AVE. (50')

SURVEY NOTES

Bearings hereon are referenced to SPCS Grid, OH S. Zone per a VRS GPS Survey.

Lot Nos. referenced to Chaseland Manor, of record in P.B. 22, Pg. 50.

LEGEND

◎ IRON PIPE FOUND

● IRON PIN SET (5/8"O.D. REBAR, 30"LONG W/ I.D. CAP STAMPED "LOMANO 7711")

Address of subject property is 876 Sweeting Ave., Columbus, OH 43229. PID No. is 010-104922.

This plat is based on the results of an actual field survey performed on the property under my supervision in September, 2013.

STATE OF OHIO
MICHAEL P. LOMANO 7711
REGISTERED PROFESSIONAL SURVEYOR

WESTERVILLE LAND SURVEYING, LLC

90 E. COLLEGE AVE.
WESTERVILLE, OH 43081
(614) 899-2209

DRAWING NAME: 13215BS.DWG

DATE: 9/04/13 REVISED:
JOB No.: 13-215 F.B./PG.: 2/RJY
CLIENT: COLUMBIA GAS OF OHIO
CLIENT P.O.: 13-1584181-00

BY Michael P. Lomano
OHIO PROFESSIONAL SURVEYOR No. 7711