G-4-C.

Myers Surveying Company, Inc.

2740 East Main Street, Columbus 43209 (Bexley), Ohio
614-235-8677 FAX:614-235-4559

A Boundary Survey prepared for and certified to:

Laura Cooper Trustee

Legal Description: Situated in The State of Ohio, County of Franklin, City of Columbus Being Part of Lot 112 Eureka Park Amended #2, Plat Book 27, Page 76

Posted Address: 2572 Symington Avenue, Columbus, Ohio

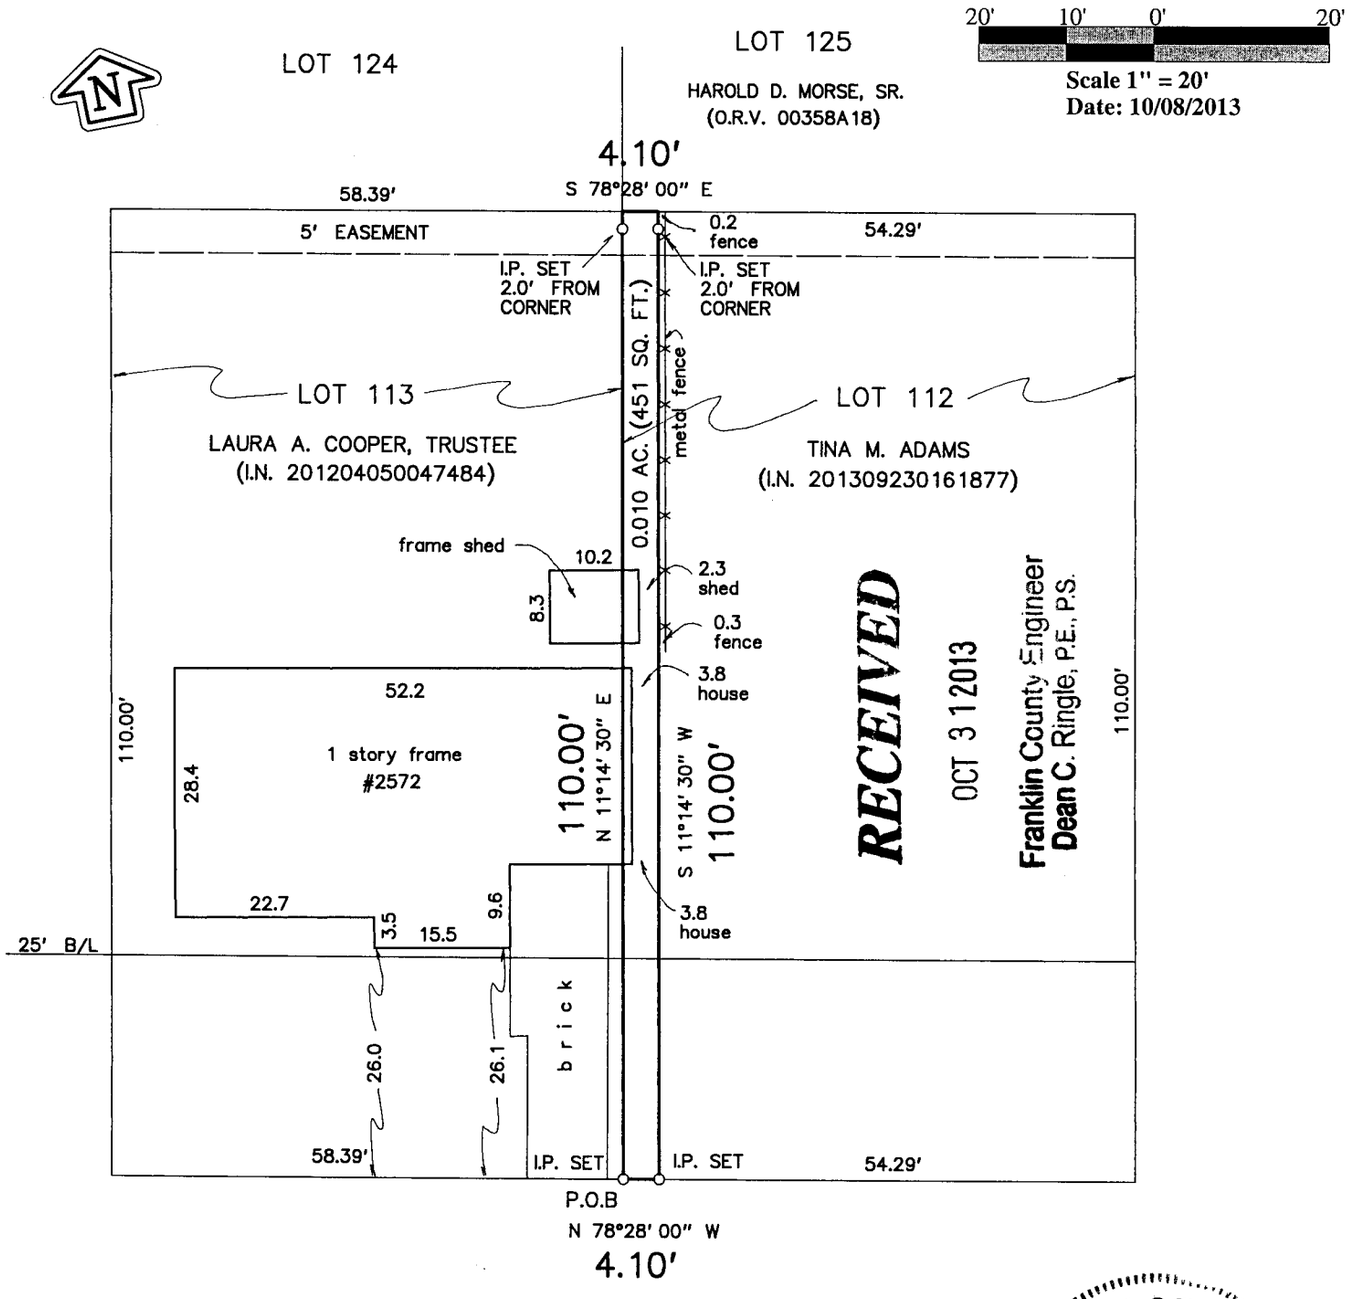

RECEIVED
OCT 31 2013
Franklin County Engineer
Dean C. Ringle, P.E., P.S.

STATE OF OHIO
ALBERT J. MYERS 6579
REGISTERED PROFESSIONAL SURVEYOR

We hereby certify that the foregoing Boundary Survey was prepared from actual field measurements in accordance with Chapter 4733-37 Ohio Administrative Code. Iron pipes set are 30"x1" O.D. with an orange plastic plug inscribed "P.S. 6579", unless otherwise noted. Basis of bearings is the centerline of Symington Avenue held as North 78° 28' 00" West per Plat Book 27, Page 76.

Myers Surveying Co., Inc.

By _____ 10/30/13

Professional Surveyor

Myers Order No. - 4-08/15/2013	Rec.	Field	DWG	Ltr.	Ck.
201308154	CA	RON	D50	D50	