
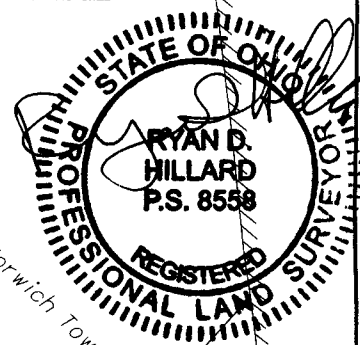


B-2-B

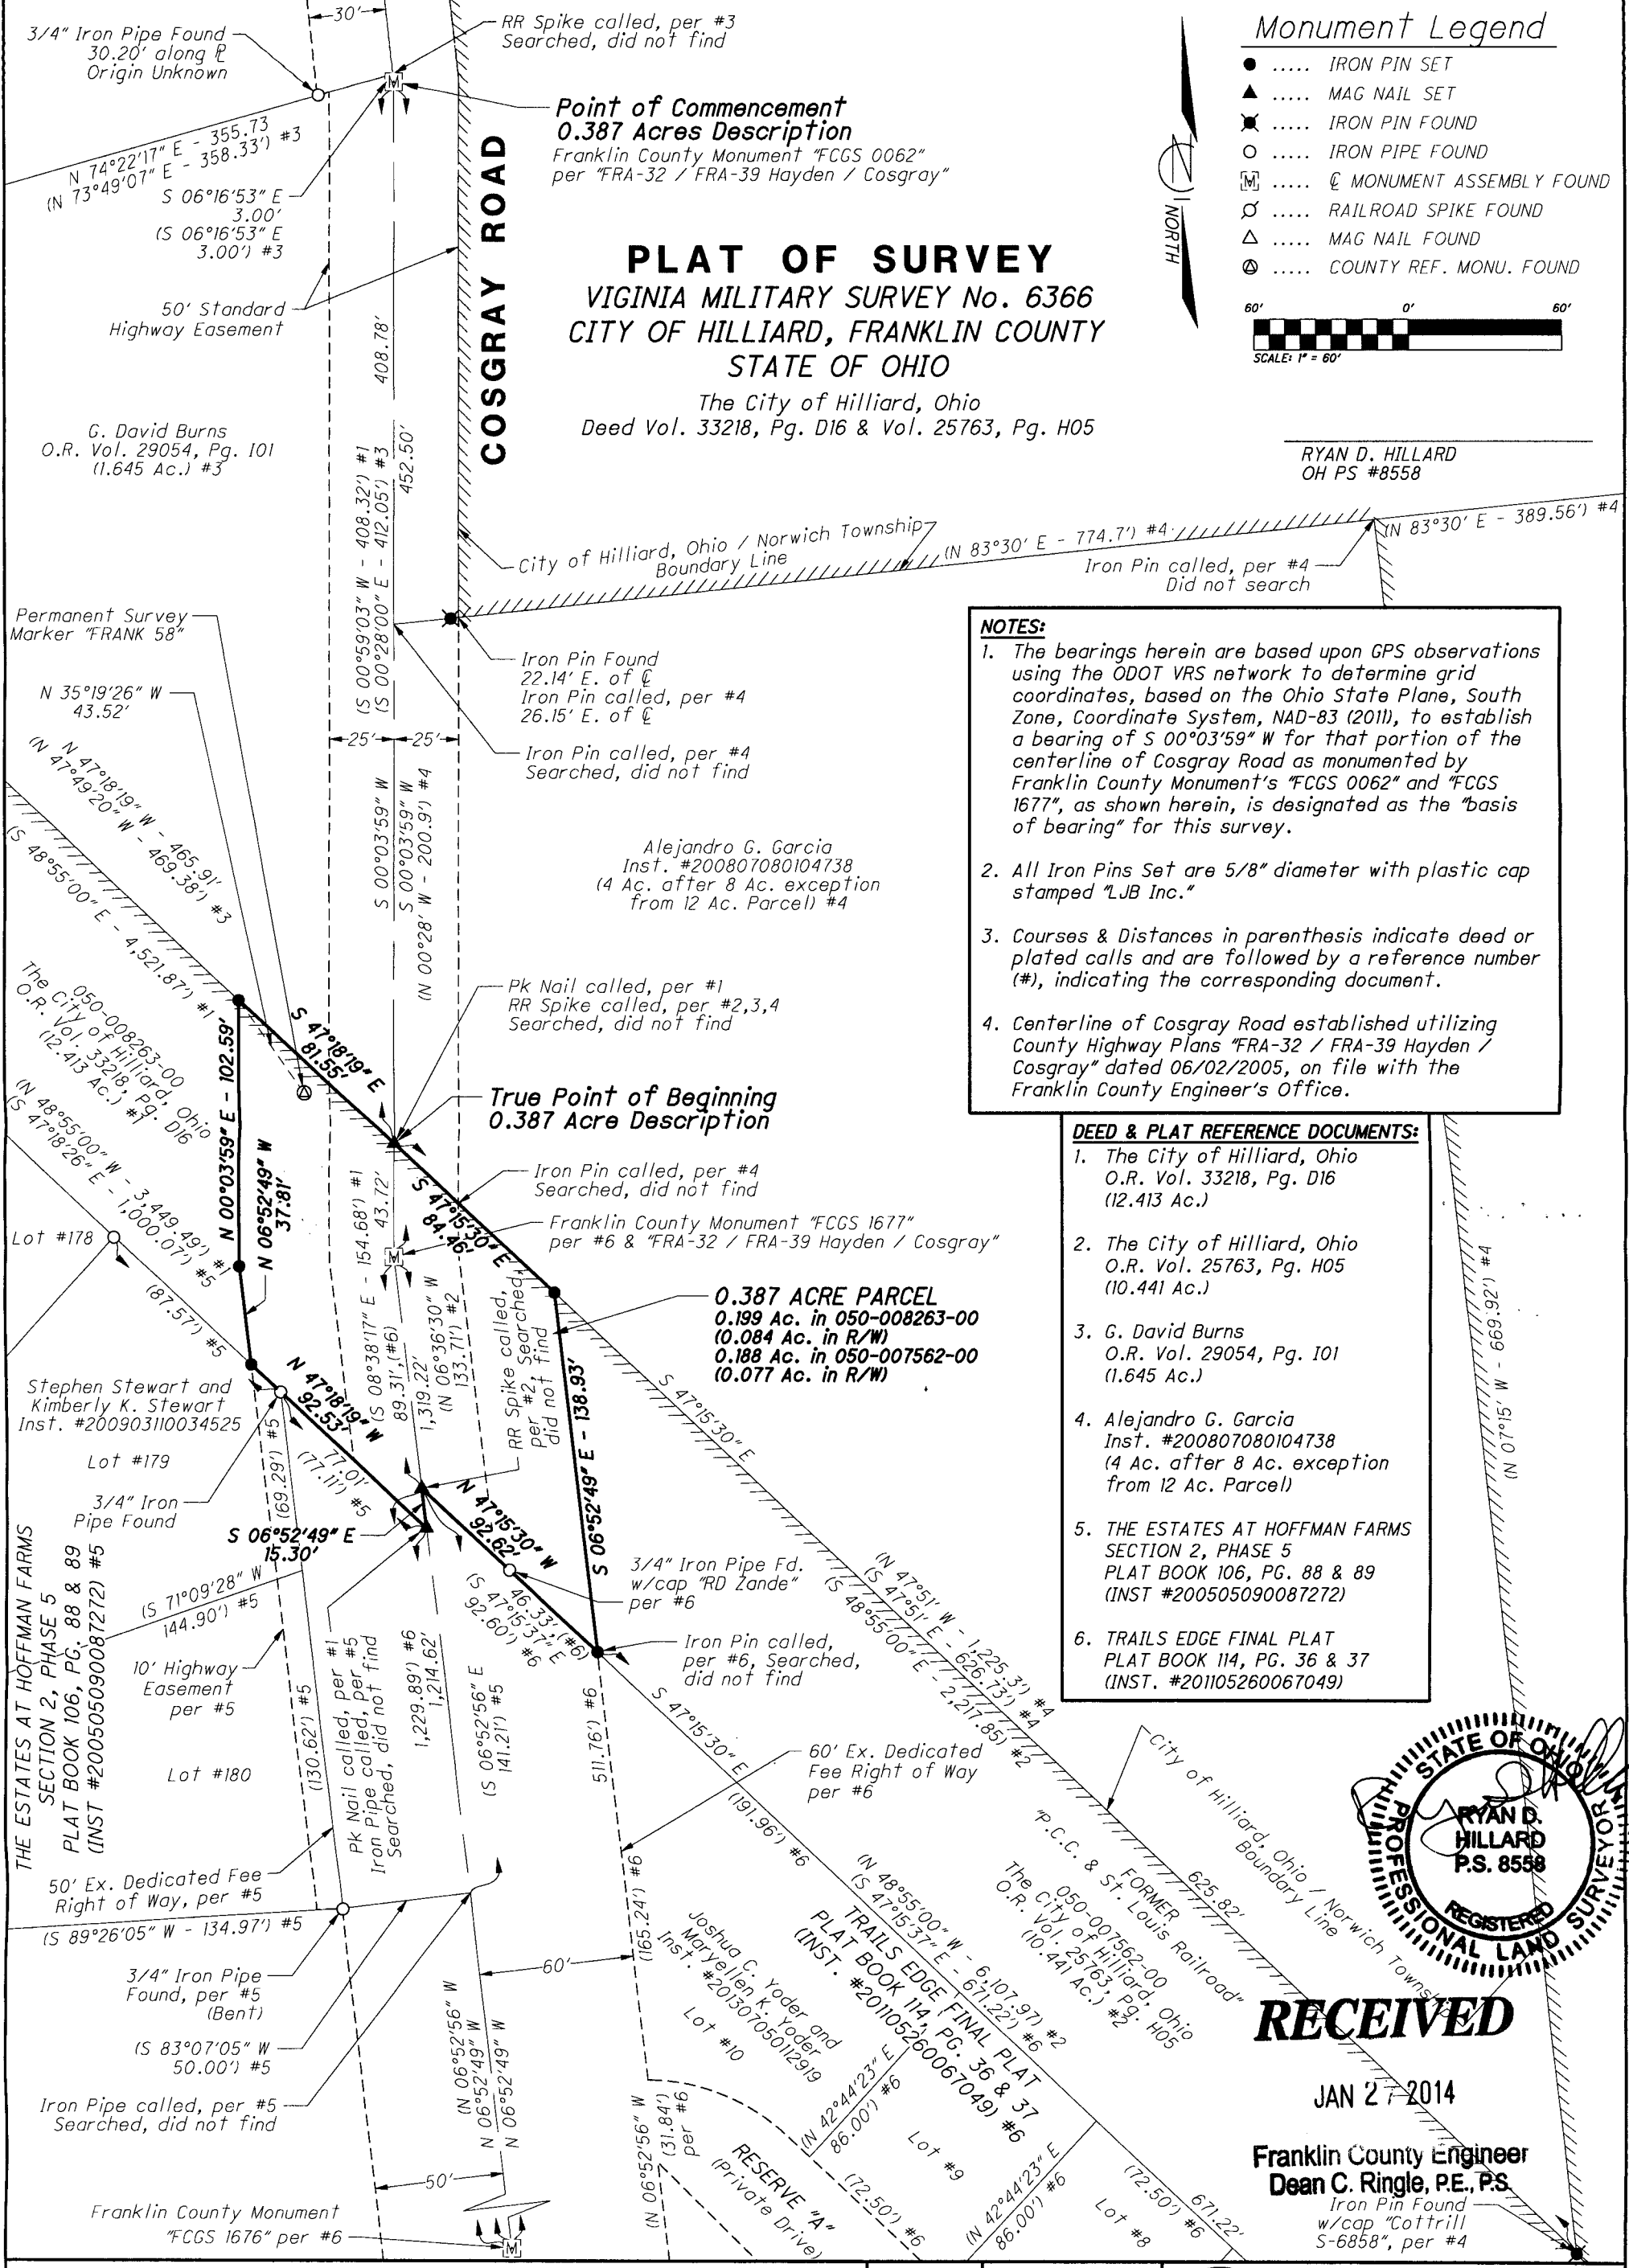

RECEIVED

JAN 27 2014

Franklin County Engineer
 Dean C. Ringle, P.E., P.S.

PROJECT: The Heritage Trail / Cosgray Road RRFB Safety Study	DSGN: JAC	JOB#: 0108121A.00	<p>LJB Inc. • 2500 Newmark Drive Miamisburg, OH 45342 (937) 259-5000 tel • (937) 259-5100 fax LJBinc.com</p>
SUBJECT: Dedication of 0.387 Acres along Cosgray Road, for Right of Way purposes	DRWN: JAC	DATE: 01/08/14	
SHEET NO: 1 / 1	CHKD: RDH	SCALE: 1" = 60'	

© 1985-2013 LJB Inc. This drawing contains information that is proprietary to and property of LJB Inc. and shall be kept confidential. No publication or distribution of this drawing may be made without the express written consent of LJB Inc. except for the limited purposes set forth in the contract between LJB Inc. and party for whom this drawing was made.