RECEIVED
JAN 16 2014
Franklin County Engineer
Dean C. Ringle, P.E., P.S.

BOUNDARY SURVEY FIVE LOTS

IN SECTION-1, TOWNSHIP-10, RANGE-21.
VILLAGE OF LITHOPOLIS, FRANKLIN COUNTY,
STATE OF OHIO
FOR
WILLIAM S. GRIFFITH & LORA E. GRIFFITH

PRIOR DEED REFERENCE	
LORI E. GRIFFITH	37.875 %
WILLIAM S. GRIFFITH	62.120 %
# 200311040352429	
# 200705250091909	
# 201308050132547	

MONUMENTATION LEGEND
SP 3/4" IRON PIPE SET
FP 3/4" IRON PIPE FOUND
FR 5/8" REBAR FOUND
FA IRON AUTO AXLE FOUND
RF RAILROAD SPIKE FOUND
RS RAILROAD SPIKE SET
NF P-K NAIL FOUND
NS P-K NAIL SET
FCE FRANKLIN COUNTY ENGINEER'S MON MONUMENT ASSEMBLY

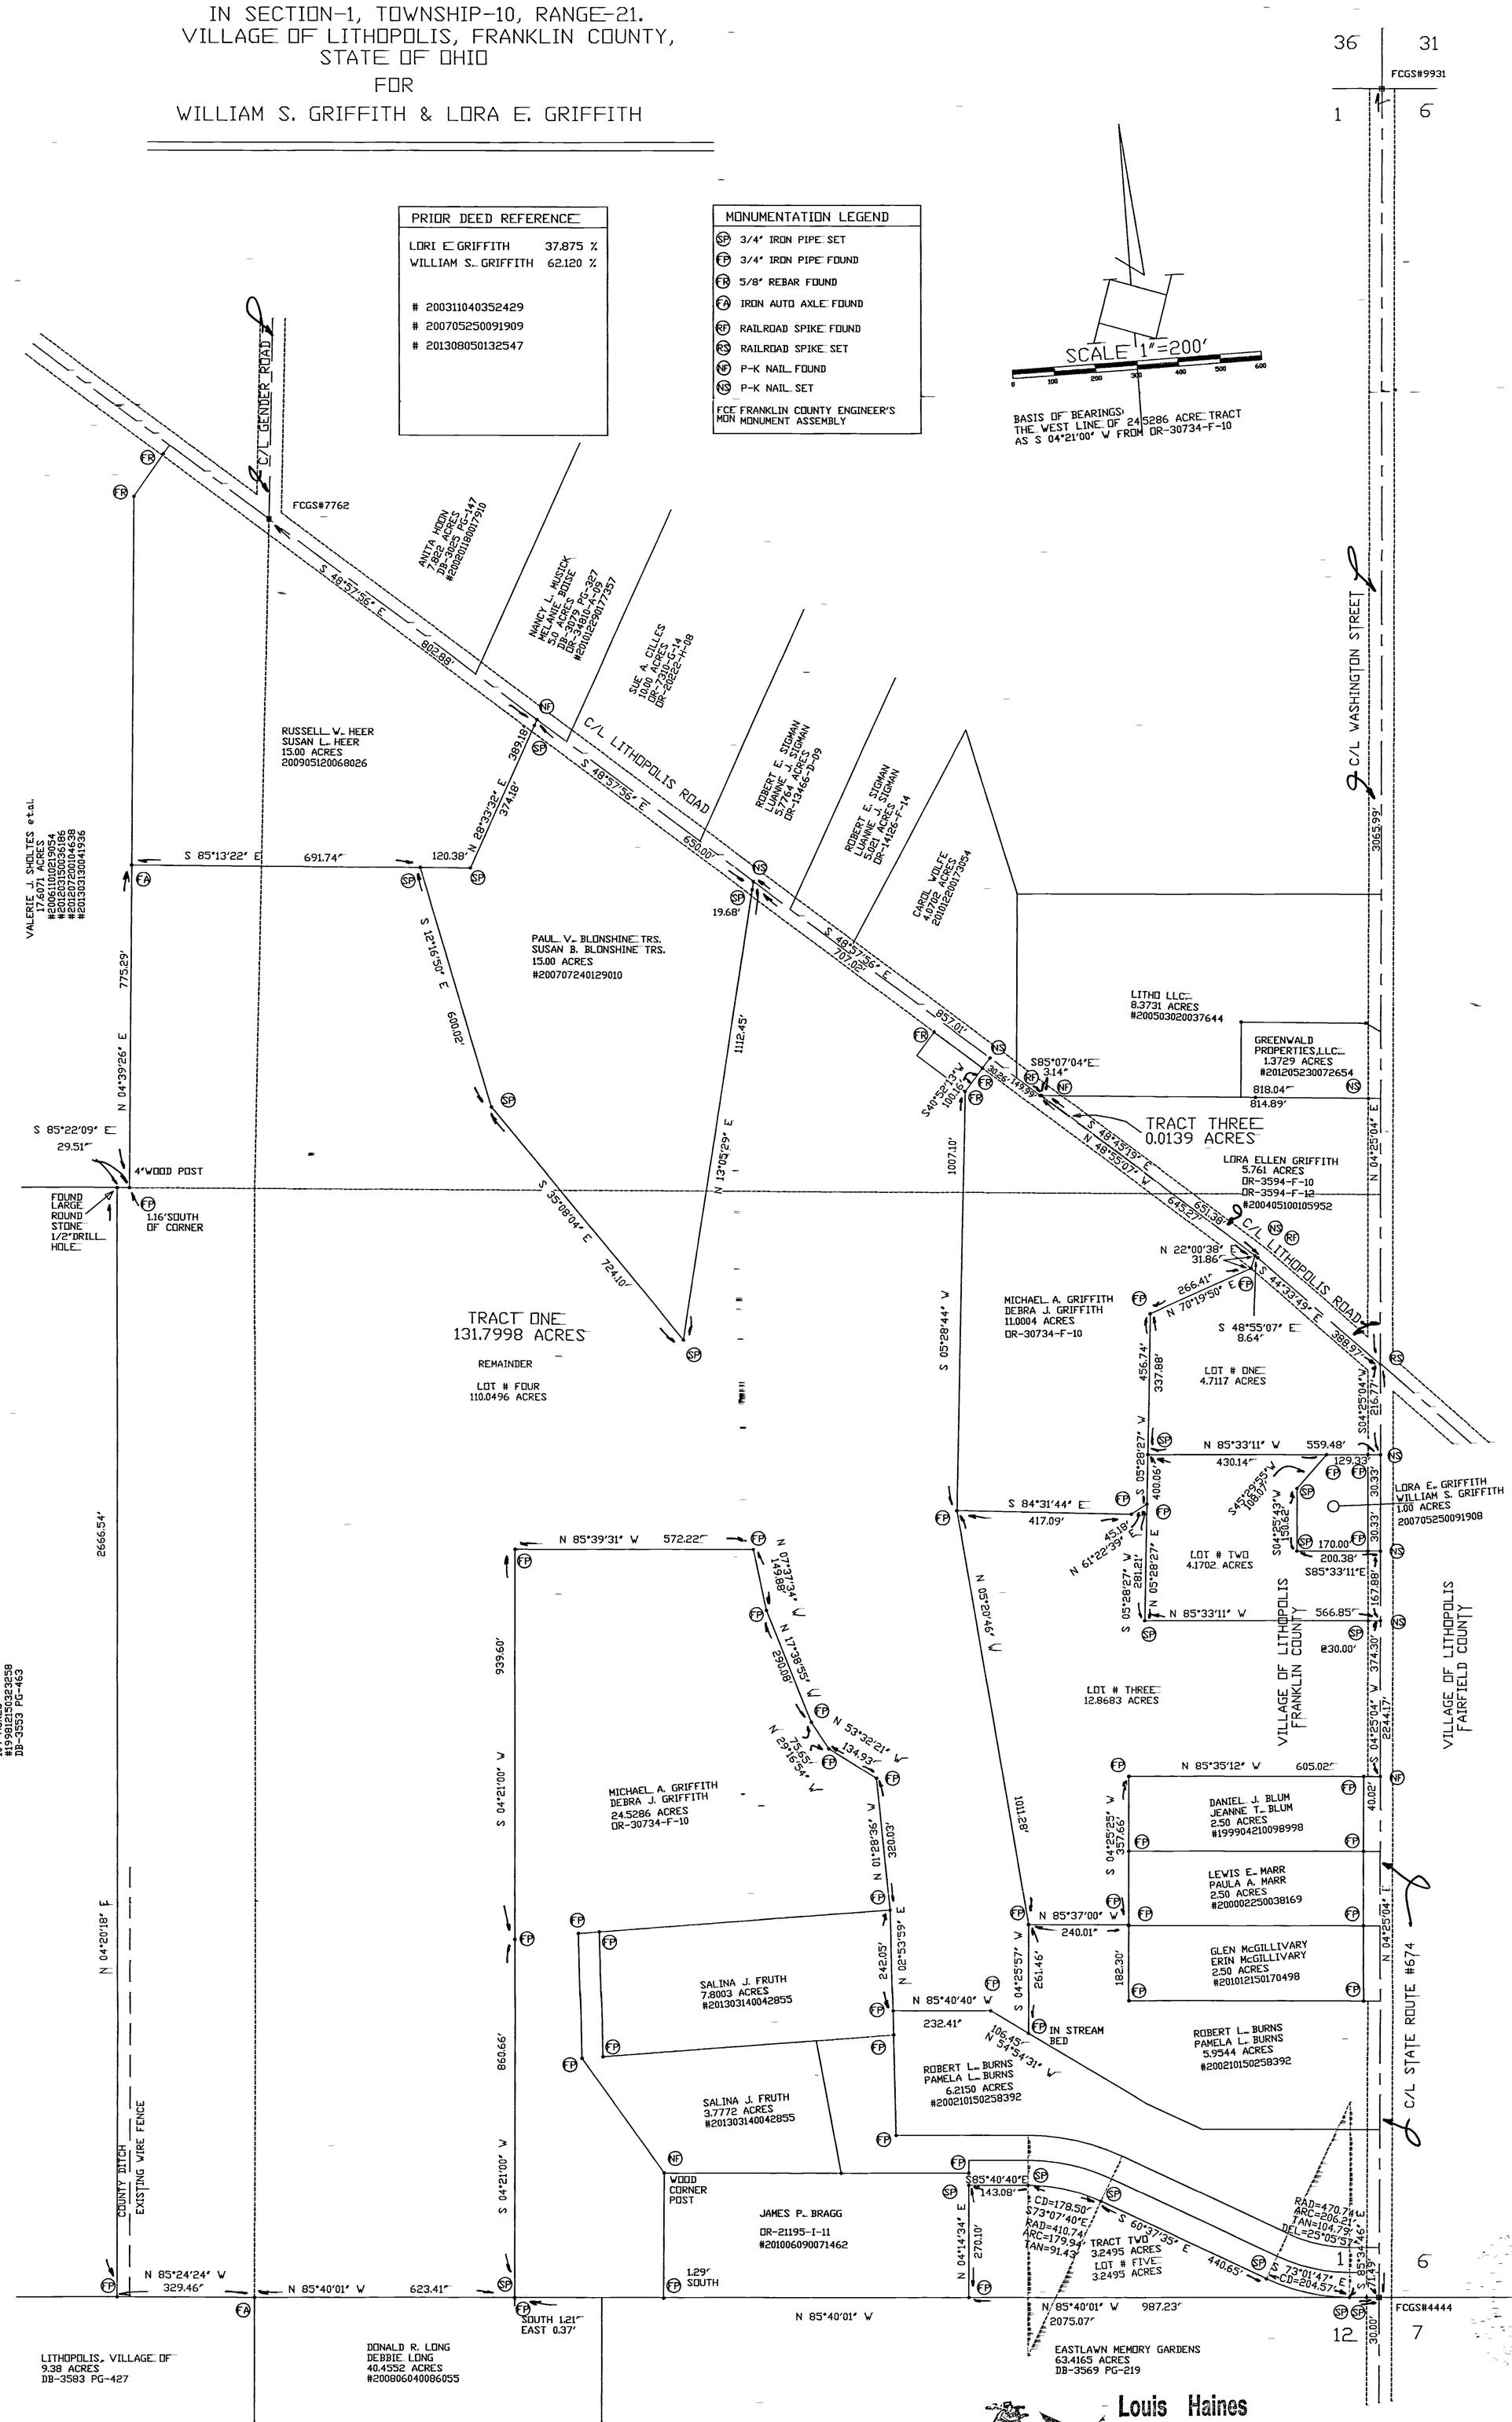

Louis Haines
354 Kessler Street
Groveport, Ohio 43125
Phone 837-2181

I HEREBY CERTIFY THE PLAT SHOWN HEREON IS CORRECT AS SURVEYED BY US.
DATE: December 31-2013
SIGNED:

All 3/4" iron pipes set are 3/4" galvanized iron pipe cut to 30" lentghs with an orange plastic id cap inscribed " Haines Surv."