

K-1-D



Evans, Mechwart, Hambleton & Tilton, Inc.
Engineers • Surveyors • Planners • Scientists
5500 New Albany Road, Columbus, OH 43054
Phone: 614.775.4500 Toll Free: 888.775.3648
emht.com

SURVEY OF ACREAGE PARCEL

VIRGINIA MILITARY SURVEY 1383

TOWNSHIP OF JACKSON, COUNTY OF FRANKLIN, STATE OF OHIO

Date: June 27, 2014

Scale: 1" = 50'


Job No. 2013-1291

BASIS OF BEARINGS:

The bearings shown on this survey are based on the Ohio State Plane Coordinate System, South Zone, NAD83 (1986). Said bearings originated from a field traverse which was referenced to said coordinate system by GPS observations and observations of selected Franklin County Engineering Department monuments FCGS 5539, FCGS 5548, FCGS 0024, JACKSON, and JACKSON AZIMUTH. The portion of the centerline of Orders Road having a bearing of North 86° 59' 34" West is designated the "basis of bearing" for this survey.

SURVEY NOTE:


This survey was prepared using documents of record, prior plats of survey, and observed evidence located by an actual field survey from September, 2013.

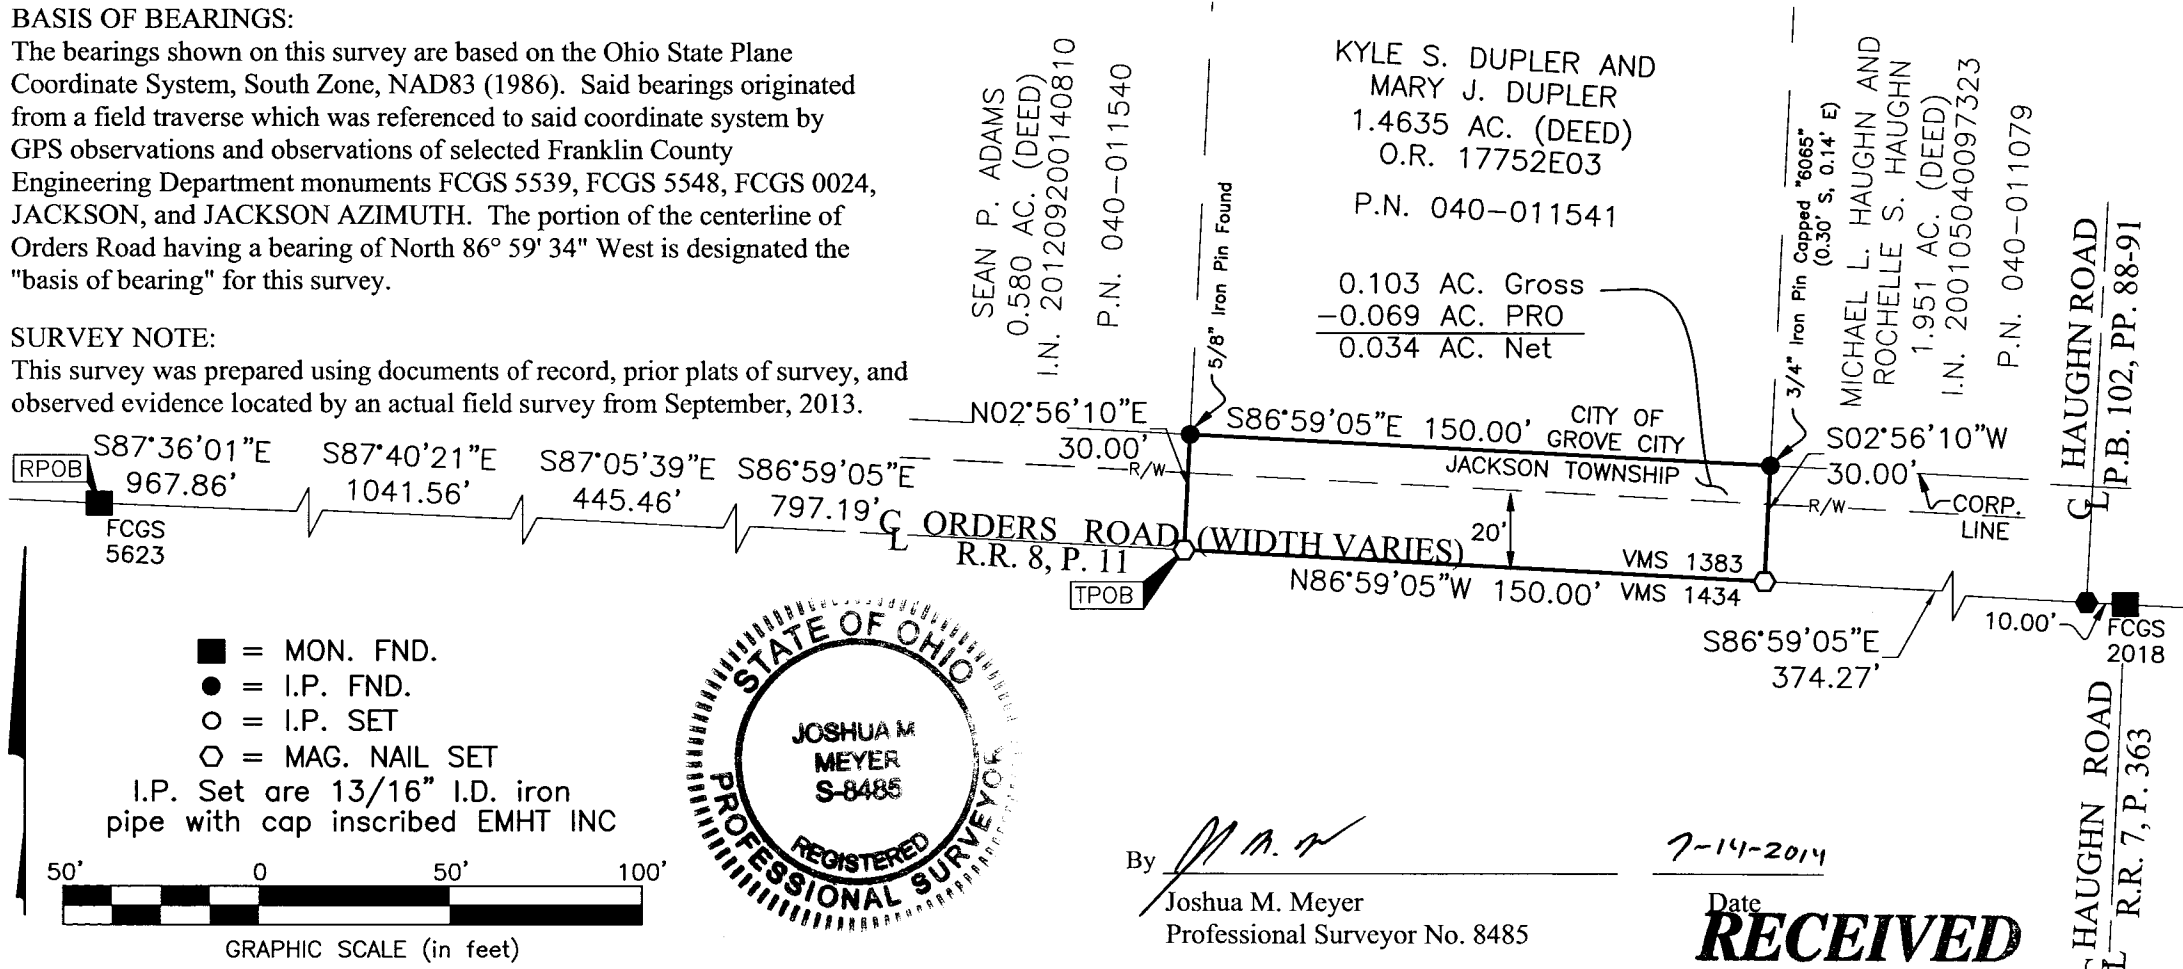


- = MON. FND.
 - = I.P. FND.
 - = I.P. SET
 - = MAG. NAIL SET
- I.P. Set are 13/16" I.D. iron pipe with cap inscribed EMHT INC



GRAPHIC SCALE (in feet)

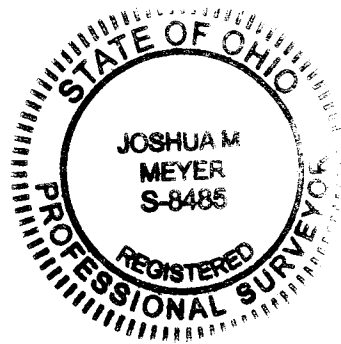

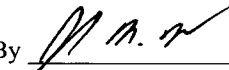By 
 Joshua M. Meyer
 Professional Surveyor No. 8485

7-14-2014

Date
RECEIVED

HAUGHN ROAD
 P.B. 102, PP. 88-91
 HAUGHN ROAD
 R.R. 7, P. 363

J:\20131291\DWG\04SHEETS\BOUNDARY\ORDERS ROAD PROPOSED ROW\20131291-VS-BNDY-13.DWG plotted by GEIGER, STEVEN on 6/27/2014 3:30:38 PM last saved by SGEIGER on 6/27/2014 3:30:33 PM
 Xrefs:

JUL 15 2014

Franklin County Engineer
 Dean C. Ringle, P.E., P.S.