G-2-B

EMH&T
Evans, Mechwart, Hambleton & Tilton, Inc.
Engineers • Surveyors • Planners • Scientists
5500 New Albany Road, Columbus, OH 43054
Phone: 614.775.4500 Toll Free: 888.775.3648
emht.com

SURVEY OF ACREAGE PARCEL

SECTION 8, TOWNSHIP 5, RANGE 22
REFUGEE LANDS
CITY OF COLUMBUS, COUNTY OF FRANKLIN, STATE OF OHIO

Date:	September 29, 2014
Scale:	1" = 30'
Job No:	2012-1665

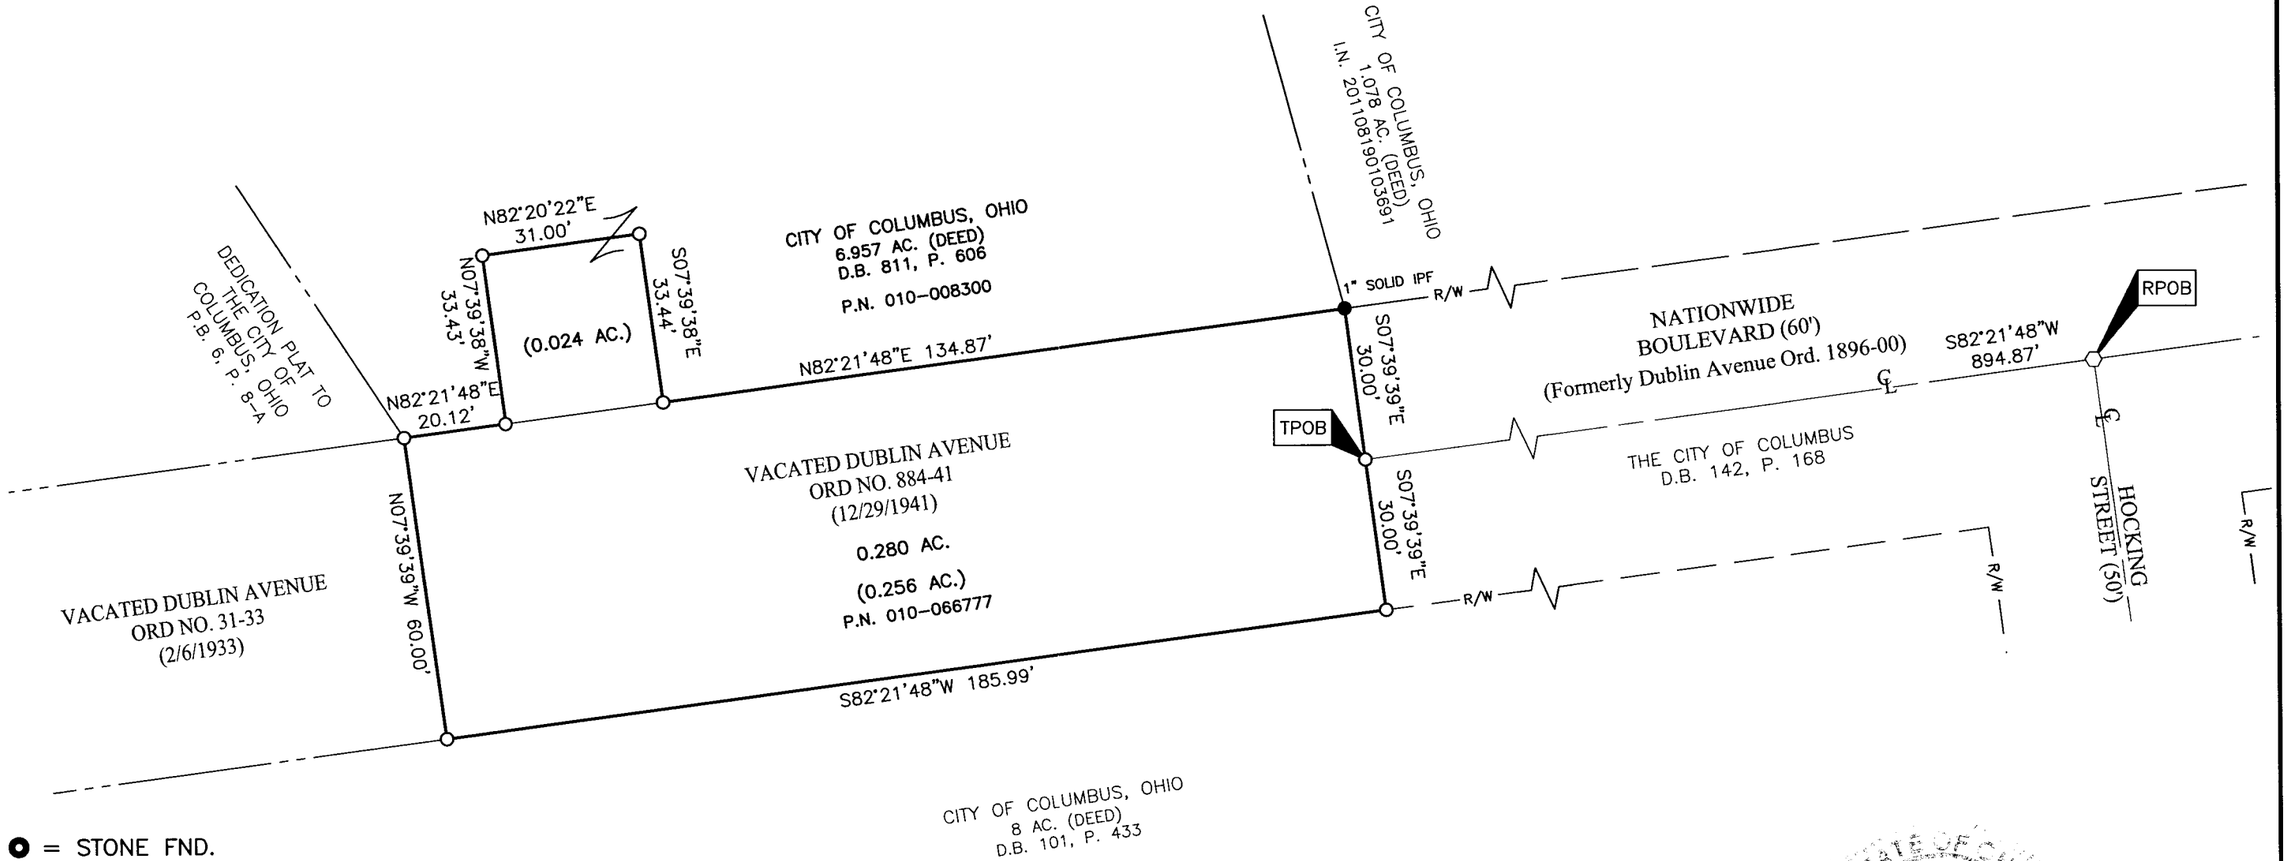

● = STONE FND.
■ = MON. FND.
● = I.P. FND.
○ = I.P. SET
⬢ = MAG. NAIL FND.
⬡ = MAG. NAIL SET
▲ = R.R. SPK. FND.
△ = R.R. SPK. SET
⬟ = P.K. NAIL FND.
I.P. Set are 13/16" I.D. iron pipe with cap inscribed EMHT INC

30 0 30 60
GRAPHIC SCALE (in feet)

SURVEY NOTE:
This survey was prepared using documents of record, prior plats of survey, and observed evidence located by an actual field survey.

BASIS OF BEARINGS:
Bearings are based on the north right of way line of Nationwide Boulevard, having a bearing of North 82°18' 16" East, as per Ohio State Plane Coordinate System, South Zone NAD83 (1986 Adjustment).

RECEIVED
SEP 30 2014
Franklin County Engineer
Dean C. Ringle, P.E., P.S.

STATE OF OHIO
JOSHUA M. MEYER
8485
REGISTERED
PROFESSIONAL SURVEYOR

By _____ 9-29-2014
Joshua M. Meyer
Professional Surveyor No. 8485
Date

J:\20121665\DWG\04SHEETS\BOUNDARY\20121665-VS-BNDY-RWAY-05.DWG plotted by KING, BRANDON on 9/29/2014 11:22:29 AM last saved by BKING on 9/29/2014 11:21:49 AM
Xrefs: