

TERRY & Lois Tomilson  
111.84 AC. OR-6626-6-10

ERNEST A. Villiers  
94.60 AC.  
DB-2153 Pg 142

Virgil Harrison 259.08 AC  
DB-1688 Pg. 237

589° 56' 12" E ~ 532.89'

589° 58' 40" E

656.61'

Stone Fd.  
NW cor.  
SW 1/4  
SEC #1

3/4" IP  
SET


11.50 ACRES  
THIS SURVEY

Section #2

Section #1

GEORGE W. Klamfoth et al.  
21.537 AC. ORIG.  
- 11.500 AC. EXCEPT  
10.037 AC REMAINDER  
OR-11550-F-10

Prior Deed REF.  
3923-B-14  
11550-F-10  
11550-F-13

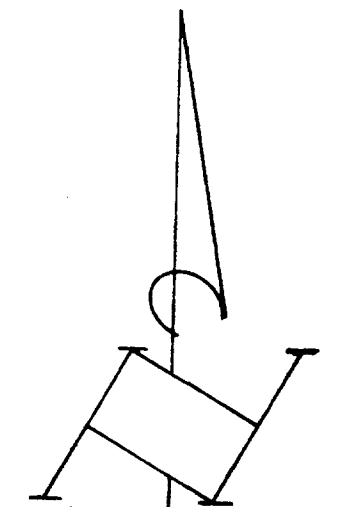

SCALE 1"=100'

Basis of BEARINGS:  
West line SEC. #1  
AS- N00°00'00"E  
FROM OR-11550-F-13

Road 7  
E Oregon

N00°00'37"E ~ 634.59'

N00°00'00"E ~ 656.74'

500° 00' 37" W

533.50' 7.90 ac.

3.60 ac.  
239.13'

3/4" IP  
SET

229.31'

N57° 33' 24" W

1/2" IP  
FD

Donald L & Betty Klamfoth OR-11693-A-01  
James L. & Joyce A. Klamfoth OR-19019-6-10  
28.364 AC.

N00°00'00"E  
2006.74'

Conc. Mon.  
SW cor.  
SW 1/4  
SEC. #1

Now FCGS 9970

SURVEY OF 11.50 ACRES  
in the SW 1/4, SEC. #1 & SE 1/4 SEC. #2,  
Twp. 10, Rge 21, Madison Twp.,  
Franklin Co., Ohio; FOR

JAMES KLAMFOTH



HAINES SURVEYORS  
354 Kessler Street  
Groveport, Ohio 43125  
Phone: 837-2181



I hereby certify that the plat shown hereon was prepared from an actual field survey, under my supervision and that said plat correctly represents said survey.  
DATE 9-7-96 SIGNED *Louis J. Haines*