

Myers Surveying Company, Inc.

2740 East Main Street, Columbus 43209 (Bexley), Ohio

614-235-8677

FAX: 614-235-4559

6-2-C

A Boundary Survey prepared for and certified to:

Robbins Realty

Legal Description: Situated in The State of Ohio, County of Franklin, City of Columbus Being Part of Lot 19 Ltham's Addition, Plat Book 1, page 123

Posted Address: Private Alley @ N 5th/Spring/Lafayette, Columbus, Ohio



Scale 1" = 20'


Date: 10/22/2014




E. SPRING STREET 60'

* Ingress & Egress over 10' Private Alley granted to Albert Baker, May 15, 1869 in D.B. 98, Pg. 250.

NOV 12 2014 N. FIFTH STREET 60' (Formerly LATHAM STREET)

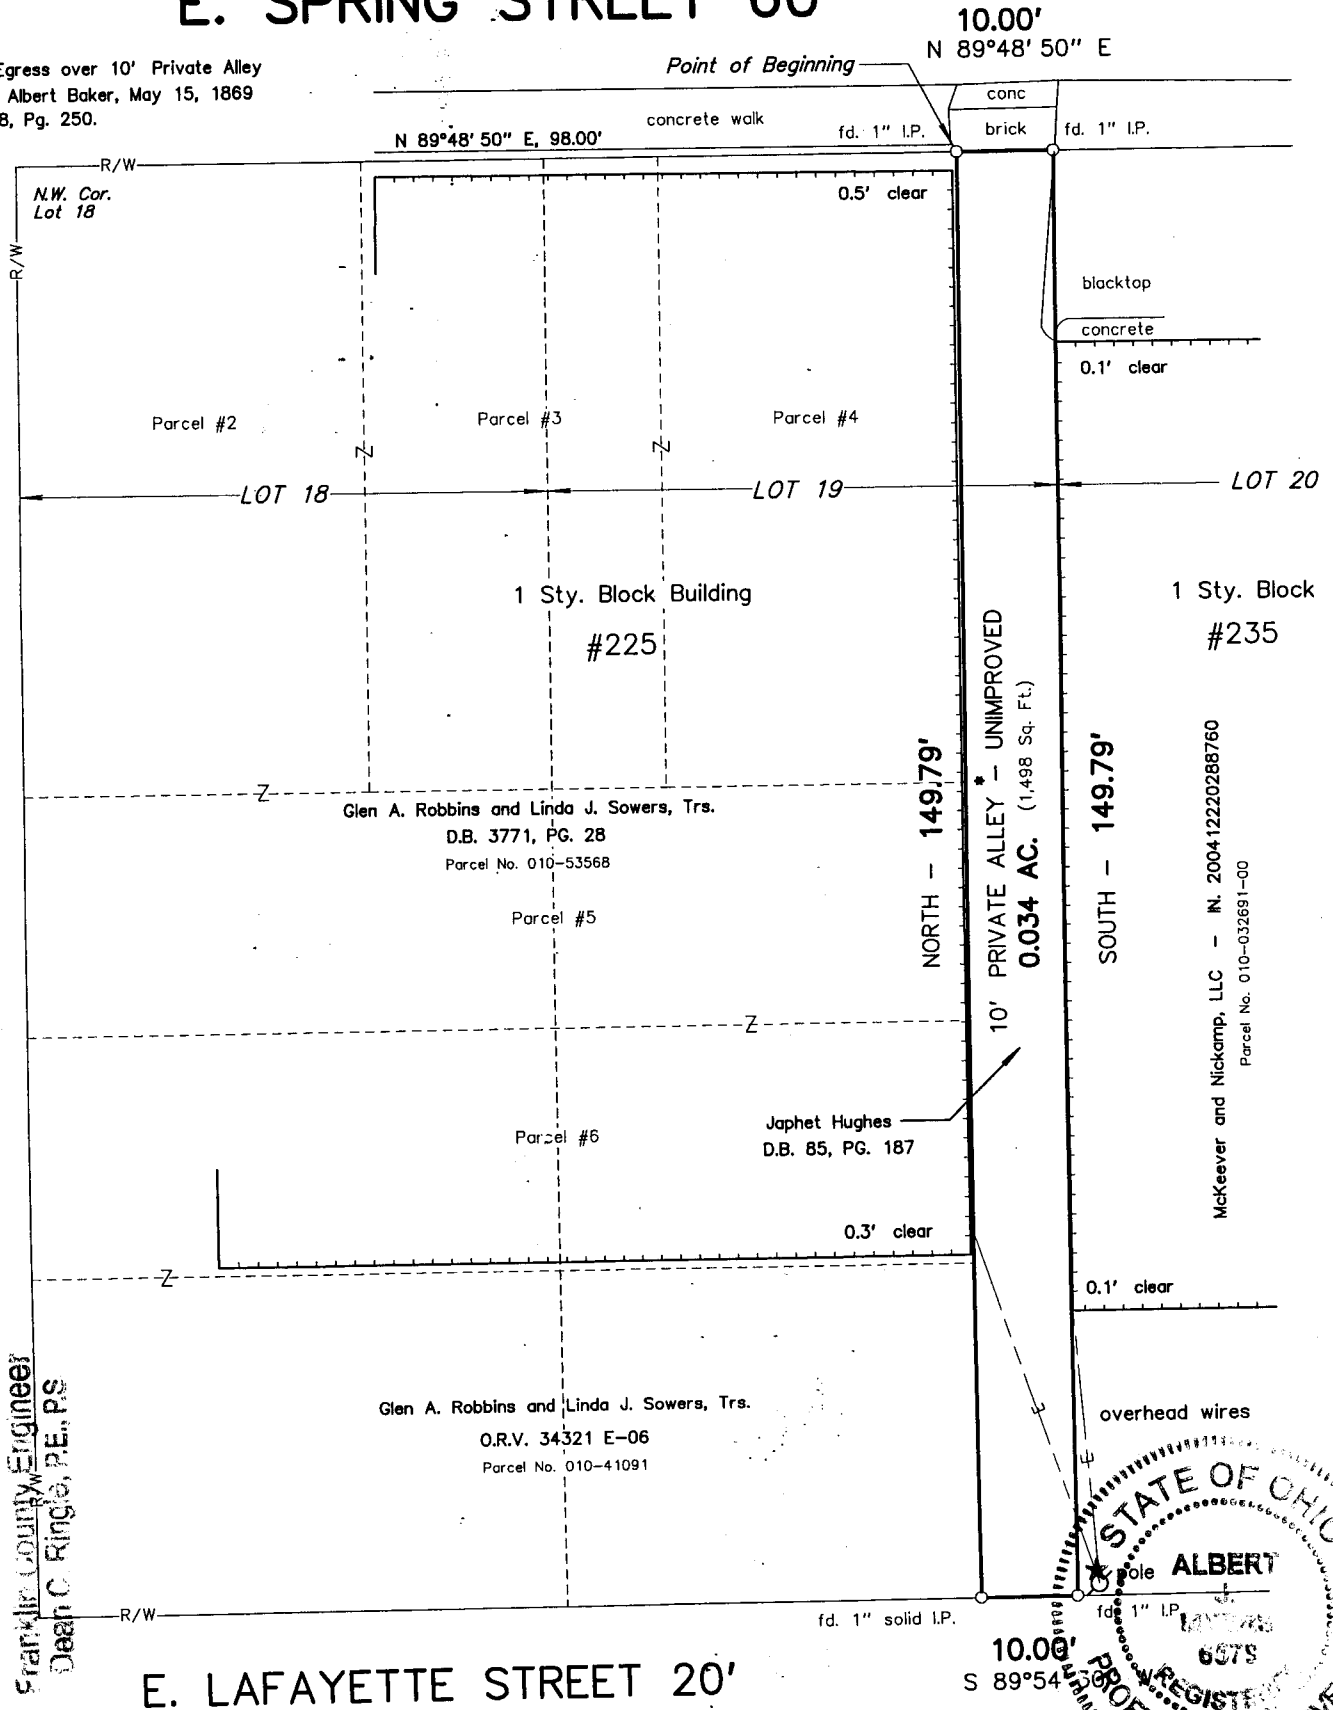

Franklin County Engineer
Dean C. Ringle, P.E., P.S.

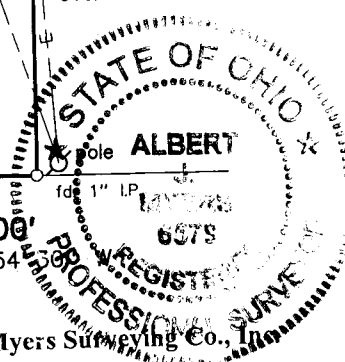

Myers Surveying Co., Inc.
By Albert Myers 11/12/14
Professional Surveyor

We hereby certify that the foregoing Boundary Survey was prepared from actual field measurements in accordance with Chapter 4733-37 Ohio Administrative Code. Iron pipes set are 30"x1" O.D. with an orange plastic plug inscribed "MYERS P.S. 6579", unless otherwise noted. Bearings are based on the west line of North Fifth Street held as NORTH

Myers Order No. - 9-10/08/2014 201410089	Rec. <u>AJ</u>	Field <u>ms</u>	DWG <u>ms</u>	Ltr. <u>ms</u>	Ck.
---	----------------	-----------------	---------------	----------------	-----

RECEIVED