

Myers Surveying Company, Inc.

2740 East Main Street, Columbus 43209 (Bexley), Ohio

614-235-8677

FAX:614-235-4559

A Boundary Survey prepared for and certified to:

Christine Tucker

Legal Description: Situated in The State of Ohio, County of Franklin, City of Upper Arlington Being Lots 19 & 20 and Part of Lot 18 in Block 204, Plat of Blocks 204 to 208, & Part of Blocks 202, 203, 209 & 210 Upper Arlington, Plat Book 20, Page 25


Posted Address: 2261 Brixton Rd., Upper Arlington, Ohio

30' 15' 0' 30'



Scale 1" = 30'

Date: 02/18/2015

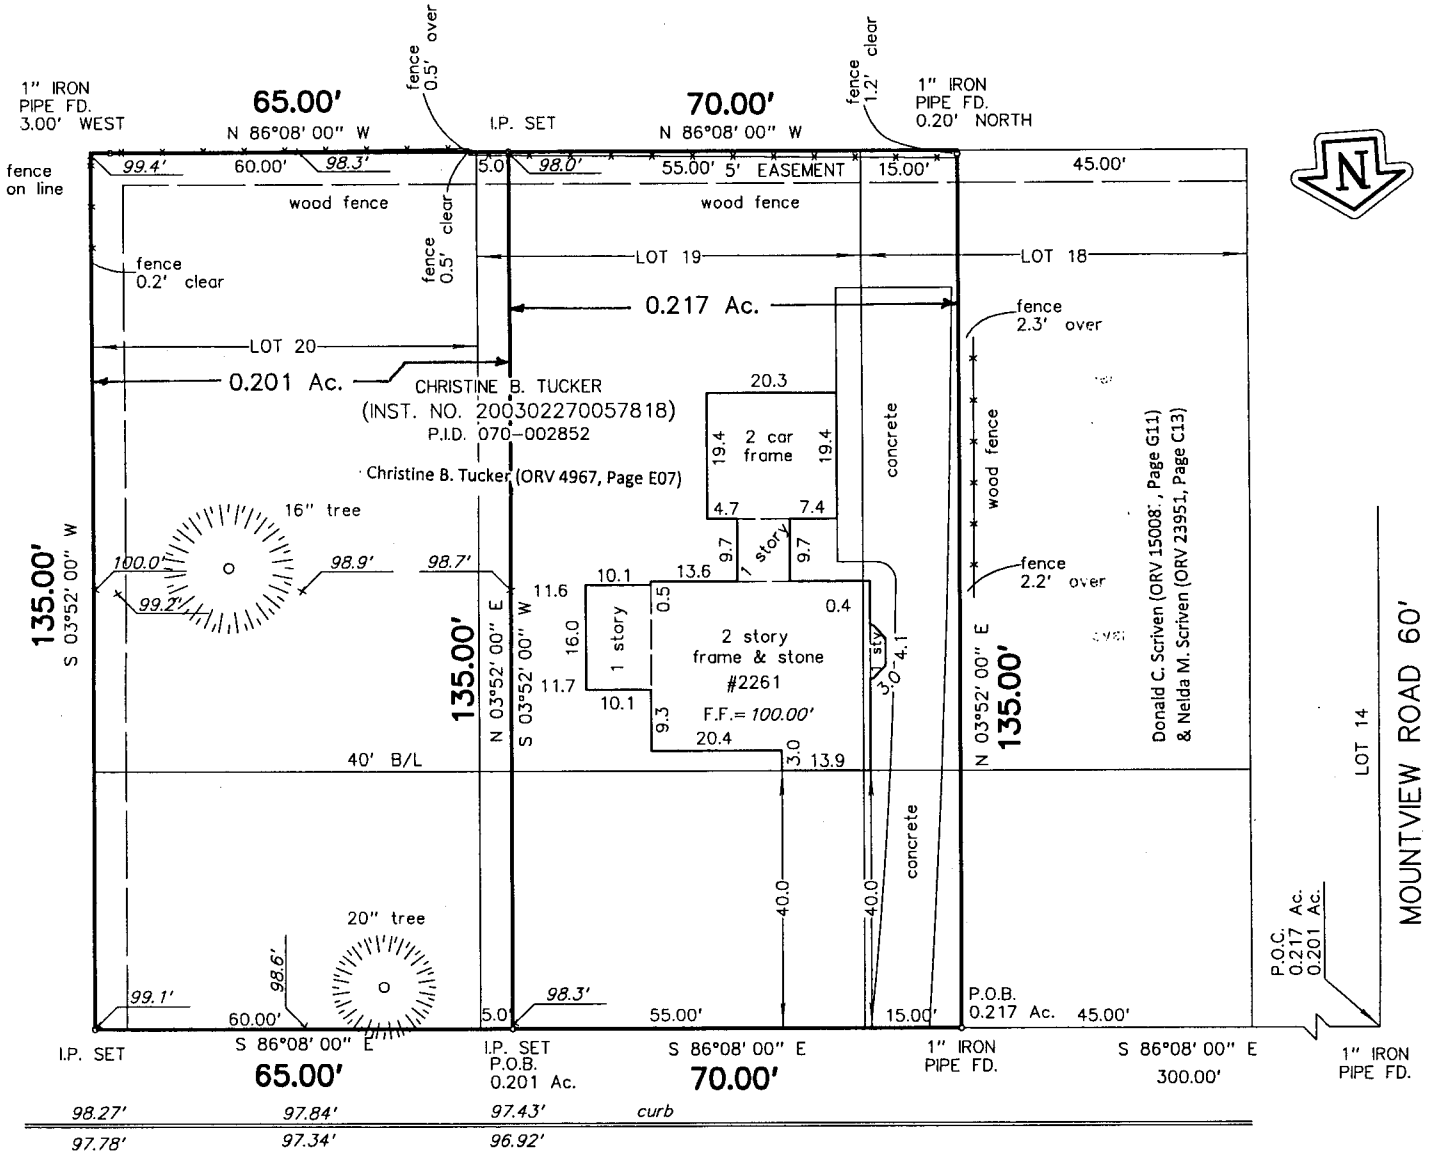

BRIXTON ROAD 60'

RECEIVED

FEB 24 2015

Franklin County, Ohio
Dear Mr. Ringler



Myers Surveying Co., Inc.

By *Albert Myers*
Professional Surveyor

We hereby certify that the foregoing Boundary Survey was prepared from actual field measurements in accordance with Chapter 4733-37 Ohio Administrative Code. Iron pipes set are 30"x1" O.D. with an orange plastic plug inscribed "MYERS P.S. 6579", unless otherwise noted. Basis of bearings is the centerline of Brixton Road held as South 86° 08' 00" East, per Plat Book 20, Page 25.

Myers Order No. - 2-01/23/2015



201501232

Rec.	Field	DWG	Ltr.	Ck.
CA	Row	D50	D50	