

Myers Surveying Company, Inc.

6-3-C

2740 East Main Street, Columbus 43209 (Bexley), Ohio

614-235-8677

FAX:614-235-4559

A Boundary Survey prepared for and certified to:

Clean Title Agency, Inc.

Legal Description: Situated in The State of Ohio, County of Franklin, City of Bexley Being Part of Lot 7, Block 23, Amended Plat of Part of Bullitt Park, Plat Book 5, page 382

Posted Address: 184 S. Parkview Ave., Bexley, Ohio










Scale 1" = 40'
Date: 03/13/2015

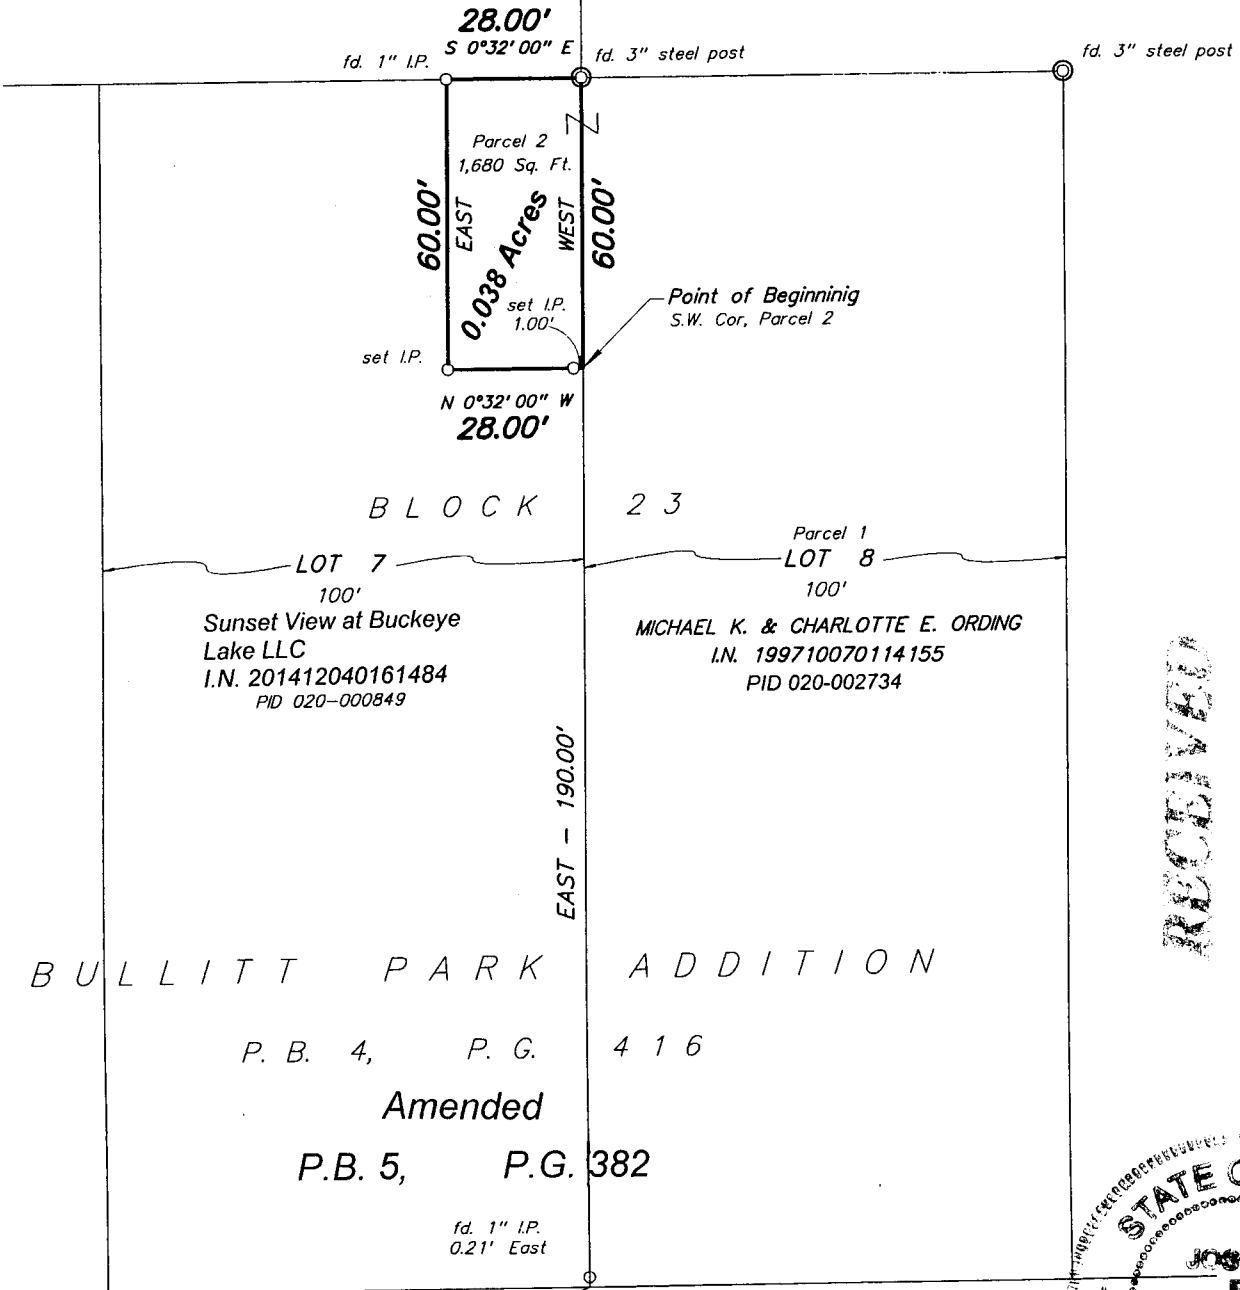

RECEIVED

MAR 16 2015




S. PARKVIEW AVENUE 80'

Myers Surveying Co., Inc.

We hereby certify that the foregoing Boundary Survey was prepared from actual field measurements in accordance with Chapter 4733-37 Ohio Administrative Code. Iron pipes set are 30"x1" O.D. with an orange plastic plug inscribed "MYERS P.S. 6579", unless otherwise noted. Basis of bearings is the south line of Lot 7 held as EAST.

By *Joseph P. Myers*
3/13/2015
Professional Surveyor

Myers Order No. - 2-03/09/2015



201503092

Rec.

Field

AJ

DWG

me

Ltr.

me

Ck.