



Evans, Mechwart, Hambleton & Tilton, Inc.
 Engineers • Surveyors • Planners • Scientists
 5500 New Albany Road, Columbus, OH 43054
 Phone: 614.775.4500 Toll Free: 888.775.3648

emht.com

SURVEY OF ACREAGE PARCEL

QUARTER TOWNSHIP 3, TOWNSHIP 2, RANGE 19


UNITED STATES MILITARY LANDS

CITY OF DUBLIN, COUNTY OF FRANKLIN, STATE OF OHIO

Date: May 27, 2015

Scale: 1" = 60'

Job No. 2013-0451

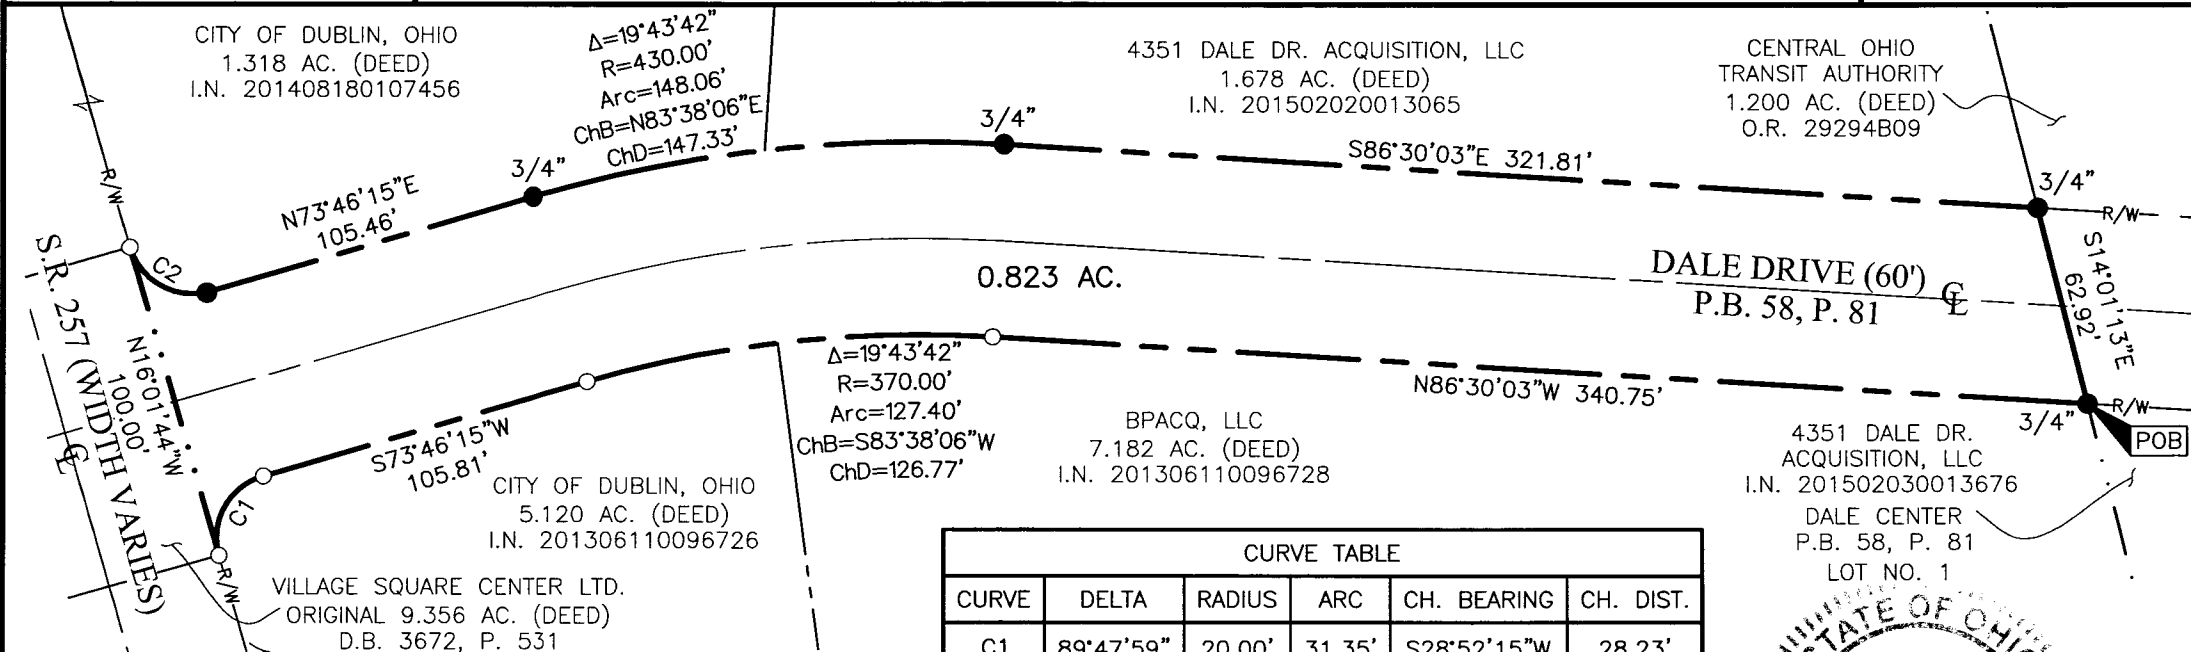

CURVE TABLE					
CURVE	DELTA	RADIUS	ARC	CH. BEARING	CH. DIST.
C1	89°47'59"	20.00'	31.35'	S28°52'15"W	28.23'
C2	90°12'01"	20.00'	31.49'	S61°07'45"E	28.33'

● = I.P. FND.
 ○ = I.P. SET

I.P. Set are 13/16" I.D. iron pipe with cap inscribed EMHT INC



GRAPHIC SCALE (in feet)

SURVEY NOTE:


This survey was prepared using documents of record, prior plats of survey, and observed evidence located by an actual field survey.

BASIS OF BEARINGS:

The Bearings shown hereon are based on the Ohio State Plane Coordinate System South Zone as per NAD83 (1986 Adjustment). Control for bearings was from coordinates of monuments FRANK 73 and FRANK 74, having a bearing of South 73° 57' 18" East, established by the Franklin County Engineers Department, using Global Positioning System procedures and equipment.

J:\20130451\DWG\04SHEETS\BOUNDARY\20130451-VS-BNDY-22.DWG plotted by MAGERS, MARCUS on 5/27/2015 8:38:37 AM last saved by MMAGERS on 5/27/2015 7:43:00 AM

Xrefs:

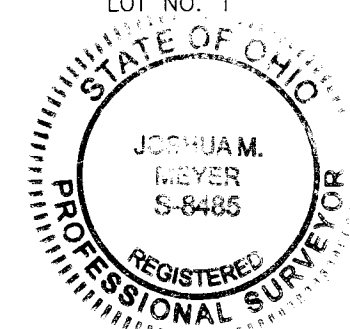

By *J.M.M.*

Joshua M. Meyer
 Professional Surveyor No. 8485

S-27-2015

Date

RECEIVED

MAY 28 2015

Franklin County Engineer
 Dean C. Ringle, P.E., P.S.