


SURVEY OF ACREAGE PARCELS

SECTION 6, TOWNSHIP 5, RANGE 22

REFUGEE LANDS

CITY OF GRANDVIEW HEIGHTS, COUNTY OF FRANKLIN, STATE OF OHIO

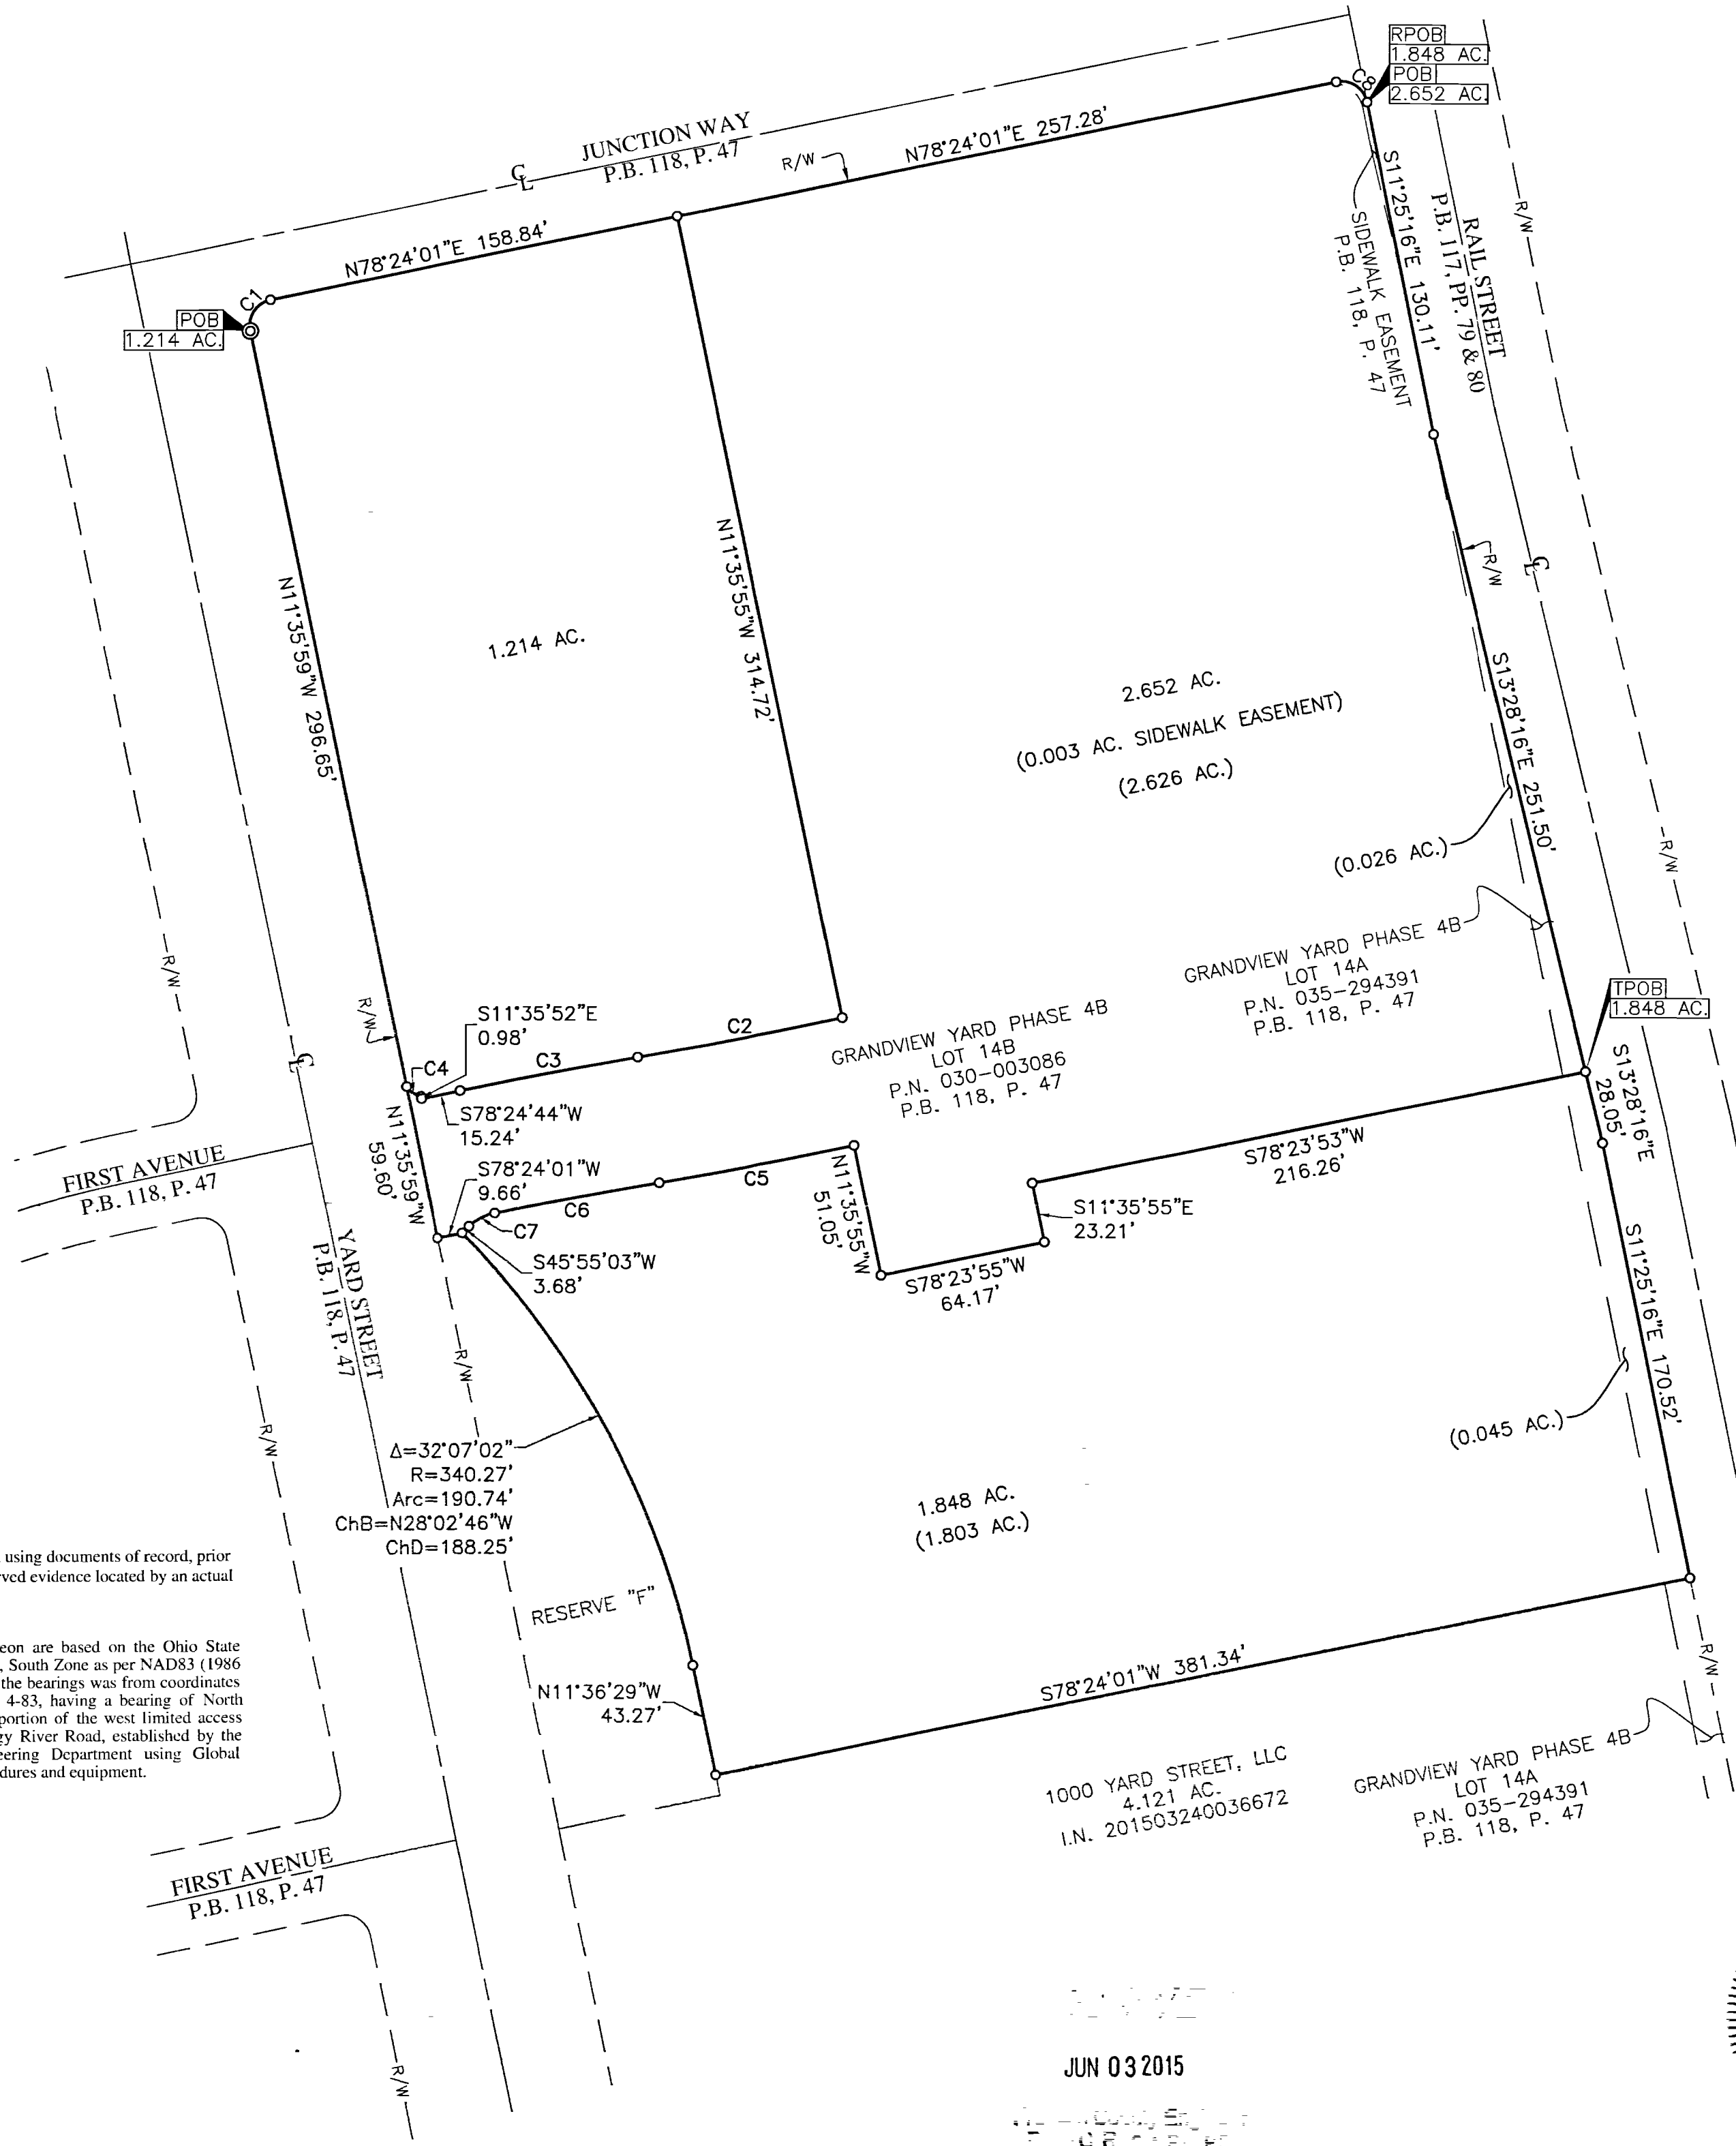

SURVEY NOTE:
This survey was prepared using documents of record, prior plats of survey, and observed evidence located by an actual field survey.

BASIS OF BEARINGS:
The bearings shown hereon are based on the Ohio State Plane Coordinate System, South Zone as per NAD83 (1986 adjustment). Control for the bearings was from coordinates of monuments 5-83 and 4-83, having a bearing of North 00° 22' 10" West, for a portion of the west limited access right-of-way of Olentangy River Road, established by the Franklin County Engineering Department using Global Positioning System procedures and equipment.

○ = I.P. SET
⊙ = PM SET


I.P. Set are 13/16" I.D. iron pipe with cap inscribed EMHT INC

PERMANENT MARKERS:
Permanent markers, where indicated hereon, are to be one-inch diameter, thirty-inch long, solid iron pins. Pins are to be set to monument the points indicated and are to be set with the top end flush with the surface of the ground and then capped with an aluminum cap stamped EMHT INC. Once installed, the top of the cap shall be marked (punched) to record the actual location of the point.



CURVE TABLE					
CURVE	DELTA	RADIUS	ARC	CH. BEARING	CH. DIST.
C1	90°00'00"	10.00'	15.71'	N33°24'01"E	14.14'
C2	2°12'55"	2059.45'	79.63'	N79°14'43"E	79.63'
C3	1°57'38"	2024.50'	69.27'	N79°23'33"E	69.27'
C4	38°56'11"	10.00'	6.80'	S56°38'19"E	6.67'
C5	2°07'04"	2055.54'	75.98'	S79°17'40"W	75.97'
C6	1°51'35"	1975.50'	64.12'	S79°25'52"W	64.11'
C7	30°59'08"	20.71'	11.20'	S63°00'31"W	11.06'
C8	90°10'43"	10.00'	15.74'	S56°30'37"E	14.16'

JUN 03 2015

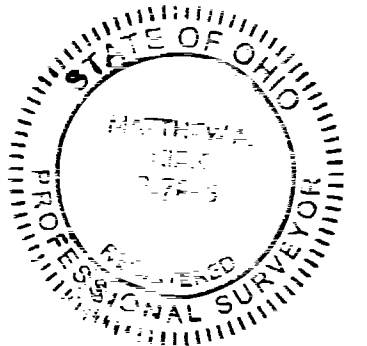

By Matthew A. Kirk Date 2 JUNE 15
Matthew A. Kirk
Professional Surveyor No. 7865

EMHT Evans, Mechwart, Hambleton & Tilton, Inc. Engineers • Surveyors • Planners • Scientists 5500 New Albany Road, Columbus, OH 43054 Phone: 614.775.4500 Toll Free: 888.775.3648 emht.com		Date: June 2, 2015
		Scale: 1" = 50'
		Job No: 2014-0258
		Sheet: 1 of 1
REVISIONS		
MARK	DATE	DESCRIPTION