

SURVEY OF ACREAGE PARCEL

QUARTER TOWNSHIP 3, TOWNSHIP 2, RANGE 16

UNITED STATES MILITARY LANDS



CITY OF COLUMBUS, COUNTY OF FRANKLIN, STATE OF OHIO

REVISION

AUG 06 2015

Franklin County Engineer
Dennis C. Rupp, P.E., P.S.

CURVE TABLE				
CURVE	DELTA	RADIUS	ARC	CH. BEARING
C1	26°56'22"	105.00'	49.37'	N16°26'39"E
C2	84°44'23"	55.00'	81.34'	N72°17'01"E
C3	72°45'43"	105.75'	134.30'	N78°16'21"E
C4	100°04'12"	85.00'	148.46'	N08°08'36"W
C5	80°57'41"	55.00'	77.72'	N81°56'48"E
C6	36°00'30"	150.00'	94.27'	S75°34'37"E
C7	144°30'43"	55.00'	138.72'	N14°09'46"E
C8	36°59'35"	250.00'	161.41'	N39°35'48"W
C9	100°28'54"	15.00'	26.31'	N29°08'27"E
C10	90°03'32"	35.00'	55.01'	N34°21'08"E
C11	36°14'11"	76.90'	48.63'	S73°55'55"E
C12	28°15'17"	71.67'	35.34'	S69°56'29"E
C13	22°49'55"	174.08'	69.37'	S72°39'10"E
C14	104°11'45"	22.08'	40.16'	S25°35'23"E
C15	27°41'24"	144.55'	69.86'	S12°39'47"W

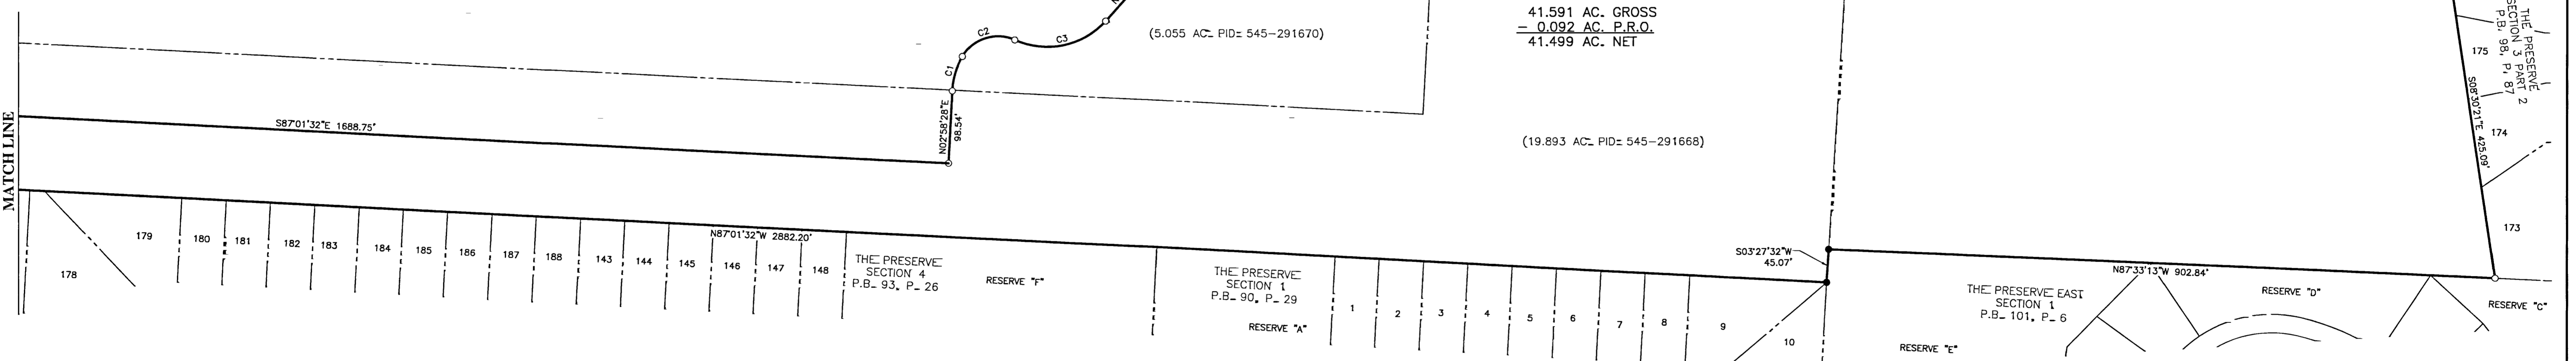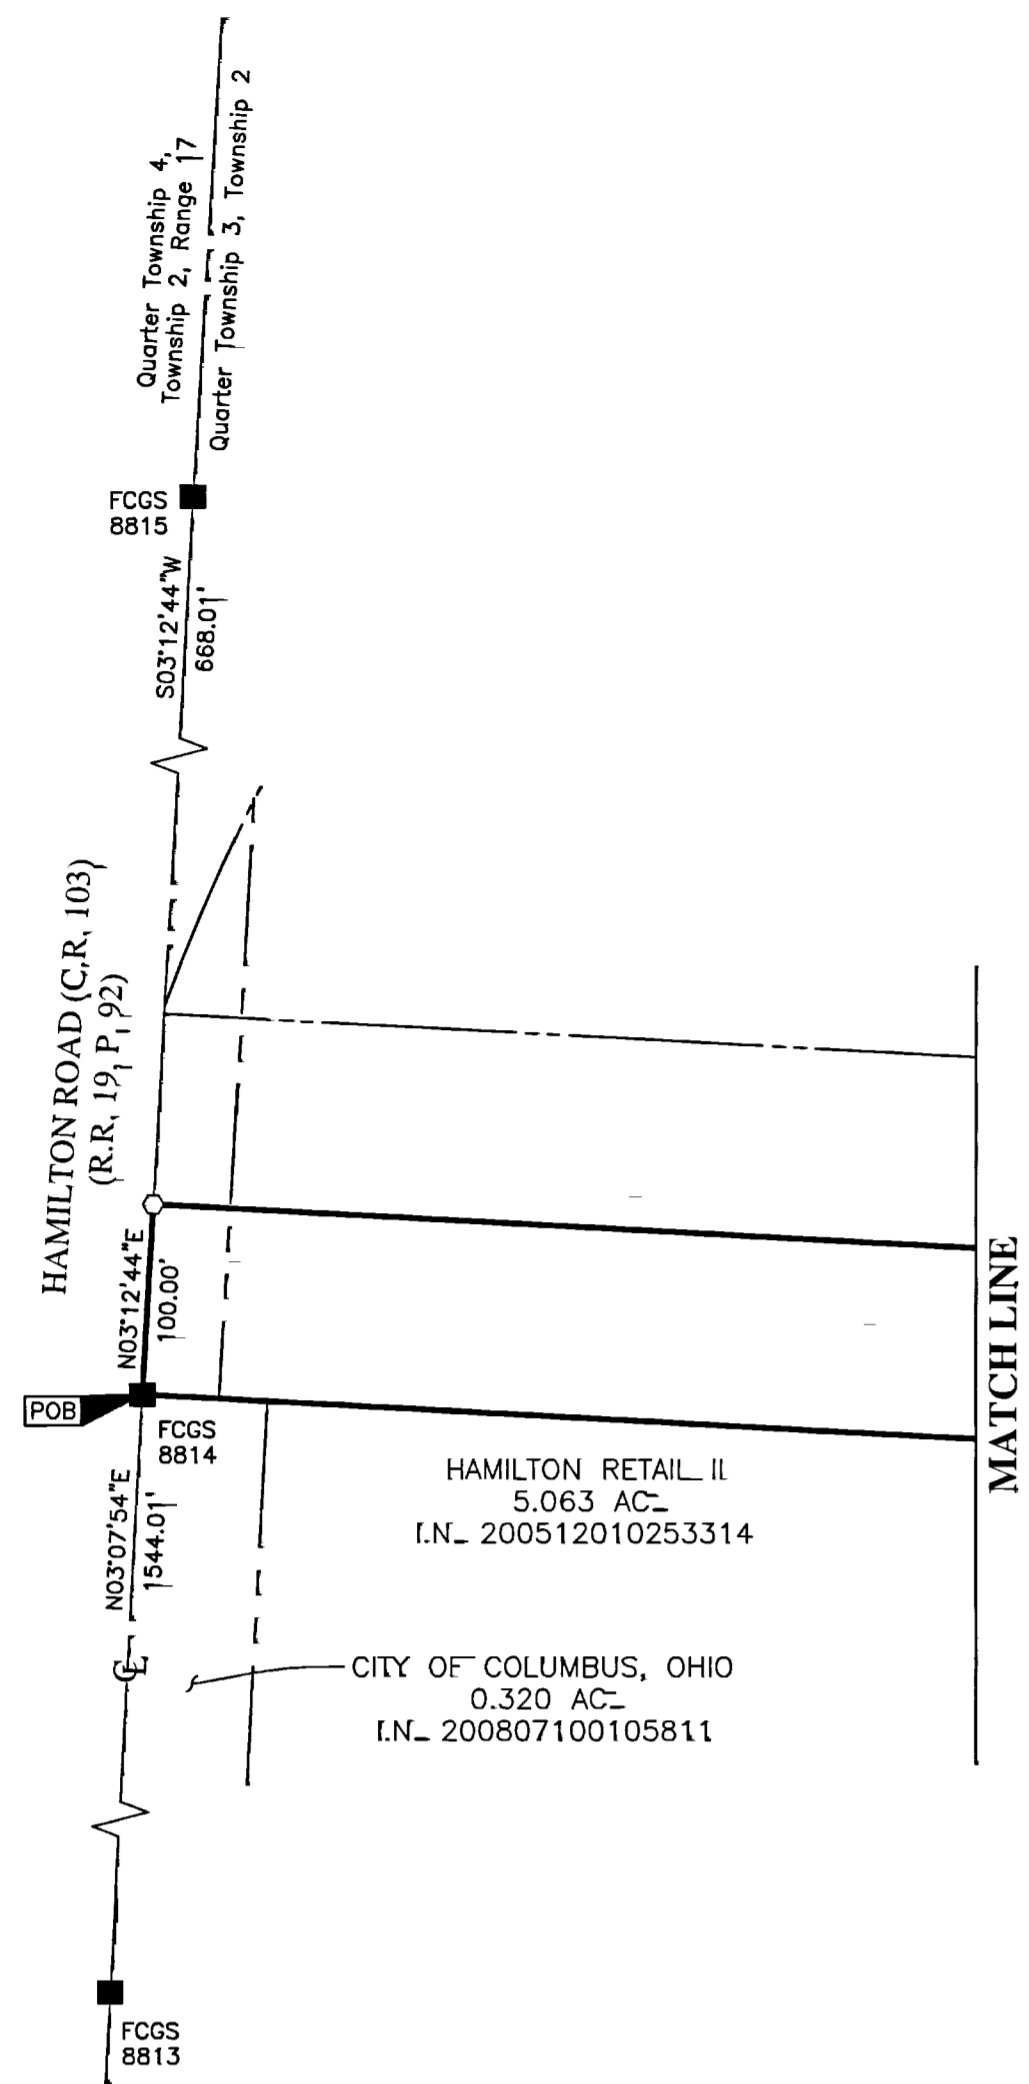


BASIS OF BEARINGS=
Bearings are based on the Ohio State Plane Coordinate System as per NAD83, South Zone (2007 Adjustment). Control for bearings was from coordinates of monuments FCGS 8815 & FCGS 8816, having a bearing of North 03° 23' 04" East for a portion of the centerline of Hamilton Road (Relocated), established by the Franklin County Engineering Department, using Global Positioning System procedures and equipment.

SURVEY NOTE=
This survey was prepared using documents of record, prior plats of survey, and observed evidence located by an actual field survey.

By 8/6/15
Heather L. King
Professional Surveyor No. 8307

- = STONE FND.
 - = MON. FND.
 - = 3/4" I.P. FND.
 - = I.P. SET
 - = MAG. NAIL FND.
 - = MAG. NAIL SET
 - ▲ = R.R. SPK. FND.
 - ▲ = R.R. SPK. SET
 - = P.K. NAIL FND.
- I.P. Set are 13/16" I.D. iron pipe with cap inscribed EMHT INC

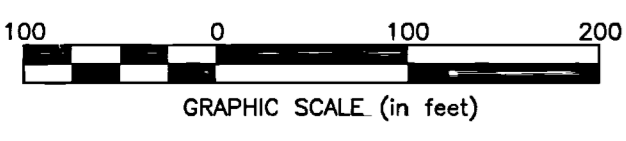

<p style="font-size: 8px;">Evans, Mechwart, Hambleton & Tibon, Inc. Engineers • Surveyors • Planners • Scientists 5500 New Albany Road, Columbus, OH 43254 Phone: 614.775.4550 • Toll Free: 888.775.3648 emht.com</p>	Date: August 5, 2015	
	Scale: 1" = 100'	
	Job No: 2015-0225	
	Sheet: 1 of 1	
REVISIONS		
MARK	DATE	DESCRIPTION