

Myers Surveying Company, Inc.

2740 East Main Street, Columbus 43209 (Bexley), Ohio
614-235-8677 FAX:614-235-4559

A Boundary Survey prepared for and certified to:

Washington Avenue United Methodist Church

Legal Description: Situated in The State of Ohio, County of Franklin, City of Columbus Being Lots 16, 17, 18 and 19 Charles Kautz's Addition, Plat Book 5, page 234

Applicant:

Posted Address: 359 E. Markison Avenue & Parking lot, Columbus,

RECEIVED

OCT 02 2015

Franklin County Engineer
Dean C. Ringle, P.E., P.S.





Scale 1" = 40'
Date: 09/25/2015



Zoned: R2F

Note: Name changed on Lots 16 thru 19, 37 & 38 by Affidavit of Name Change recorded in Inst. No. 201509110127970 to Washington Avenue United Methodist Church.

WASHINGTON AVENUE 50'

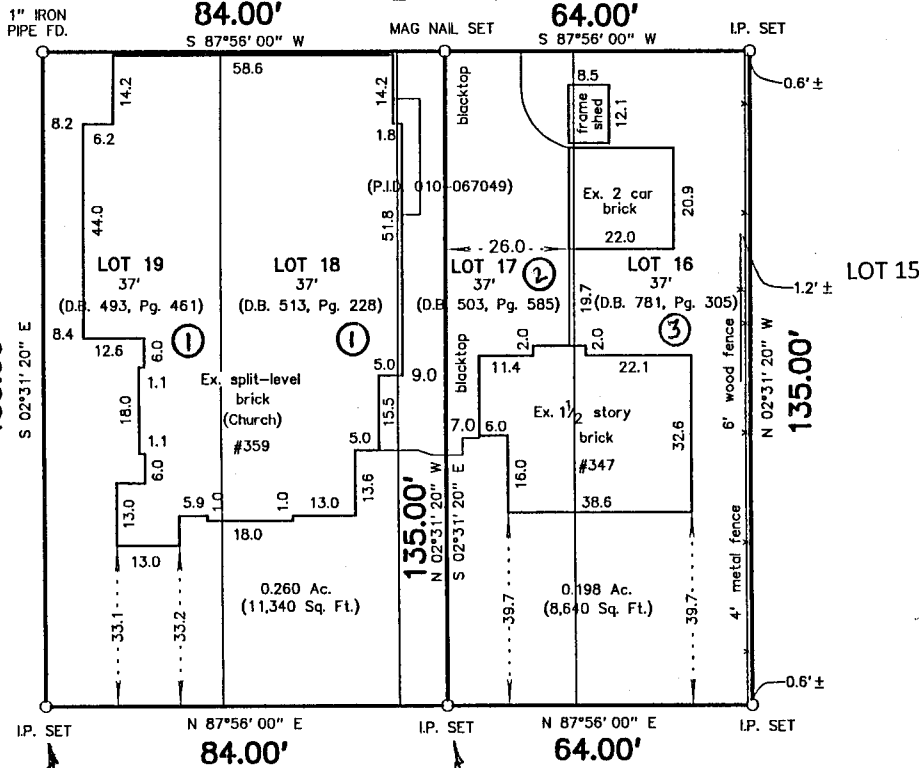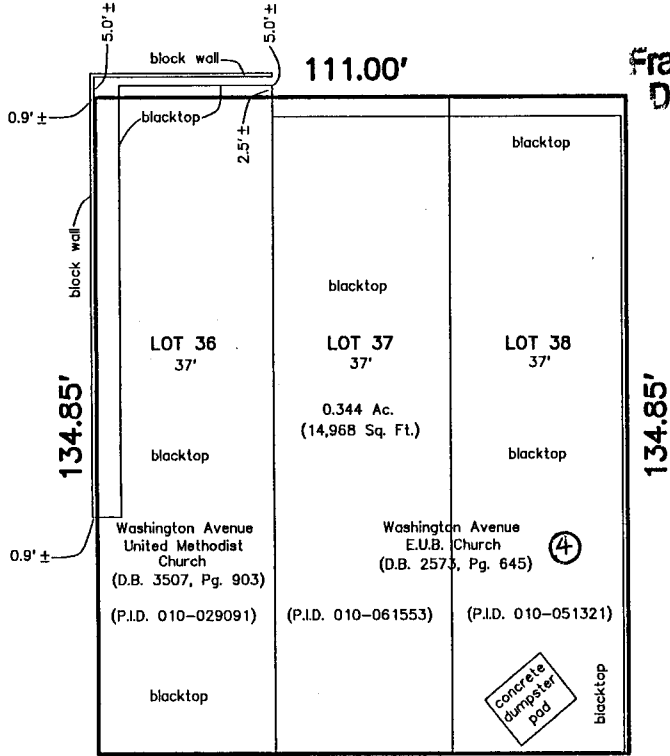

P.O.B. 0.260 Ac. &
P.O.C. 0.198 Ac.

MARKISON AVENUE 60'

Prior Names per Deed:

- ① Trustees of the Washington Avenue United Brethren Church
- ② Trustees of the Washington Avenue United Brethren in Christ
- ③ The Washington Avenue Church of the United Brethren in Christ
- ④ Washington Avenue E.U.B. Church



Myers Surveying Co., Inc.

By *Joseph P. Myers*
9/25/2015
Professional Surveyor

We hereby certify that the foregoing Boundary Survey was prepared from actual field measurements in accordance with Chapter 4733-37 Ohio Administrative Code. Iron pipes set are 30"x1" O.D. with an orange plastic plug inscribed "MYERS P.S. 6579", unless otherwise noted. Basis of bearings is the south line of Markison held as North 87° 56' 00" East. Lots 36 -38 shown for zoning purposes only.

Myers Order No. - 9-06/18/2015



201506189

Rec. Field DWG Ltr. Ck.