J-2-B
I-8-E

SURVEY OF ACREAGE PARCELS

QUARTER TOWNSHIP 3, TOWNSHIP 2, RANGE 16
UNITED STATES MILITARY LANDS
CITY OF COLUMBUS, COUNTY OF FRANKLIN, STATE OF OHIO

EMH&T
Evans, Mechwart, Hambleton & Tilton, Inc.
Engineers • Surveyors • Planners • Scientists
5500 New Albany Road, Columbus, OH 43054
Phone: 614.775.4500 Toll Free: 888.775.3648
emht.com

Date: August 27, 2015 | Job No. 2015-0682 | Scale: 1" = 200'

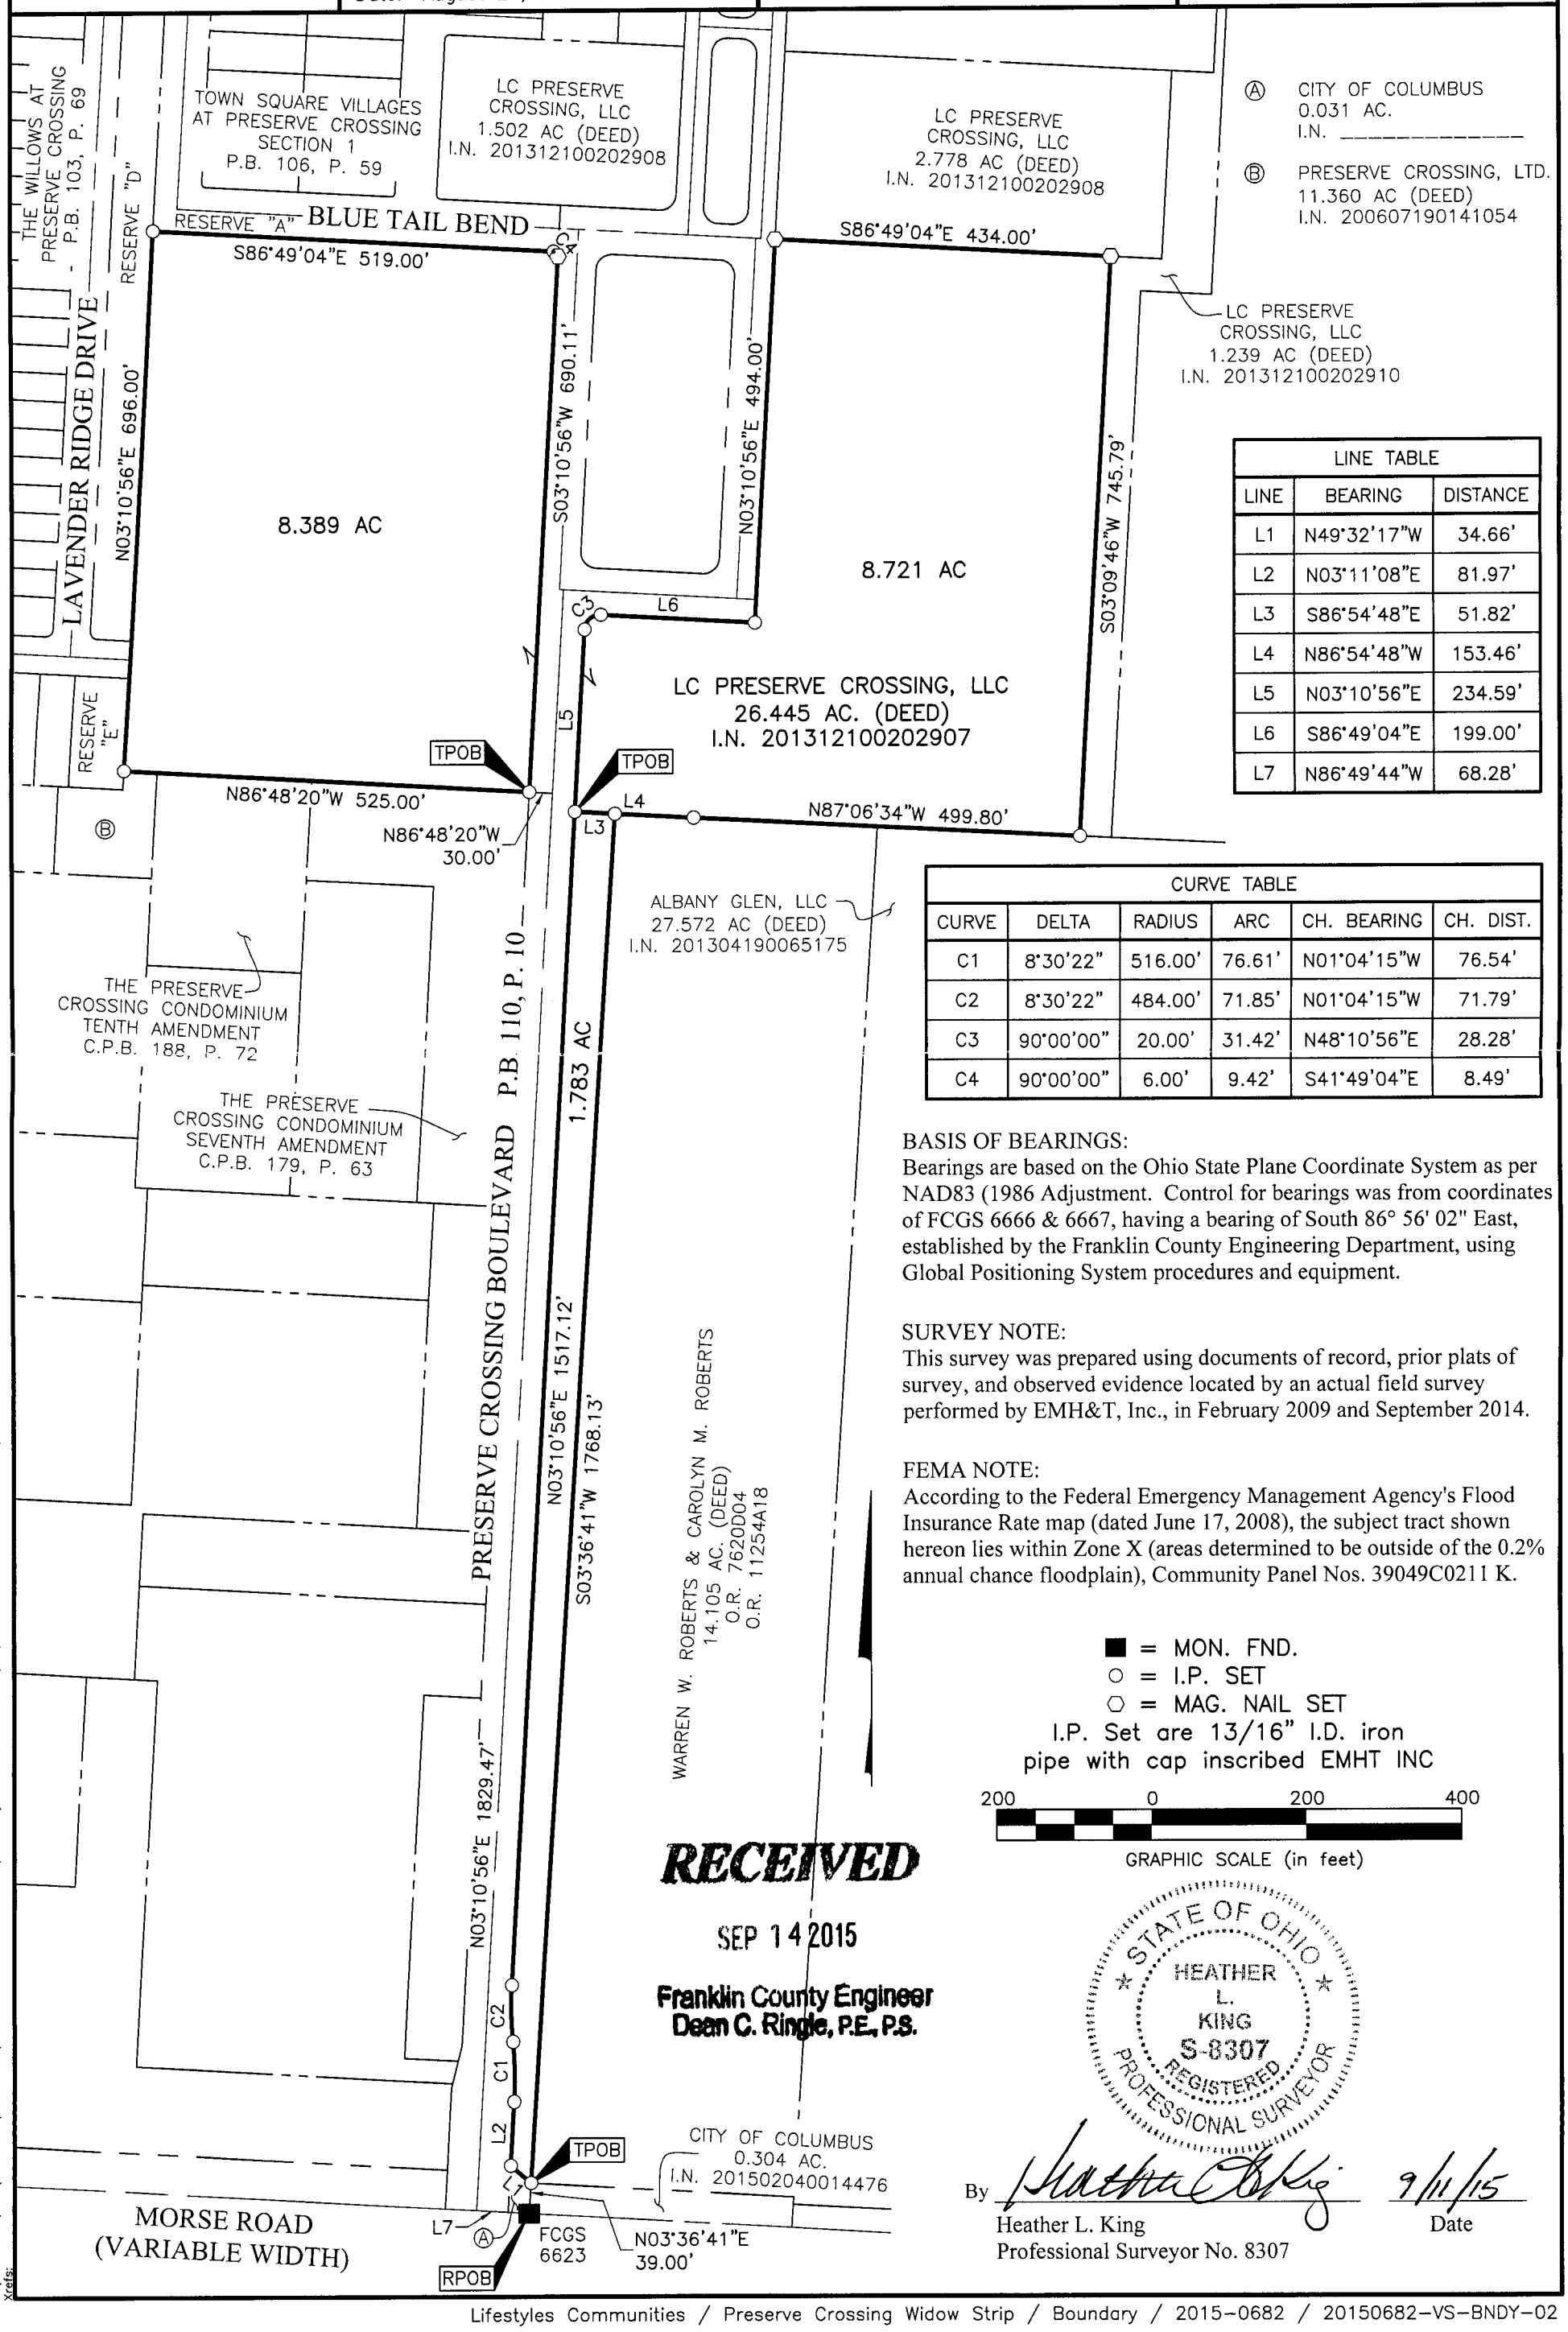

LINE TABLE		
LINE	BEARING	DISTANCE
L1	N49°32'17"W	34.66'
L2	N03°11'08"E	81.97'
L3	S86°54'48"E	51.82'
L4	N86°54'48"W	153.46'
L5	N03°10'56"E	234.59'
L6	S86°49'04"E	199.00'
L7	N86°49'44"W	68.28'

CURVE TABLE					
CURVE	DELTA	RADIUS	ARC	CH. BEARING	CH. DIST.
C1	8°30'22"	516.00'	76.61'	N01°04'15"W	76.54'
C2	8°30'22"	484.00'	71.85'	N01°04'15"W	71.79'
C3	90°00'00"	20.00'	31.42'	N48°10'56"E	28.28'
C4	90°00'00"	6.00'	9.42'	S41°49'04"E	8.49'

BASIS OF BEARINGS:
Bearings are based on the Ohio State Plane Coordinate System as per NAD83 (1986 Adjustment. Control for bearings was from coordinates of FCGS 6666 & 6667, having a bearing of South 86° 56' 02" East, established by the Franklin County Engineering Department, using Global Positioning System procedures and equipment.

SURVEY NOTE:
This survey was prepared using documents of record, prior plats of survey, and observed evidence located by an actual field survey performed by EMH&T, Inc., in February 2009 and September 2014.

FEMA NOTE:
According to the Federal Emergency Management Agency's Flood Insurance Rate map (dated June 17, 2008), the subject tract shown hereon lies within Zone X (areas determined to be outside of the 0.2% annual chance floodplain), Community Panel Nos. 39049C0211 K.

■ = MON. FND.
○ = I.P. SET
⬡ = MAG. NAIL SET
I.P. Set are 13/16" I.D. iron pipe with cap inscribed EMHT INC

200 0 200 400
GRAPHIC SCALE (in feet)

RECEIVED
SEP 14 2015
Franklin County Engineer
Dean C. Ringle, P.E., P.S.

STATE OF OHIO
HEATHER L. KING
S-8307
REGISTERED PROFESSIONAL SURVEYOR

By _____ 9/11/15
Heather L. King
Professional Surveyor No. 8307
Date

J:\20150682\DWG\04SHEETS\BOUNDARY\20150682-VS-BNDY-02.DWG plotted by KING, HEATHER on 9/11/2015 10:10:14 AM last saved by HKING on 9/11/2015 10:06:51 AM
Xrefs: