

Franklin County Engineer  
Dean C. Finkbeiner

# P & L SYSTEMS, INC.

## SURVEYORS & ENGINEERS

171 CHARRING CROSS DRIVE  
WESTERVILLE, OHIO 43081

# RECEIVED



NOV 18 2015

### 1.216 ACRE PLAT OF SURVEY

SITUATED IN THE STATE OF OHIO, COUNTY OF FRANKLIN, CITY OF WESTERVILLE, BEING PART OF QUARTER TOWNSHIP 2, TOWNSHIP 2, RANGE 17, UNITED STATES MILITARY DISTRICT, AND BEING A 1.216 ACRE PARCEL OF LAND OUT OF A 6.726 ACRE PARCEL CONVEYED TO R.S.M. PROPERTIES, L.L.C., IN INSTRUMENT NUMBER 200508300179201, FRANKLIN COUNTY RECORDER'S OFFICE, COLUMBUS, OHIO.

#### BASIS OF BEARINGS:


THE BEARINGS SHOWN HEREON ARE BASED UPON THE CENTERLINE BEARING OF CHERRINGTON ROAD, BEING S 85° 08' 46" E, AS CALCULATED THROUGH GPS OBSERVATIONS OF FOUND ROAD RIGHT-OF-WAY MONUMENTS, AND FOUND PROPERTY CORNERS, UTILIZING THE OHIO DEPARTMENT OF TRANSPORTATION'S VIRTUAL REFERENCE STATION (VRS), REAL TIME KINEMATIC NETWORK. THE HORIZONTAL COMPONENT OF THE VRS NETWORK IS BASED UPON THE NAD83(2011) REFERENCE FRAME, UTILIZING MOUNTPOINT : ODOT\_NAD83(2011)\_RTCM30(GEOID 12A).

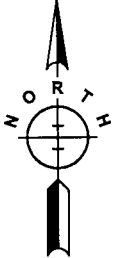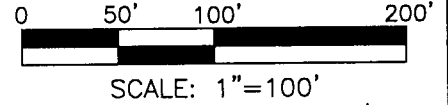

GLENACRE DR. (50' R/W)

CHERRINGTON ROAD (60' R/W)

HANBY HEIGHTS  
P.B. 28, PG. 50

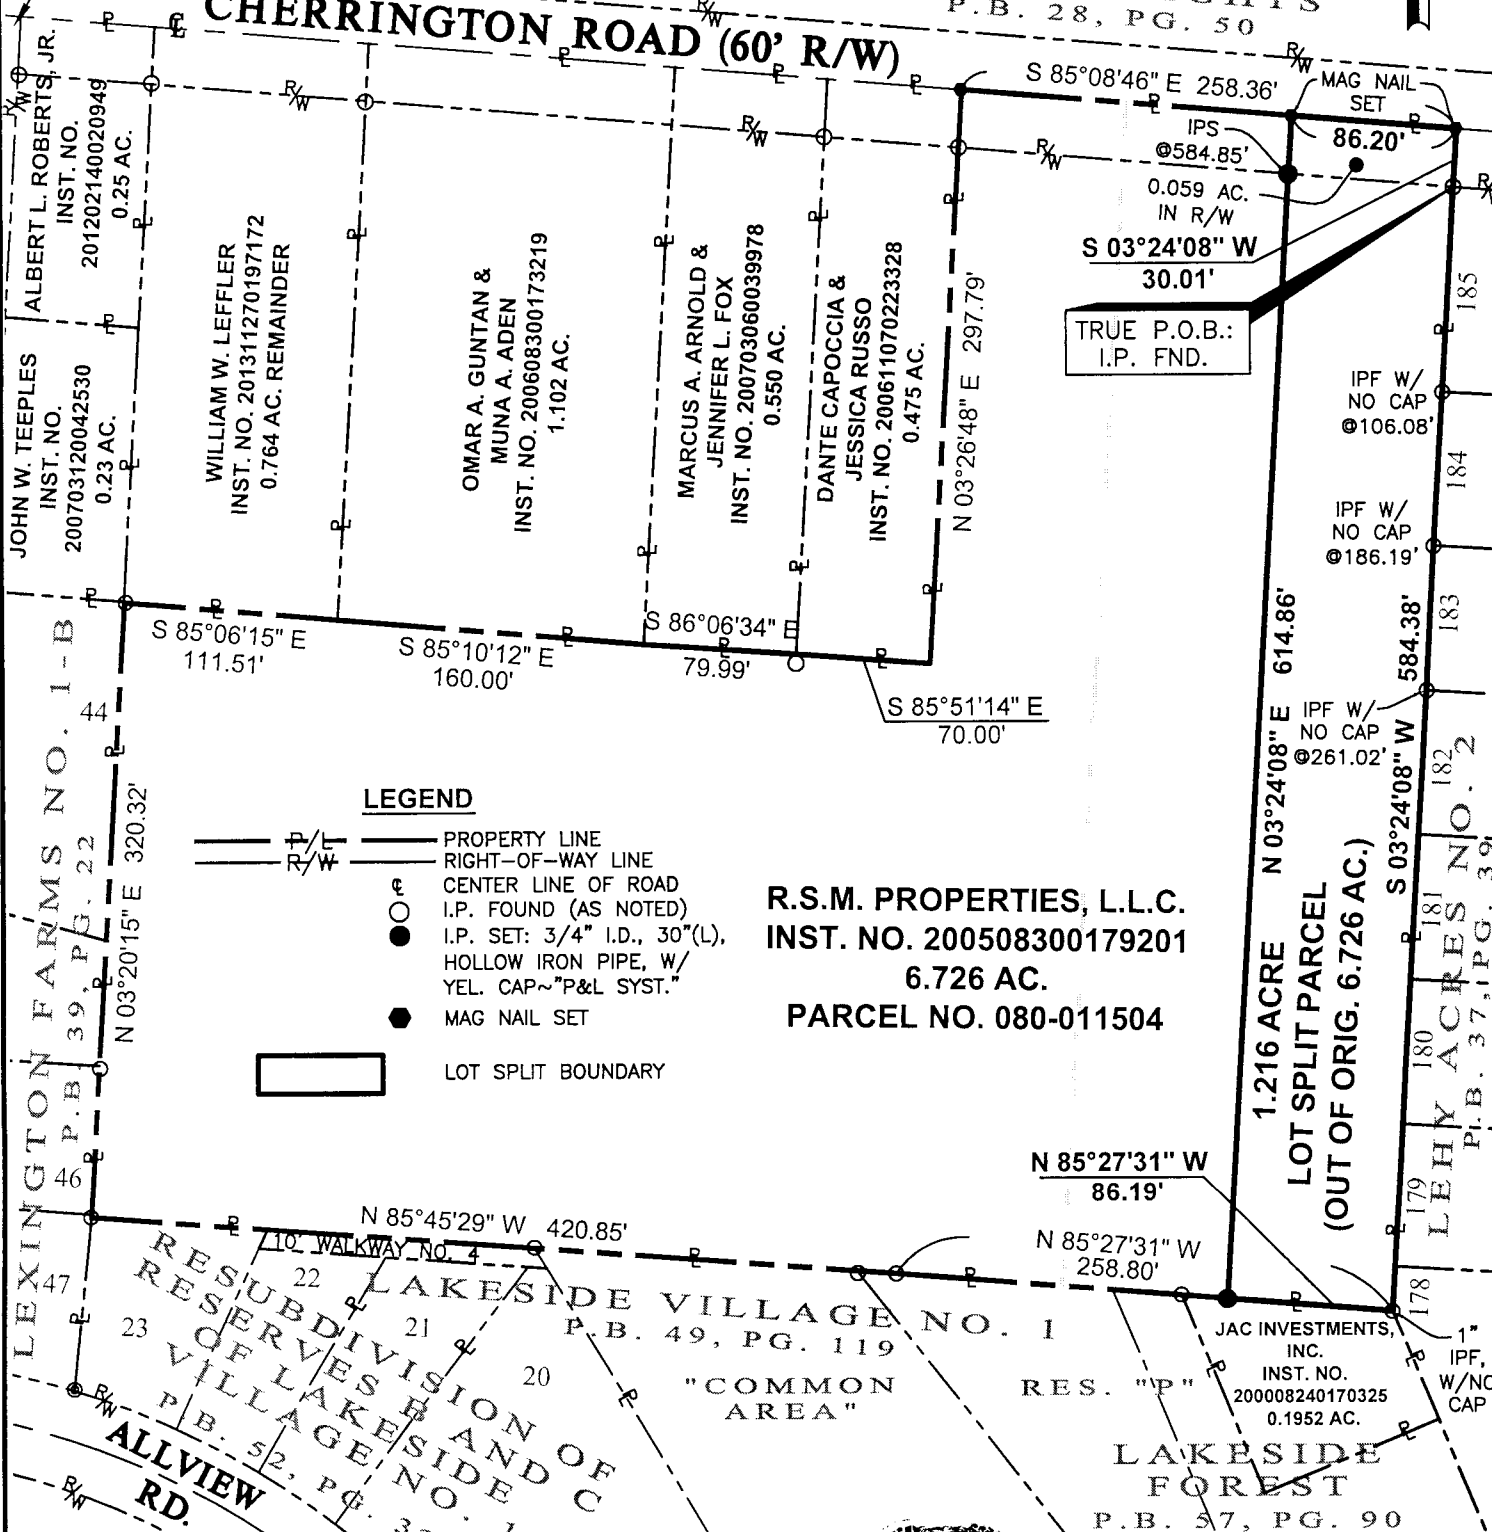

#### LEGEND

- PROPERTY LINE
- RIGHT-OF-WAY LINE
- CENTER LINE OF ROAD
- I.P. FOUND (AS NOTED)
- I.P. SET: 3/4" I.D., 30"(L), HOLLOW IRON PIPE, W/ YEL. CAP~"P&L SYST."
- MAG NAIL SET
- LOT SPLIT BOUNDARY


**R.S.M. PROPERTIES, L.L.C.**  
**INST. NO. 200508300179201**  
**6.726 AC.**  
**PARCEL NO. 080-011504**

#### CERTIFICATION:

I, THE UNDERSIGNED, HEREBY CERTIFY THAT P & L SYSTEMS, INC. SURVEYED THE PREMISES SHOWN HEREON, PREPARED THIS PLAT AND THAT SAID PLAT IS CORRECT TO THE BEST OF MY KNOWLEDGE AND BELIEF. DIMENSIONS ARE SHOWN IN FEET AND DECIMAL PARTS THEREOF.

*William G. Weber*  
SIGNATURE

11-10-15  
DATE

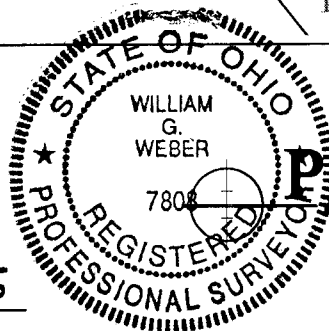

## Systems, Inc.

Surveyors • Engineers  
Planners

171 Charring Cross Dr.  
Westerville, Ohio 43081  
Phone: (614) 891-4970  
Fax: (614) 891-4984