



Evans, Mechwart, Hambleton & Tilton, Inc.
Engineers • Surveyors • Planners • Scientists
5500 New Albany Road, Columbus, OH 43054
Phone: 614.775.4500 Toll Free: 888.775.3648

emht.com

SURVEY OF ACREAGE PARCEL

QUARTER TOWNSHIP 3, TOWNSHIP 2, RANGE 17


UNITED STATES MILITARY LANDS

TOWNSHIP OF BLENDON, COUNTY OF FRANKLIN, STATE OF OHIO

Date: April 7, 2016

Job No. 2015-1786

Scale: 1" = 100'

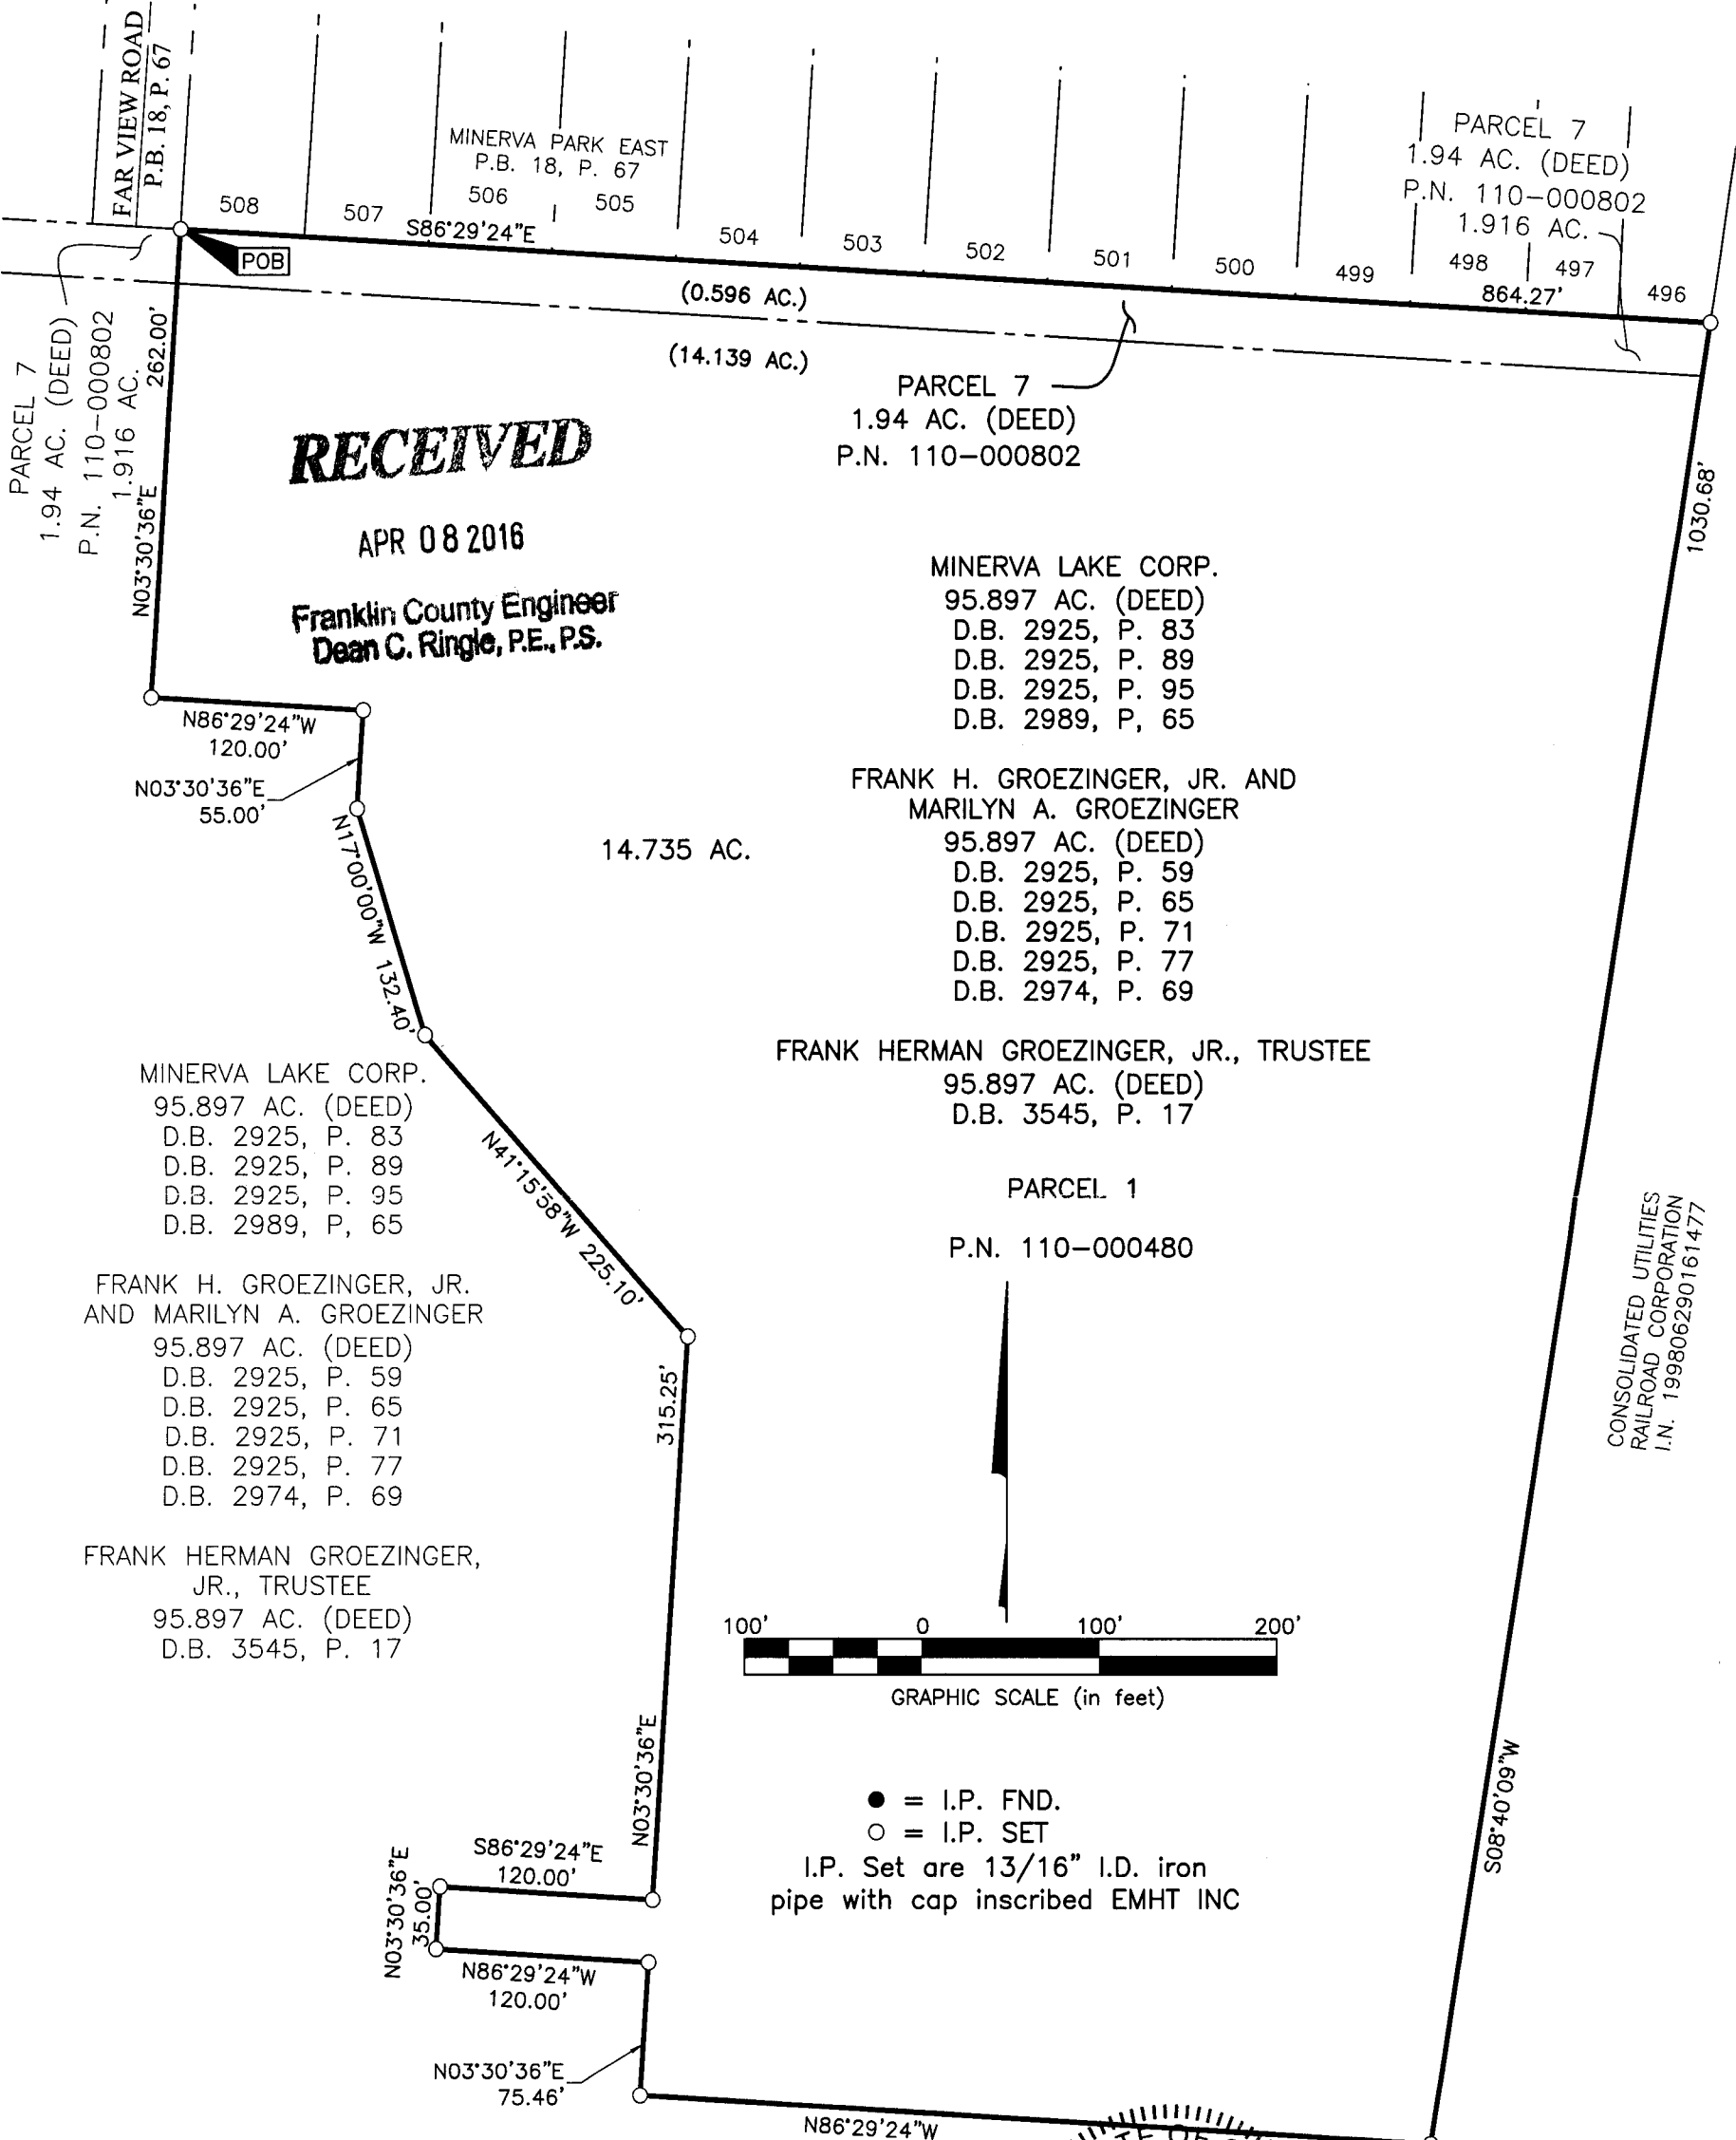

BASIS OF BEARINGS:

The bearings shown hereon are based on the Ohio State Plane Coordinate System South Zone as per NAD83 (1986). Said bearings originated from a field traverse which was tied (referenced) to said coordinate system by GPS observations of Franklin County Engineering Department monuments FRANK 85, and WEST 17. The bearing of North 86° 27' 57" West assigned to the northerly line of Waltham Place Section V (5), is designated the basis of bearings for this survey.

SURVEY NOTE:

This survey was prepared using documents of record, prior plats of survey, and observed evidence located by an actual field survey.



By Matthew A. Kirk
Matthew A. Kirk
Professional Surveyor No. 7865

7 April 16
Date