


STATE OF OHIO, COUNTY OF FRANKLIN, CITY OF GAHANNA
 QUARTER TOWNSHIP 4, TOWNSHIP 1, RANGE 17
 UNITED STATES MILITARY LANDS

RECEIVED

MAY 01 2016

Franklin County Engineer
 Dan C. Feltz, P.E., P.S.

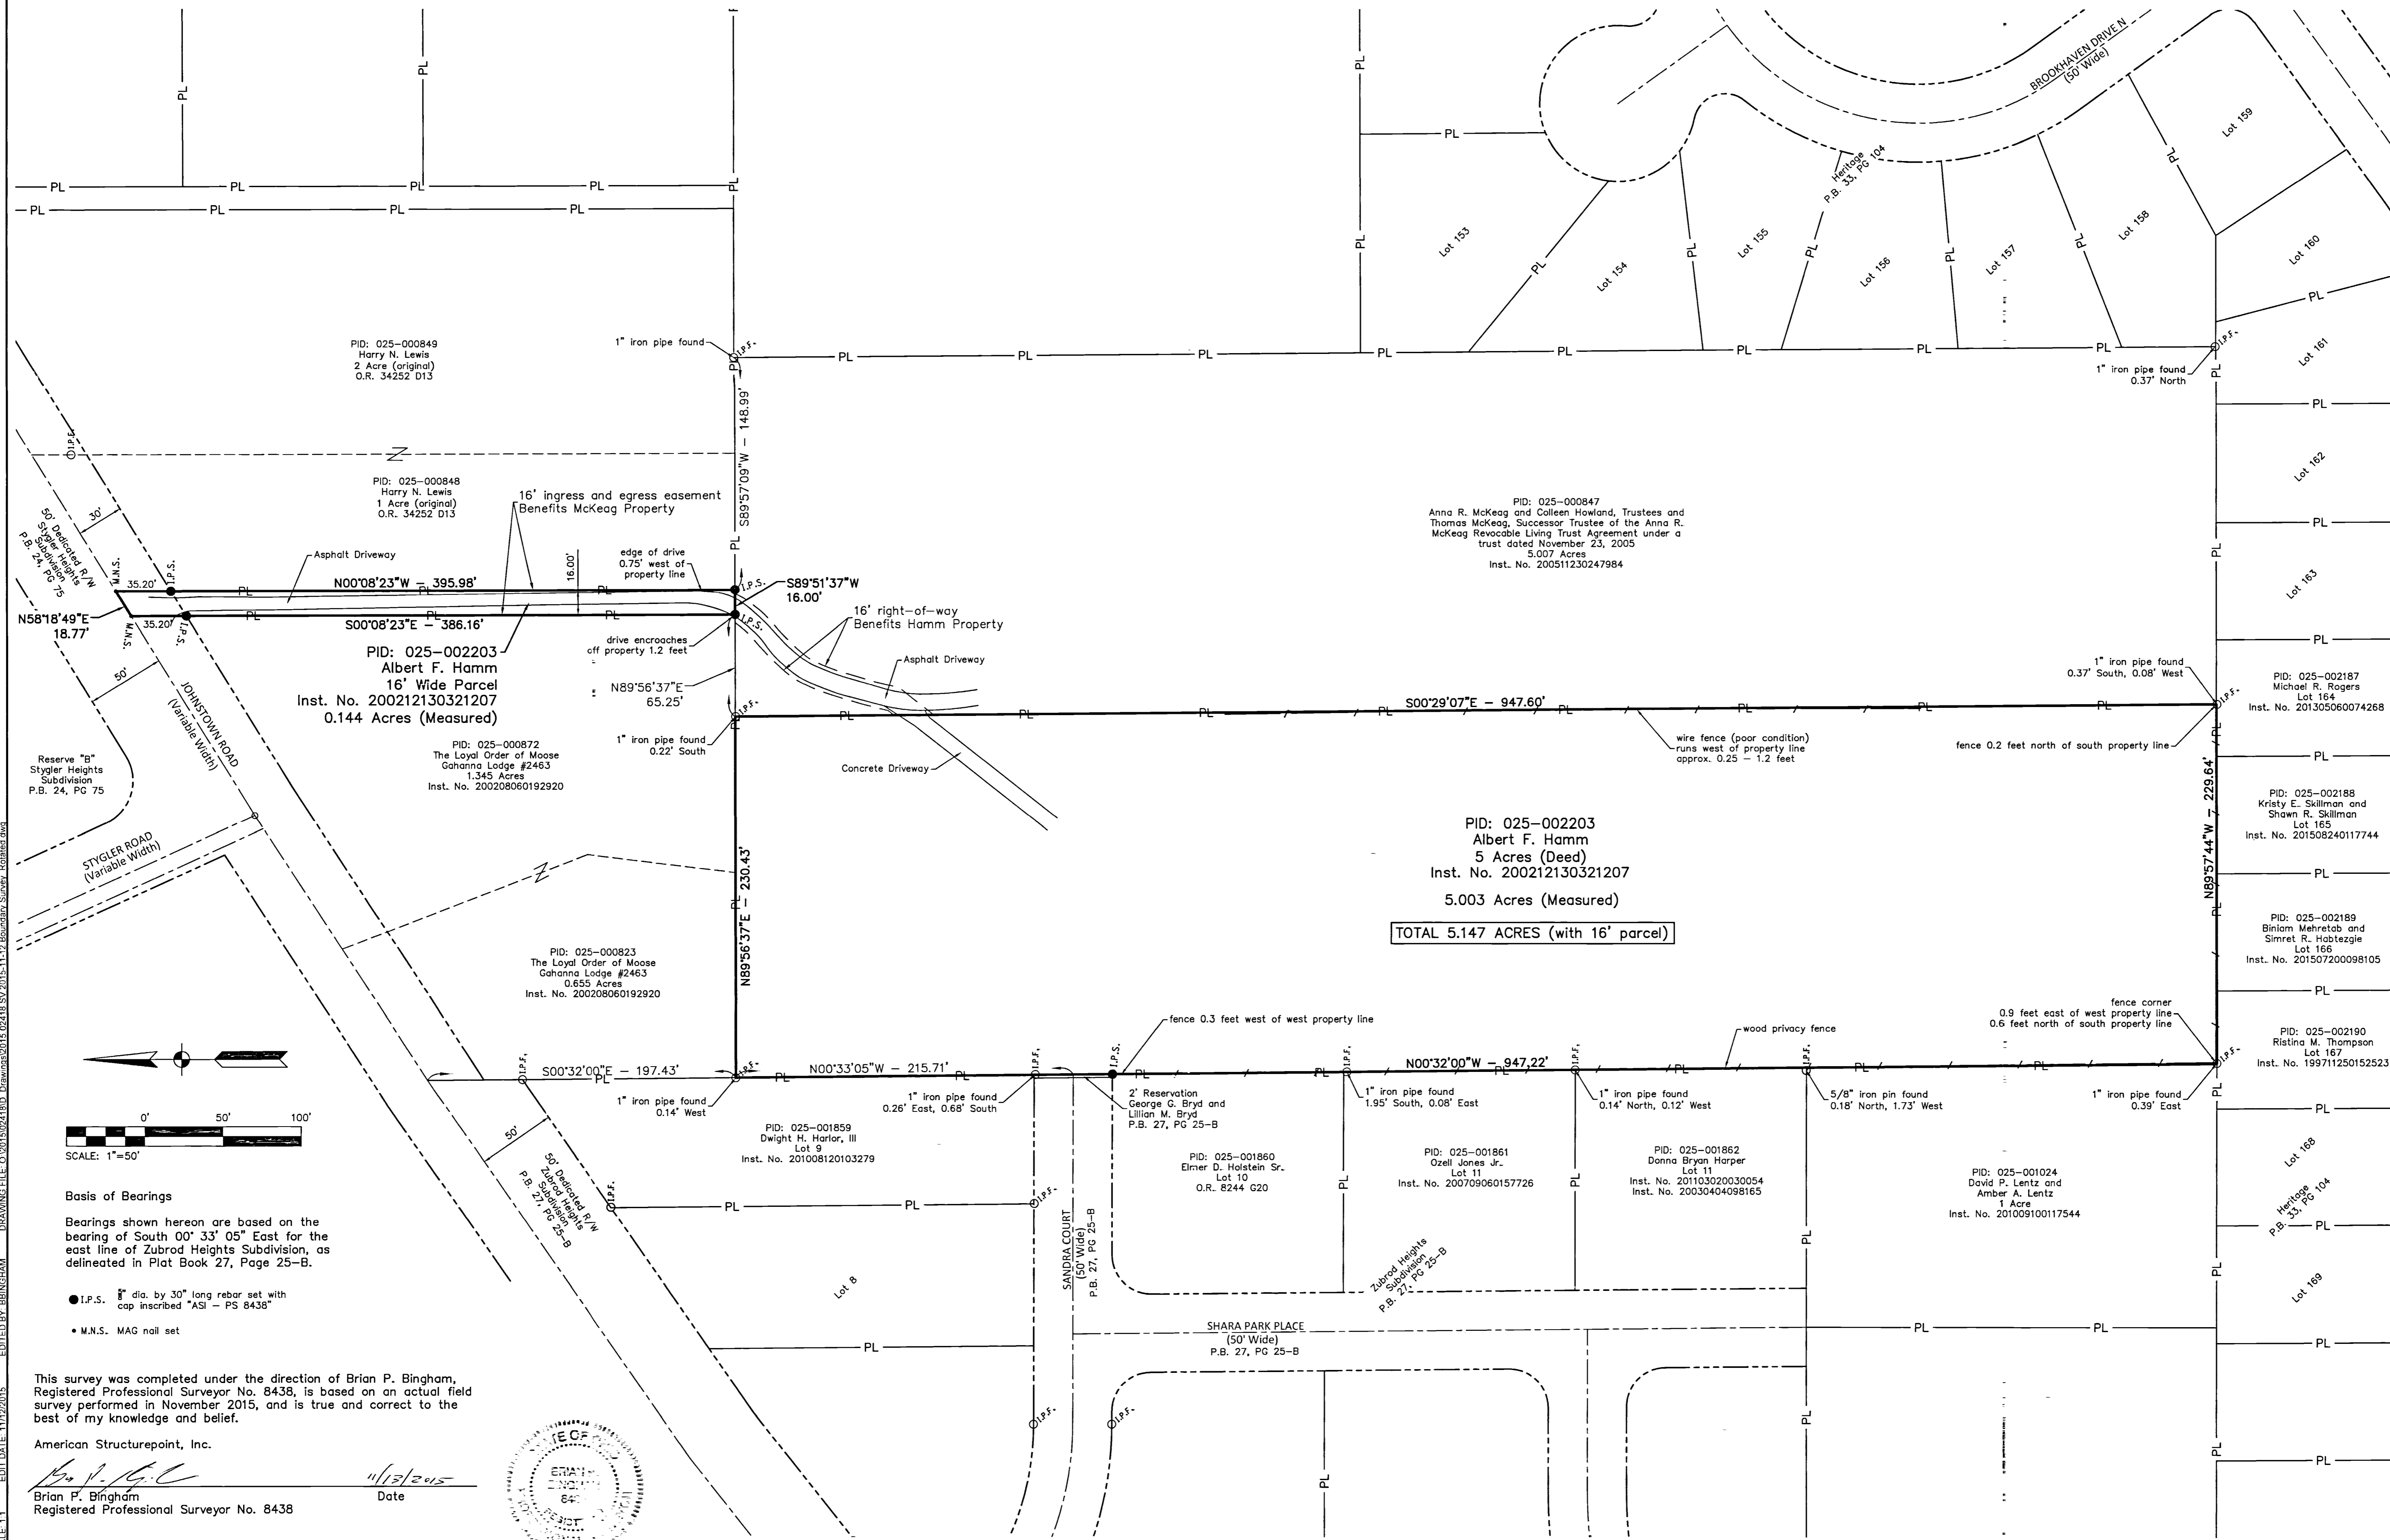

AMERICAN
STRUCTUREPOINT
 INC.
 2250 Corporate Exchange Drive | Suite 300
 Columbus, Ohio 43231
 TEL 614.901.2235 | FAX 614.901.2236
 www.structurepoint.com

Albert F. Hamm
 Boundary Survey

329 Johnstown Road
 Gahanna, Ohio

PID: 025-002187
 Michael R. Rogers
 Lot 164
 Inst. No. 201305060074268

PID: 025-002188
 Kristy E. Skillman and
 Shawn R. Skillman
 Lot 165
 Inst. No. 201508240117744

PID: 025-002189
 Binlam Mehretab and
 Simret R. Habtezigie
 Lot 166
 Inst. No. 201507200098105

PID: 025-002190
 Ristina M. Thompson
 Lot 167
 Inst. No. 199711250152523

| REVISION SCHEDULE | | |
|-------------------|-------------|------|
| NO. | DESCRIPTION | DATE |
| | | |
| | | |
| | | |
| | | |
| | | |
| | | |
| | | |
| | | |
| | | |

Project Number 2015.02418

BOUNDARY SURVEY

PLOT DATE: 11/12/2015 8:02 AM
 PLOT SCALE: 1" = 50'
 EDITED BY: BBINGHAM
 DRAWING FILE: O:\2015\02418.DWG
 DATE: 11/12/2015

This survey was completed under the direction of Brian P. Bingham, Registered Professional Surveyor No. 8438, is based on an actual field survey performed in November 2015, and is true and correct to the best of my knowledge and belief.

American Structurepoint, Inc.

Brian P. Bingham
 Brian P. Bingham
 Registered Professional Surveyor No. 8438

11/12/2015
 Date

