Plat of Survey
Guider Surveying, Inc.

State of Ohio, Franklin County
Pleasant Township, VMS 6120
Part of Lot 11 Adam Spangler's Subd.
Plat Book 3, page 65

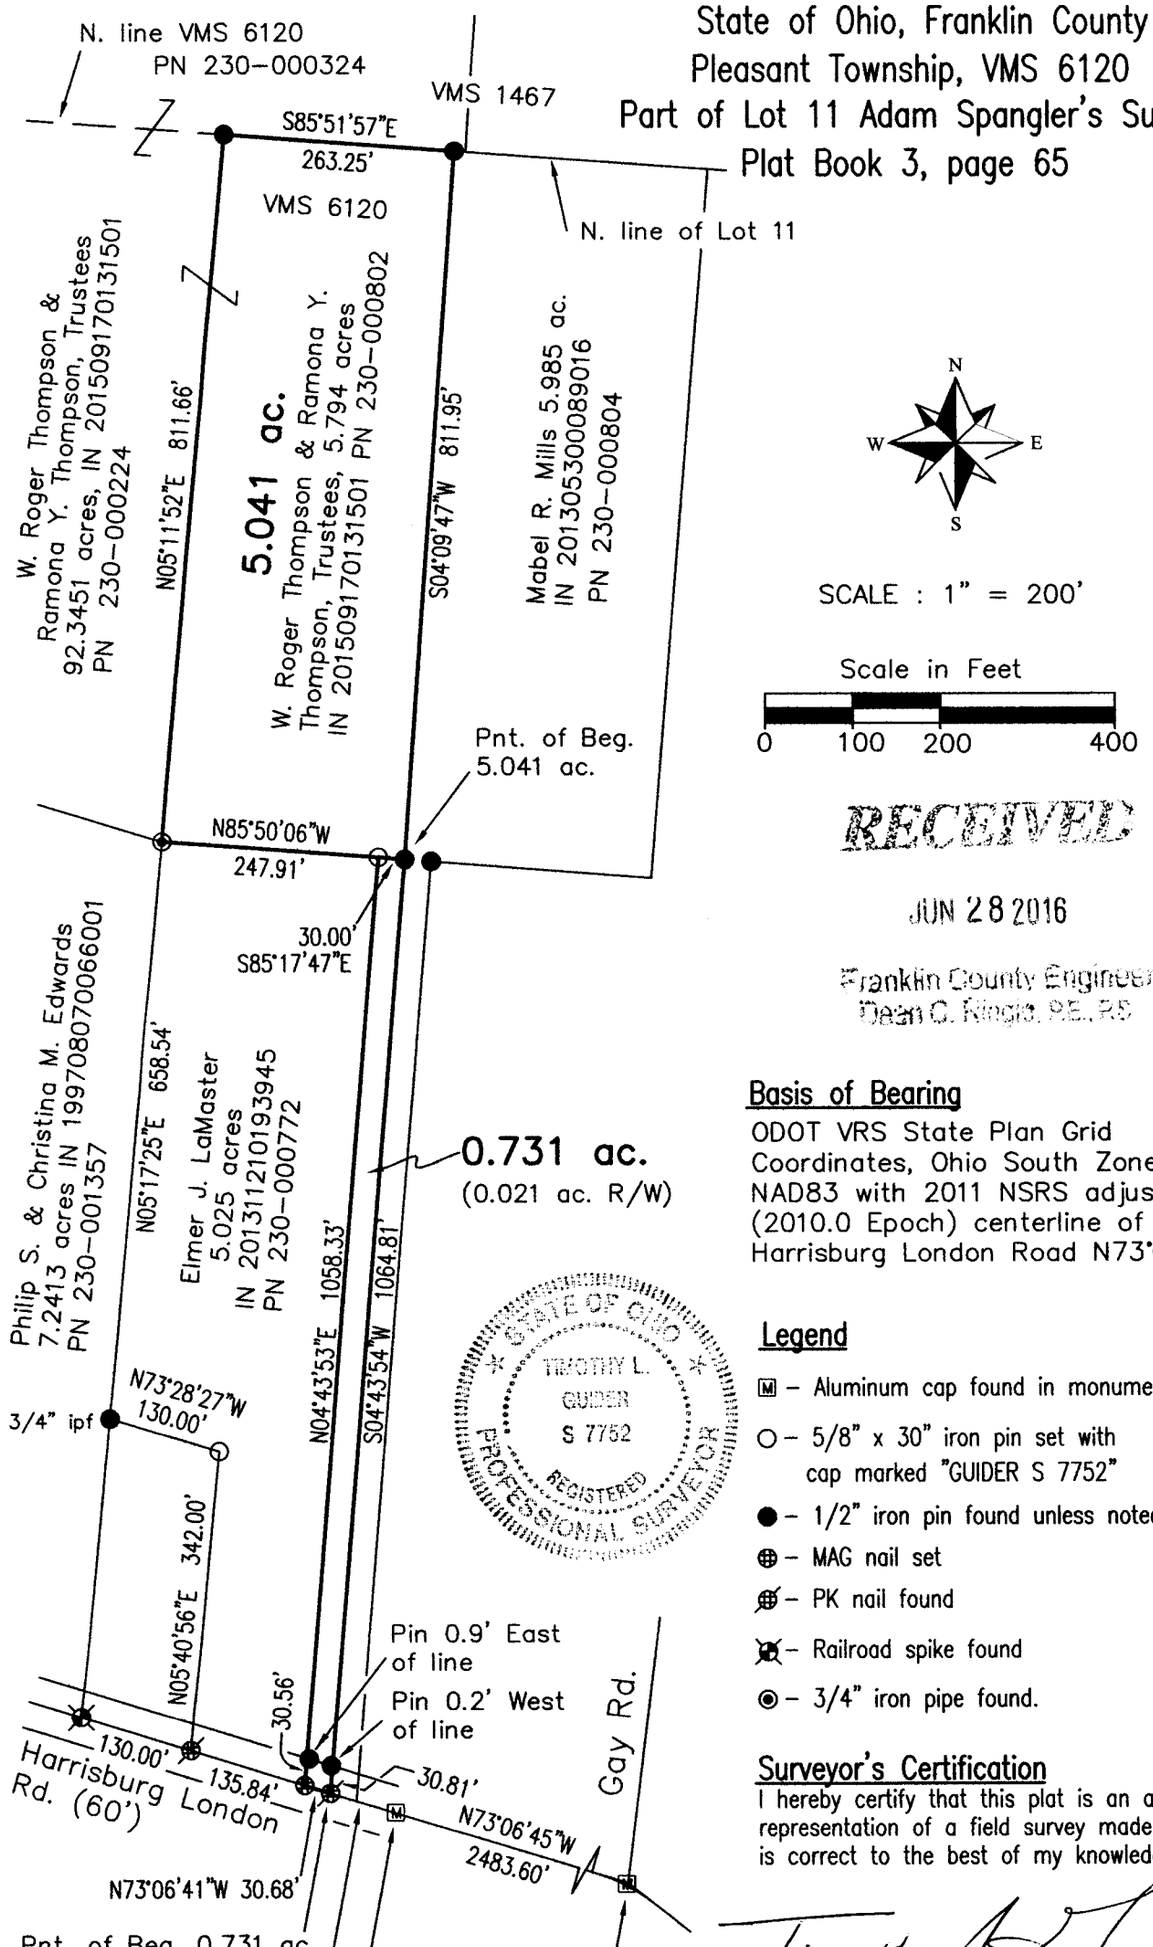

SCALE : 1" = 200'

RECEIVED

JUN 28 2016

Franklin County Engineer
Dean C. Kings, P.E., P.S.

Basis of Bearing

ODOT VRS State Plan Grid Coordinates, Ohio South Zone NAD83 with 2011 NSRS adjustment (2010.0 Epoch) centerline of Harrisburg London Road N73°06'43"W

Legend

- ▣ – Aluminum cap found in monument box found
- ○ – 5/8" x 30" iron pin set with cap marked "GUIDER S 7752"
- ● – 1/2" iron pin found unless noted otherwise
- ⊕ – MAG nail set
- ⊛ – PK nail found
- ✕ – Railroad spike found
- ◉ – 3/4" iron pipe found.

Surveyor's Certification

I hereby certify that this plat is an accurate representation of a field survey made by me and is correct to the best of my knowledge.

STATE OF OHIO
TIMOTHY L. GUIDER
S 7752
REGISTERED PROFESSIONAL SURVEYOR

Timothy L. Guider R.S. #7752 — 5/3/16 Date

Guider Surveying, Inc.
19550 Delaware County Line Road
Marysville, Ohio 43040
(740)-666-8902

Job#16054