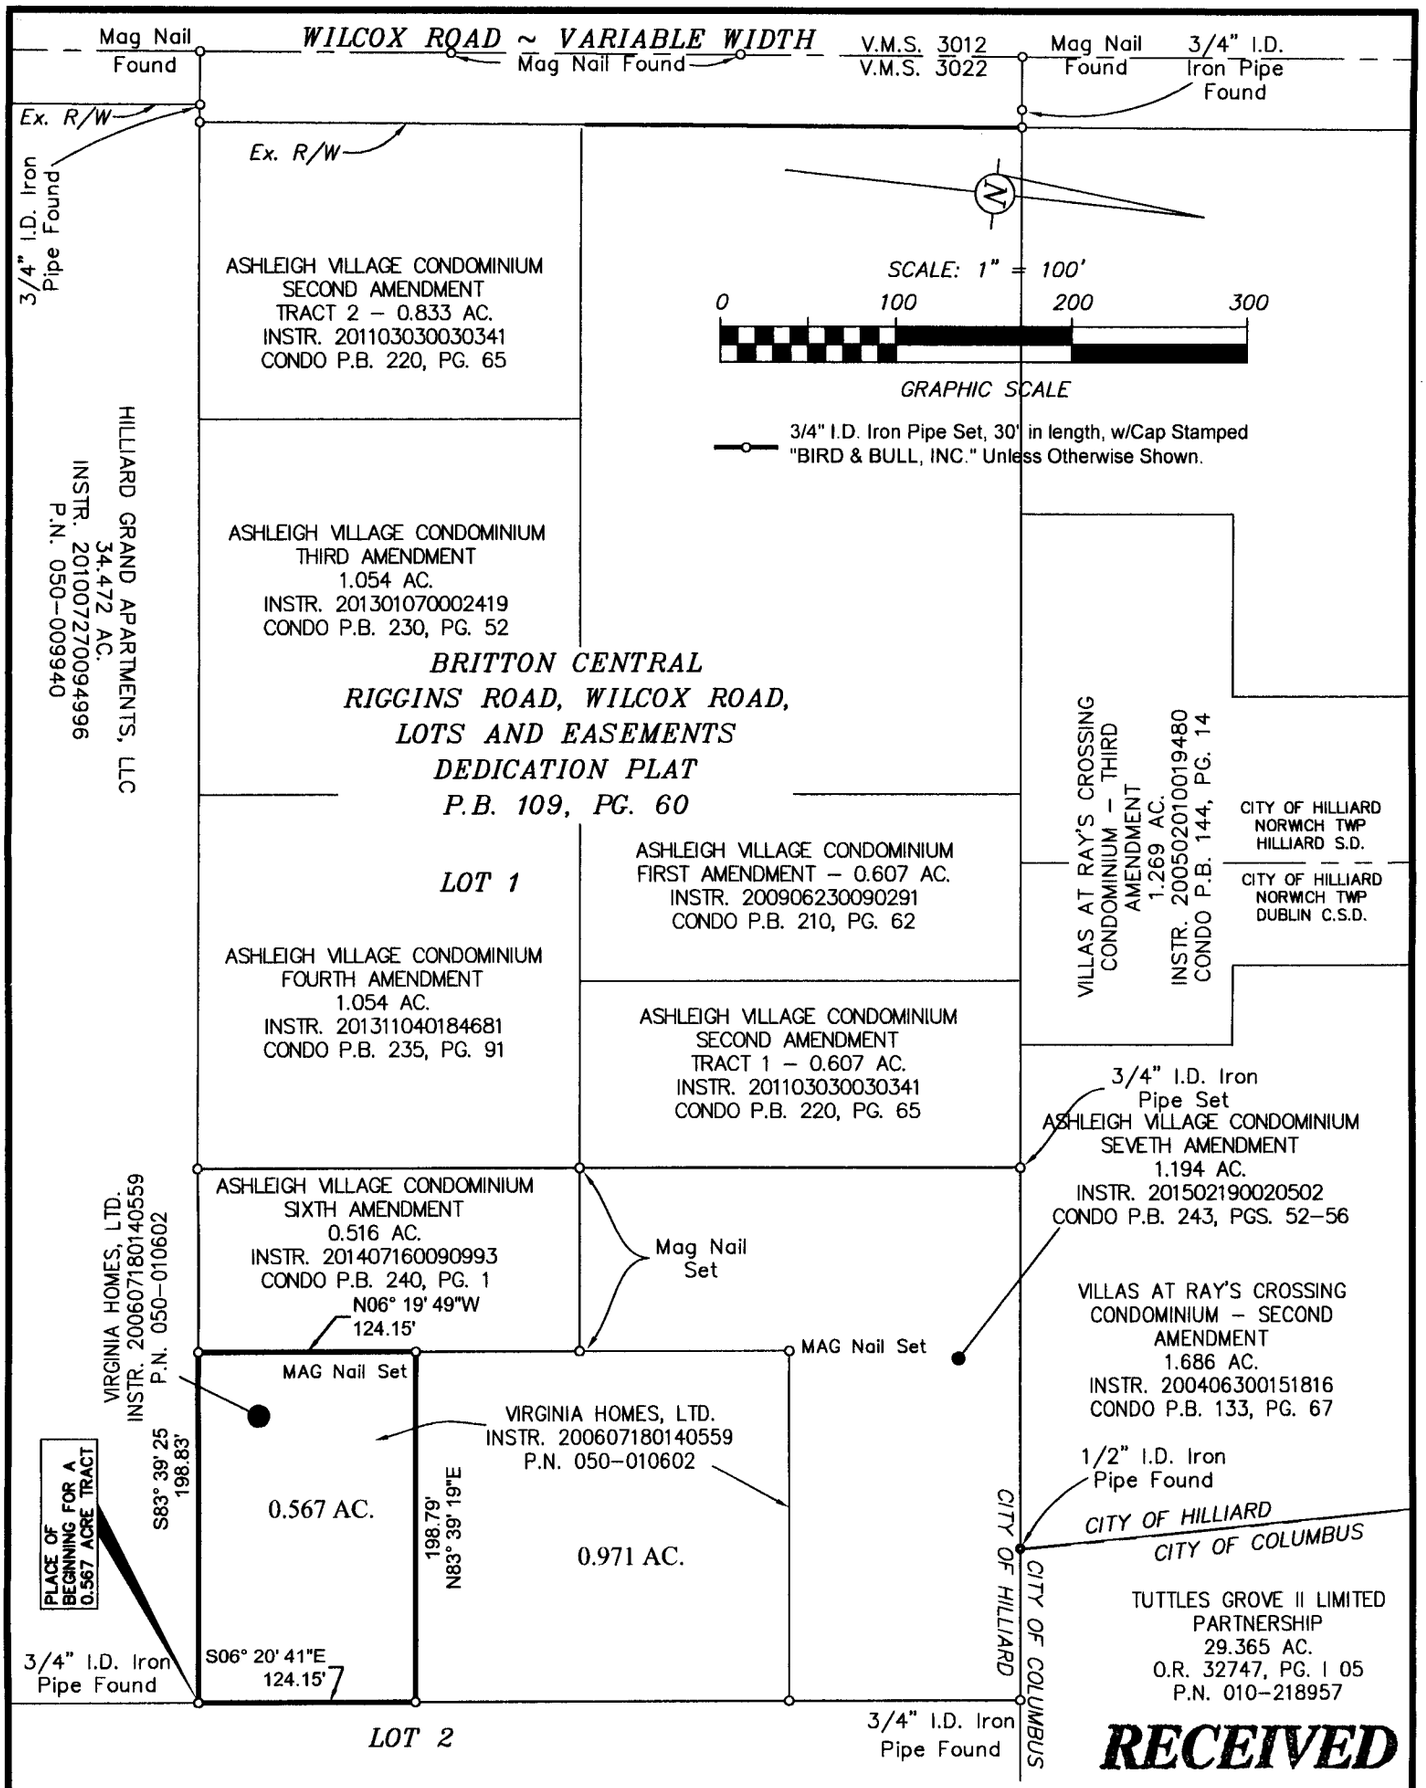

RECEIVED

SEP 19 2016

Franklin County Engineer
Dean C. Ringle, P.E., P.S.

BASIS OF BEARINGS: The Centerline of Interstate 270, being N 11° 36' 49" W as shown upon Sheet 22 of 30, Ohio Department of Transportation Right-of-Way Plans for FRA-270-3.47 N.

EXHIBIT OF A 0.567 ACRE TRACT AT ASHLEIGH VILLAGE CONDOMINIUMS ALONG WILCOX ROAD, CITY OF HILLIARD, FRANKLIN CO., OHIO

SCALE: 1" = 100'

JULY 27, 2015

Bird+Bull
2875 W. Dublin-Granville Road
Columbus, Ohio 43235
Ph: (614) 761-1661

By Kevin L. Baxter

Kevin L. Baxter ~ Ohio Surveyor No. 7697

05-022