F-8-F

EMH&T
Evans, Mechwart, Hambleton & Tilton, Inc.
Engineers • Surveyors • Planners • Scientists
5500 New Albany Road, Columbus, OH 43054
Phone: 614.775.4500 Toll Free: 888.775.3648
emht.com

SURVEY OF ACREAGE PARCEL

SECTION 9, TOWNSHIP 5, RANGE 22
REFUGEE LANDS
CITY OF COLUMBUS, COUNTY OF FRANKLIN, STATE OF OHIO

Date:	August 11, 2016
Scale:	1" = 20'
Job No:	2016-0932

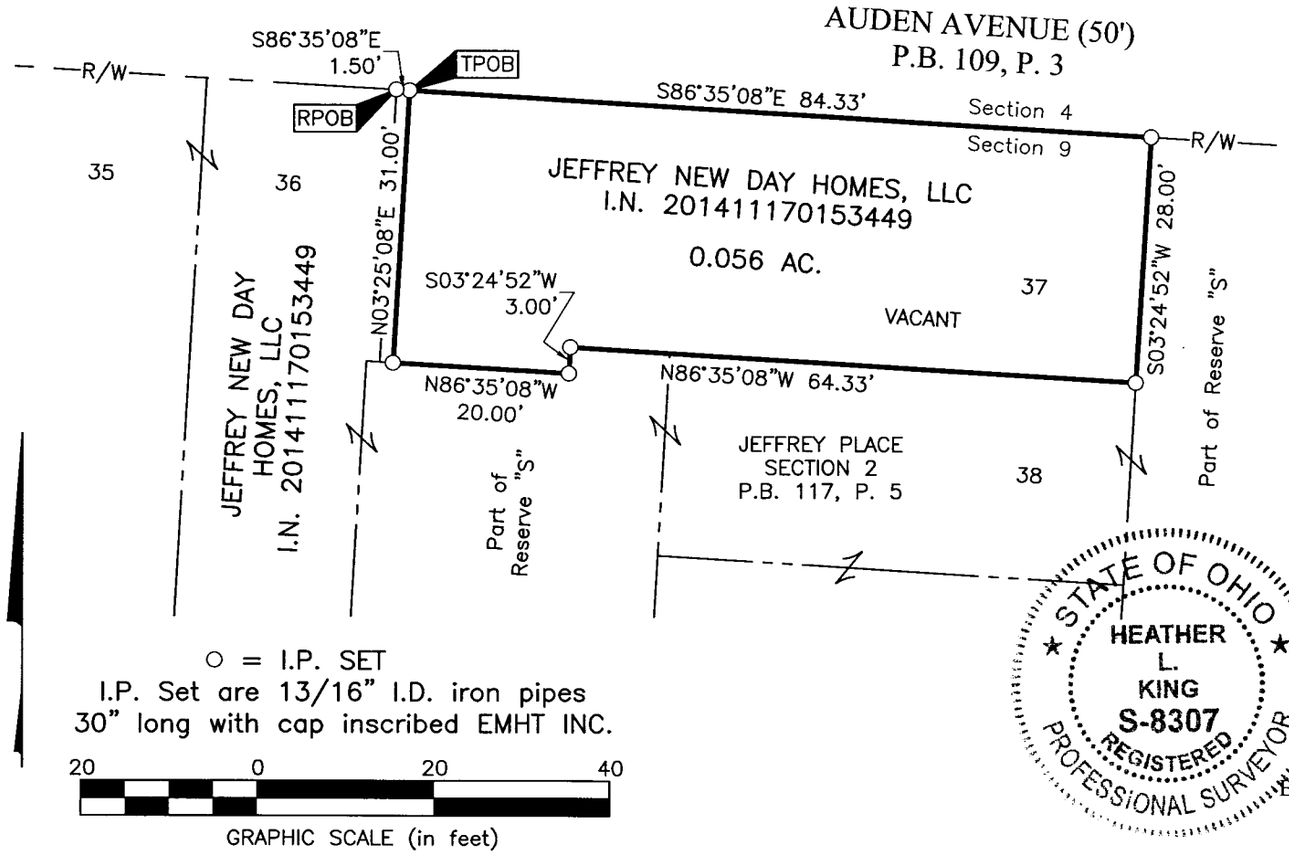

BASIS OF BEARINGS:
The Bearings shown hereon are based on the southerly right-of-way line of Auden Avenue having a bearing of South 86° 35' 08" East, as delineated on the plat entitled "Jeffrey Place Section 2", of record in Plat Book 117, Page 5, Recorder's Office, Franklin County, Ohio.

SURVEY NOTE:
This survey was prepared using documents of record, prior plats of survey, and observed evidence located by an actual field survey completed by EMH&T in December 2012.

FEMA NOTE:
The subject tract is located within the area indicated on Federal Emergency Management Agency's Flood Insurance Rate Map No. 39049C0326K. Per Map Index No. 39049CIND2D (dated June 16, 2011), the panel was note printed due to no special flood hazard areas.

STATE OF OHIO
HEATHER L. KING
S-8307
REGISTERED
PROFESSIONAL SURVEYOR

By _____ 8/30/16
Heather L. King Date
Professional Surveyor No. 8307

RECEIVED
SEP 20 2016
Franklin County Engineer
Dean C. Ringle, P.E., P.S.

J:\20160932\DWG\04SHEETS\BOUNDARY\20160932-VS-BNDY-02.DWG plotted by KING, HEATHER on 9/16/2016 9:45:36 AM last saved by HKING on 9/16/2016 9:45:23 AM
Xrefs: