


Boundary Survey


Section 14, Township 4, Range 22, Congress Lands East of Scioto River
City of Columbus, Franklin County, Ohio

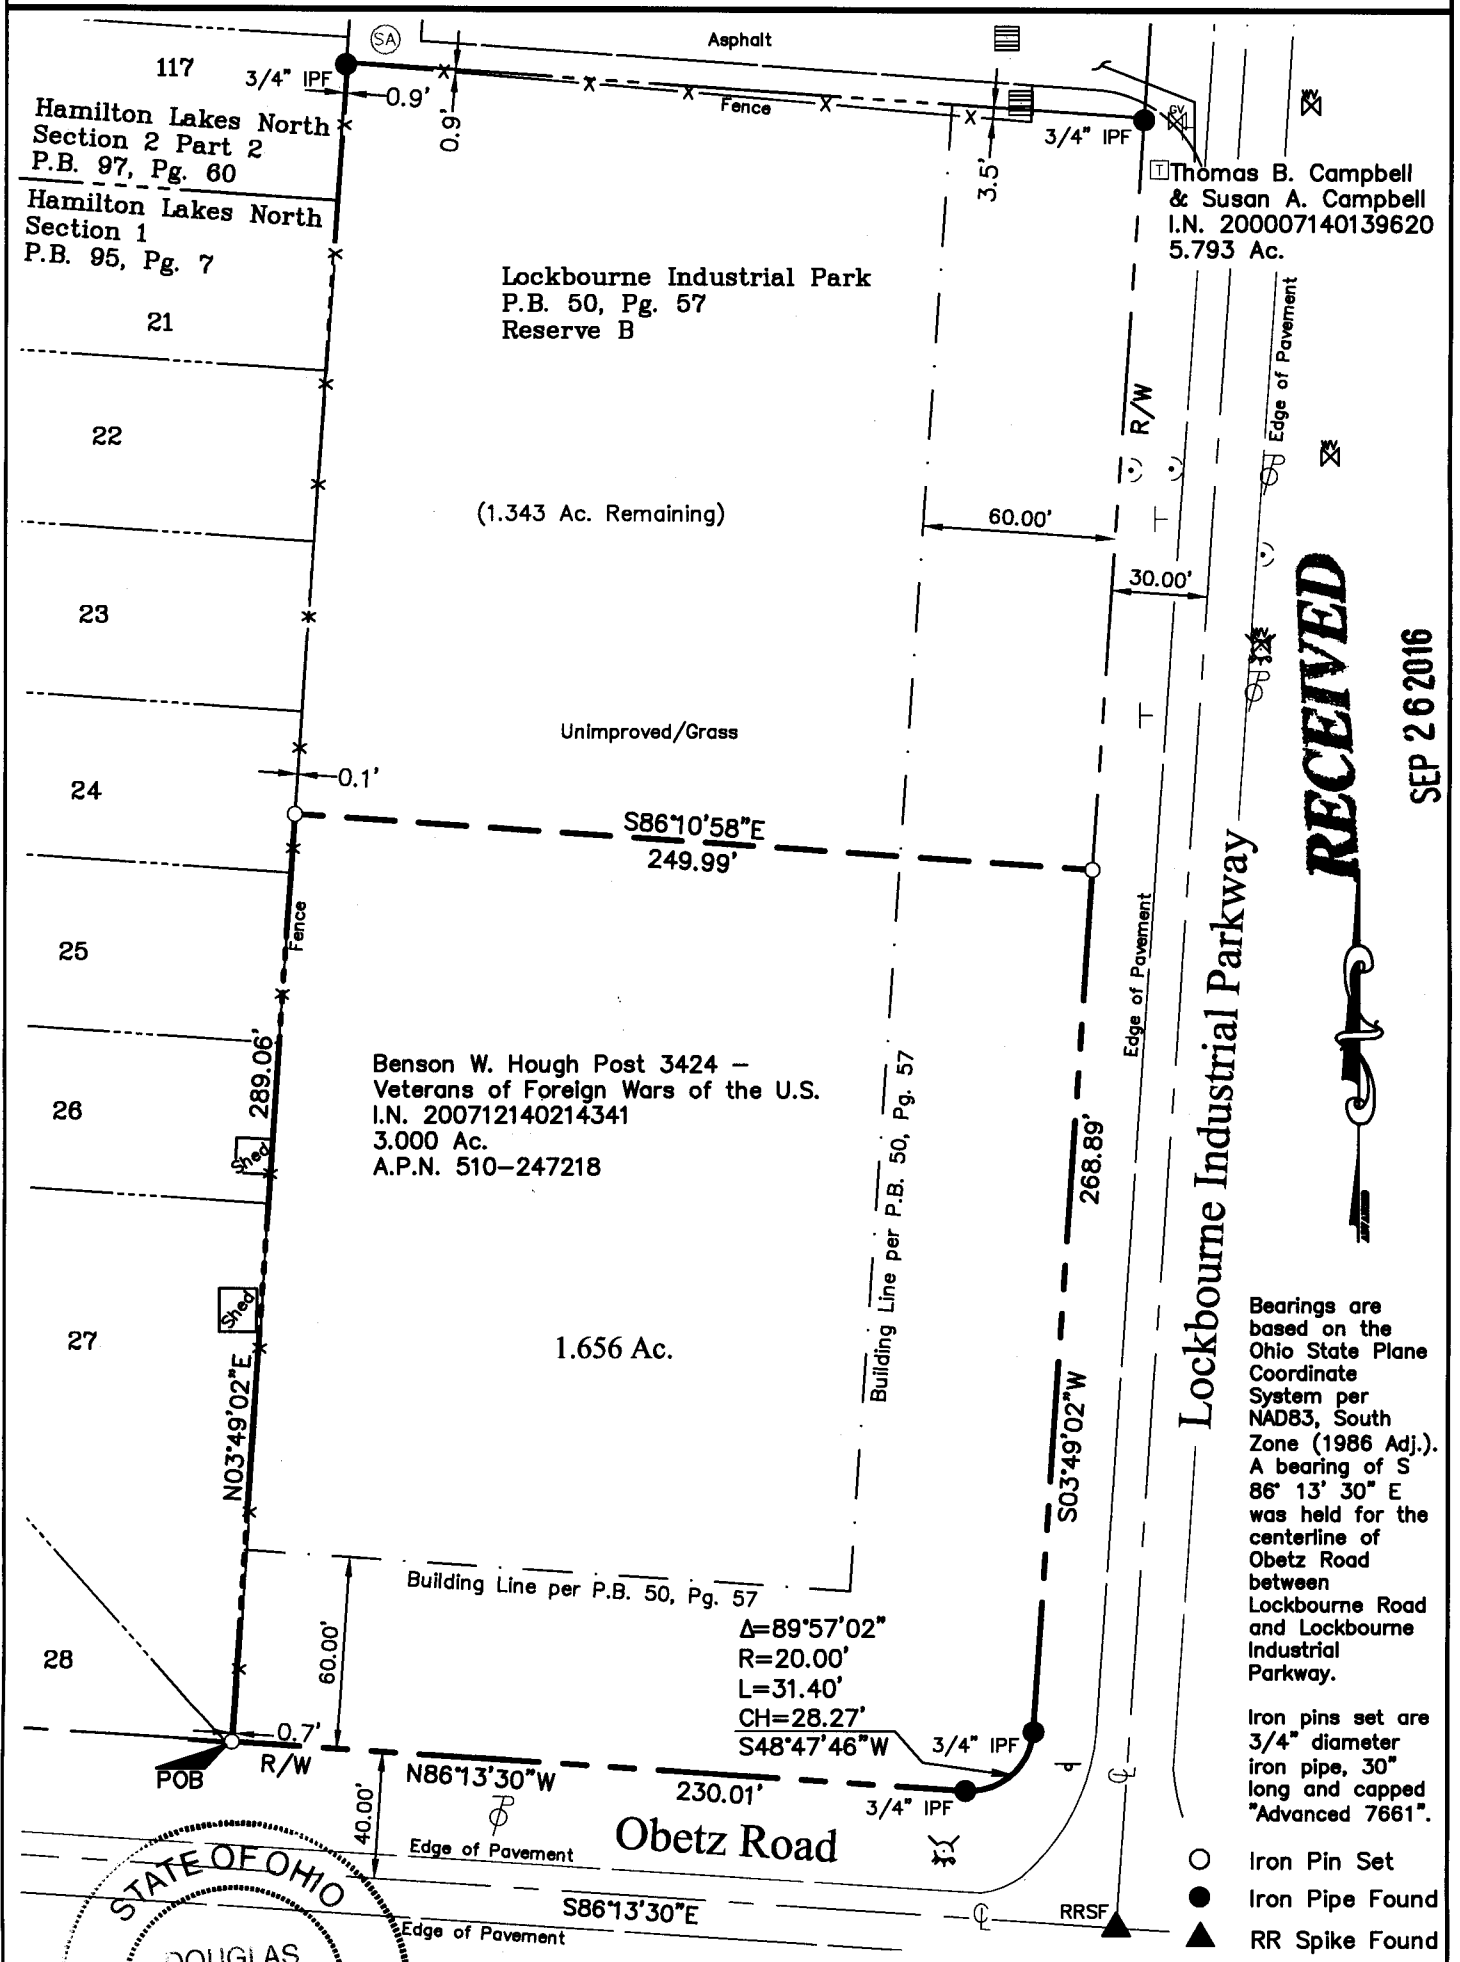

STATE OF OHIO
DOUGLAS R. HOCK
S-7661
REGISTERED PROFESSIONAL SURVEYOR

9/26/16

Douglas R. Hock, S.S. 7661

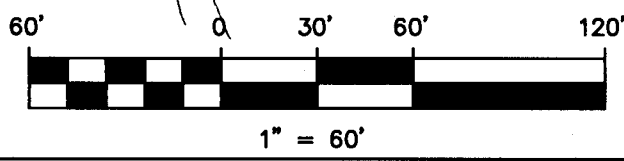

DRAWN BY: JCD/DRB JOB NO.: 08-0002-216
DATE: 09/26/2016 CHECKED BY: DRH

ADVANCED
CIVIL DESIGN
ENGINEERS SURVEYORS

422 Beecher Road
Gahanna, Ohio 43230
ph 614.428.7750
fax 614.428.7755