

Parcel Exhibit ~ 1.780 Ac.  
City of Gahanna, County of Franklin, State of Ohio  
Southwest Quarter of Section 1, Township 1, Range 17  
United States Military District


RECEIVED

APR 25 2017

LEGEND

- Iron Pin Set
- ⊗ P.K. Nail Set
- ⊗ P.K. Nail Found
- Iron Pipe Found
- Iron Pin Found

LINE TABLE		
LINE	BEARING	DISTANCE
L1	N86°19'15"W	162.00'
L2	N03°59'55"E	20.00'
L3	N86°19'15"W	38.00'

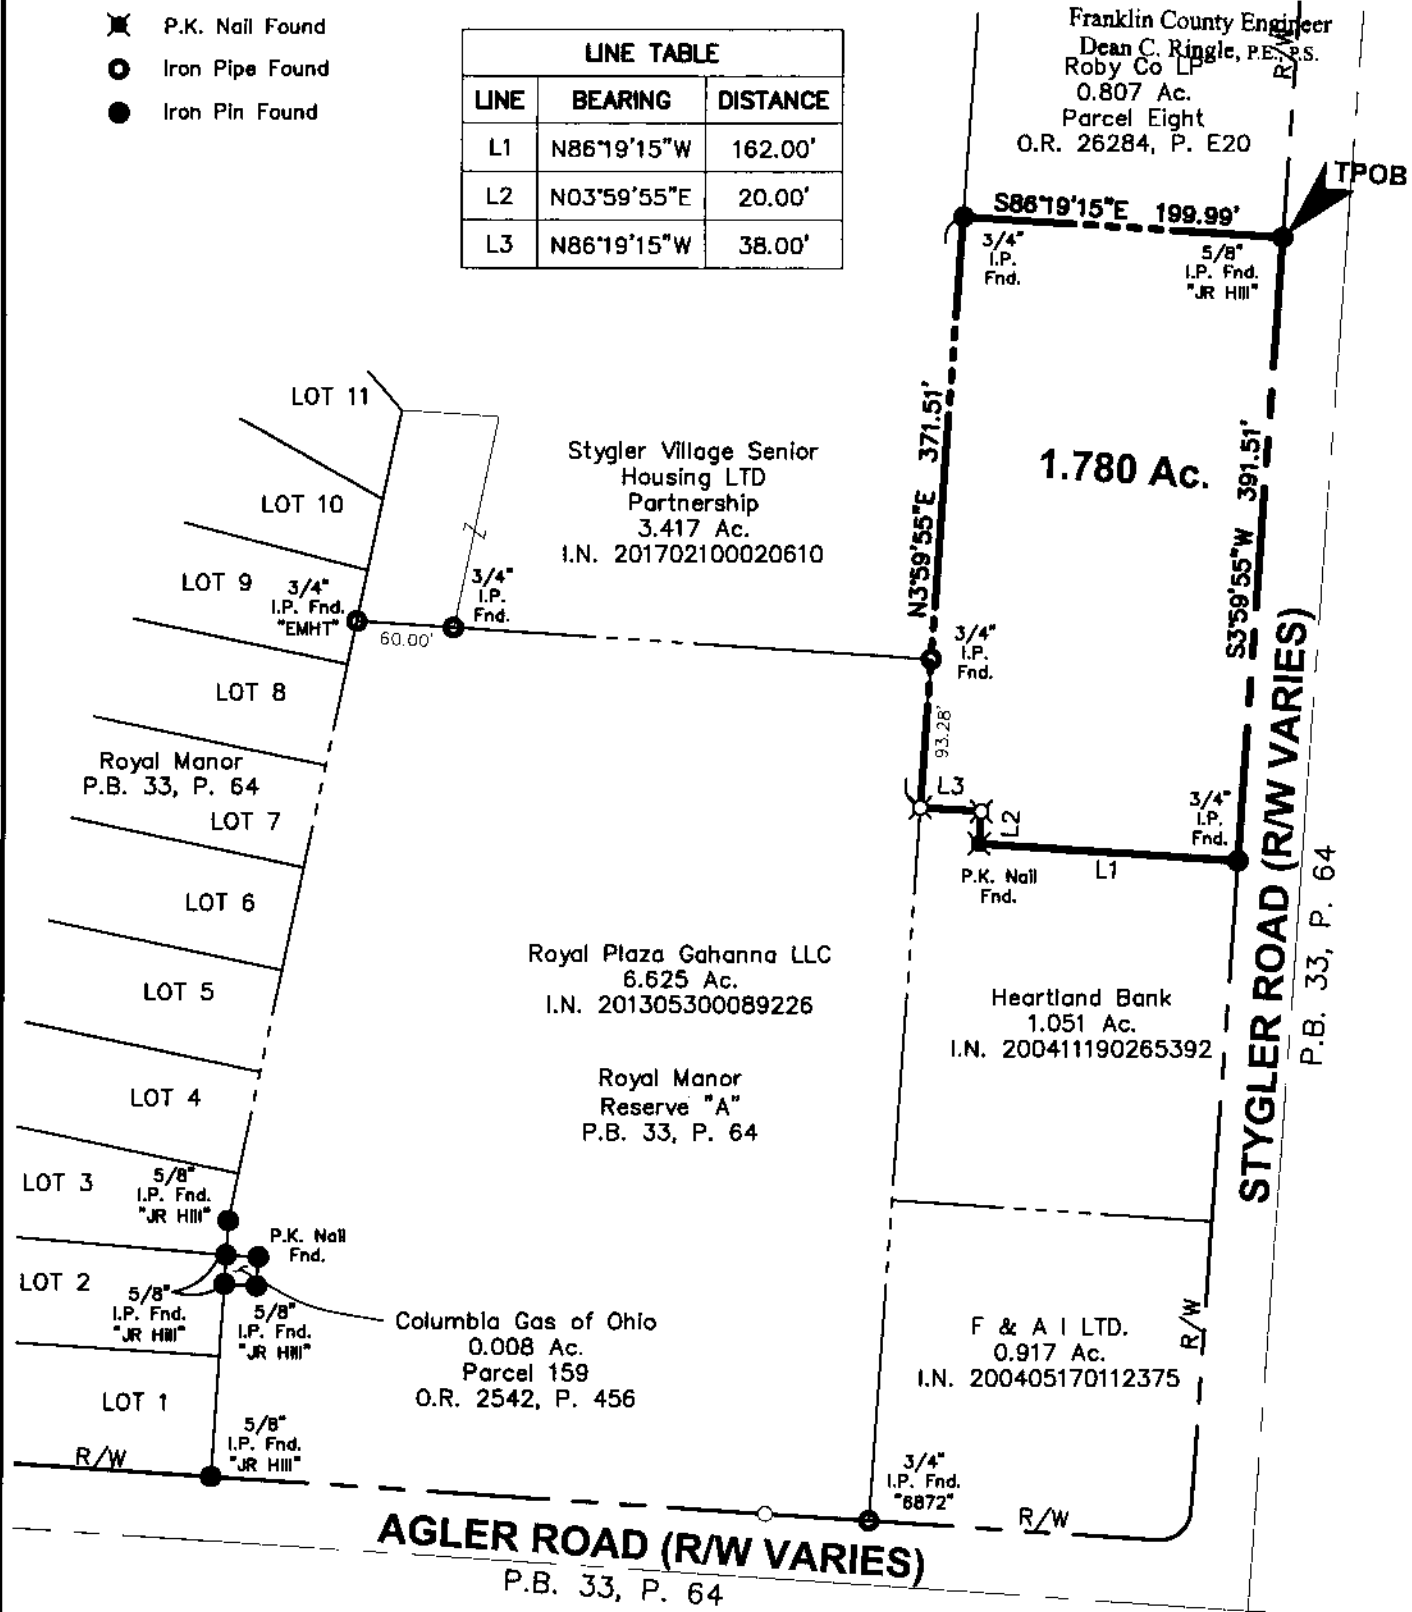


Z:\17-0003-622\DWG\PRODUCTION DRAWINGS\SURVEY\0003-622 lot split2.dwg Page 1 Apr 25, 2017 9:40:15am bkarshner

Bearings are based on the Ohio State Plane Coordinate System South Zone, NAD83 (NSRS 2007) as derived from GPS observation. A bearing of S 03° 59' 55" W was held for the westerly right-of-way line of Stygler Road between a 3/4" iron pin found and a 5/8" iron pin found.

This survey is based on existing records and an actual field survey performed in April 2017.

Iron pins set are 3/4" diameter iron pipes, 30" long and capped "Advanced 7661".

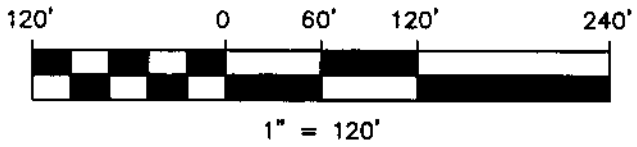

DRAWN BY: BCK	JOB NO.: 17-0003-622
DATE: 4/25/2017	CHECKED BY: DRB

*Douglas R. Hock*  
 Douglas R. Hock, P.S. 7661  
 Date: 4/25/17

**ADVANCED CIVIL DESIGN**  
 ENGINEERS SURVEYORS

422 Beecher Road  
 Gahanna, Ohio 43230  
 ph 614.428.7750  
 fax 614.428.7755