



ALKIRE ROAD

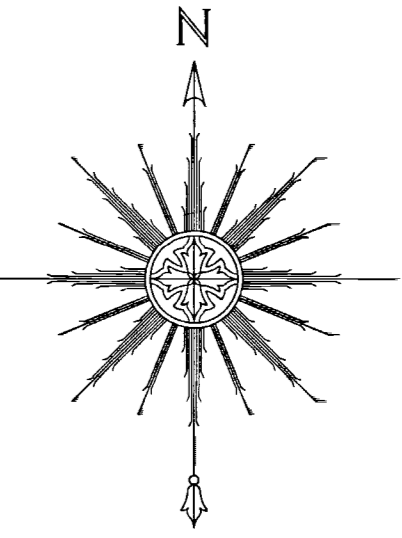

RW SURVEY, LLC
614-795-3544
5788 BURKE CIRCLE
NEW ALBANY, OHIO 43054
FAX 614-245-8669
WWW.RWSURVEY.BIZ

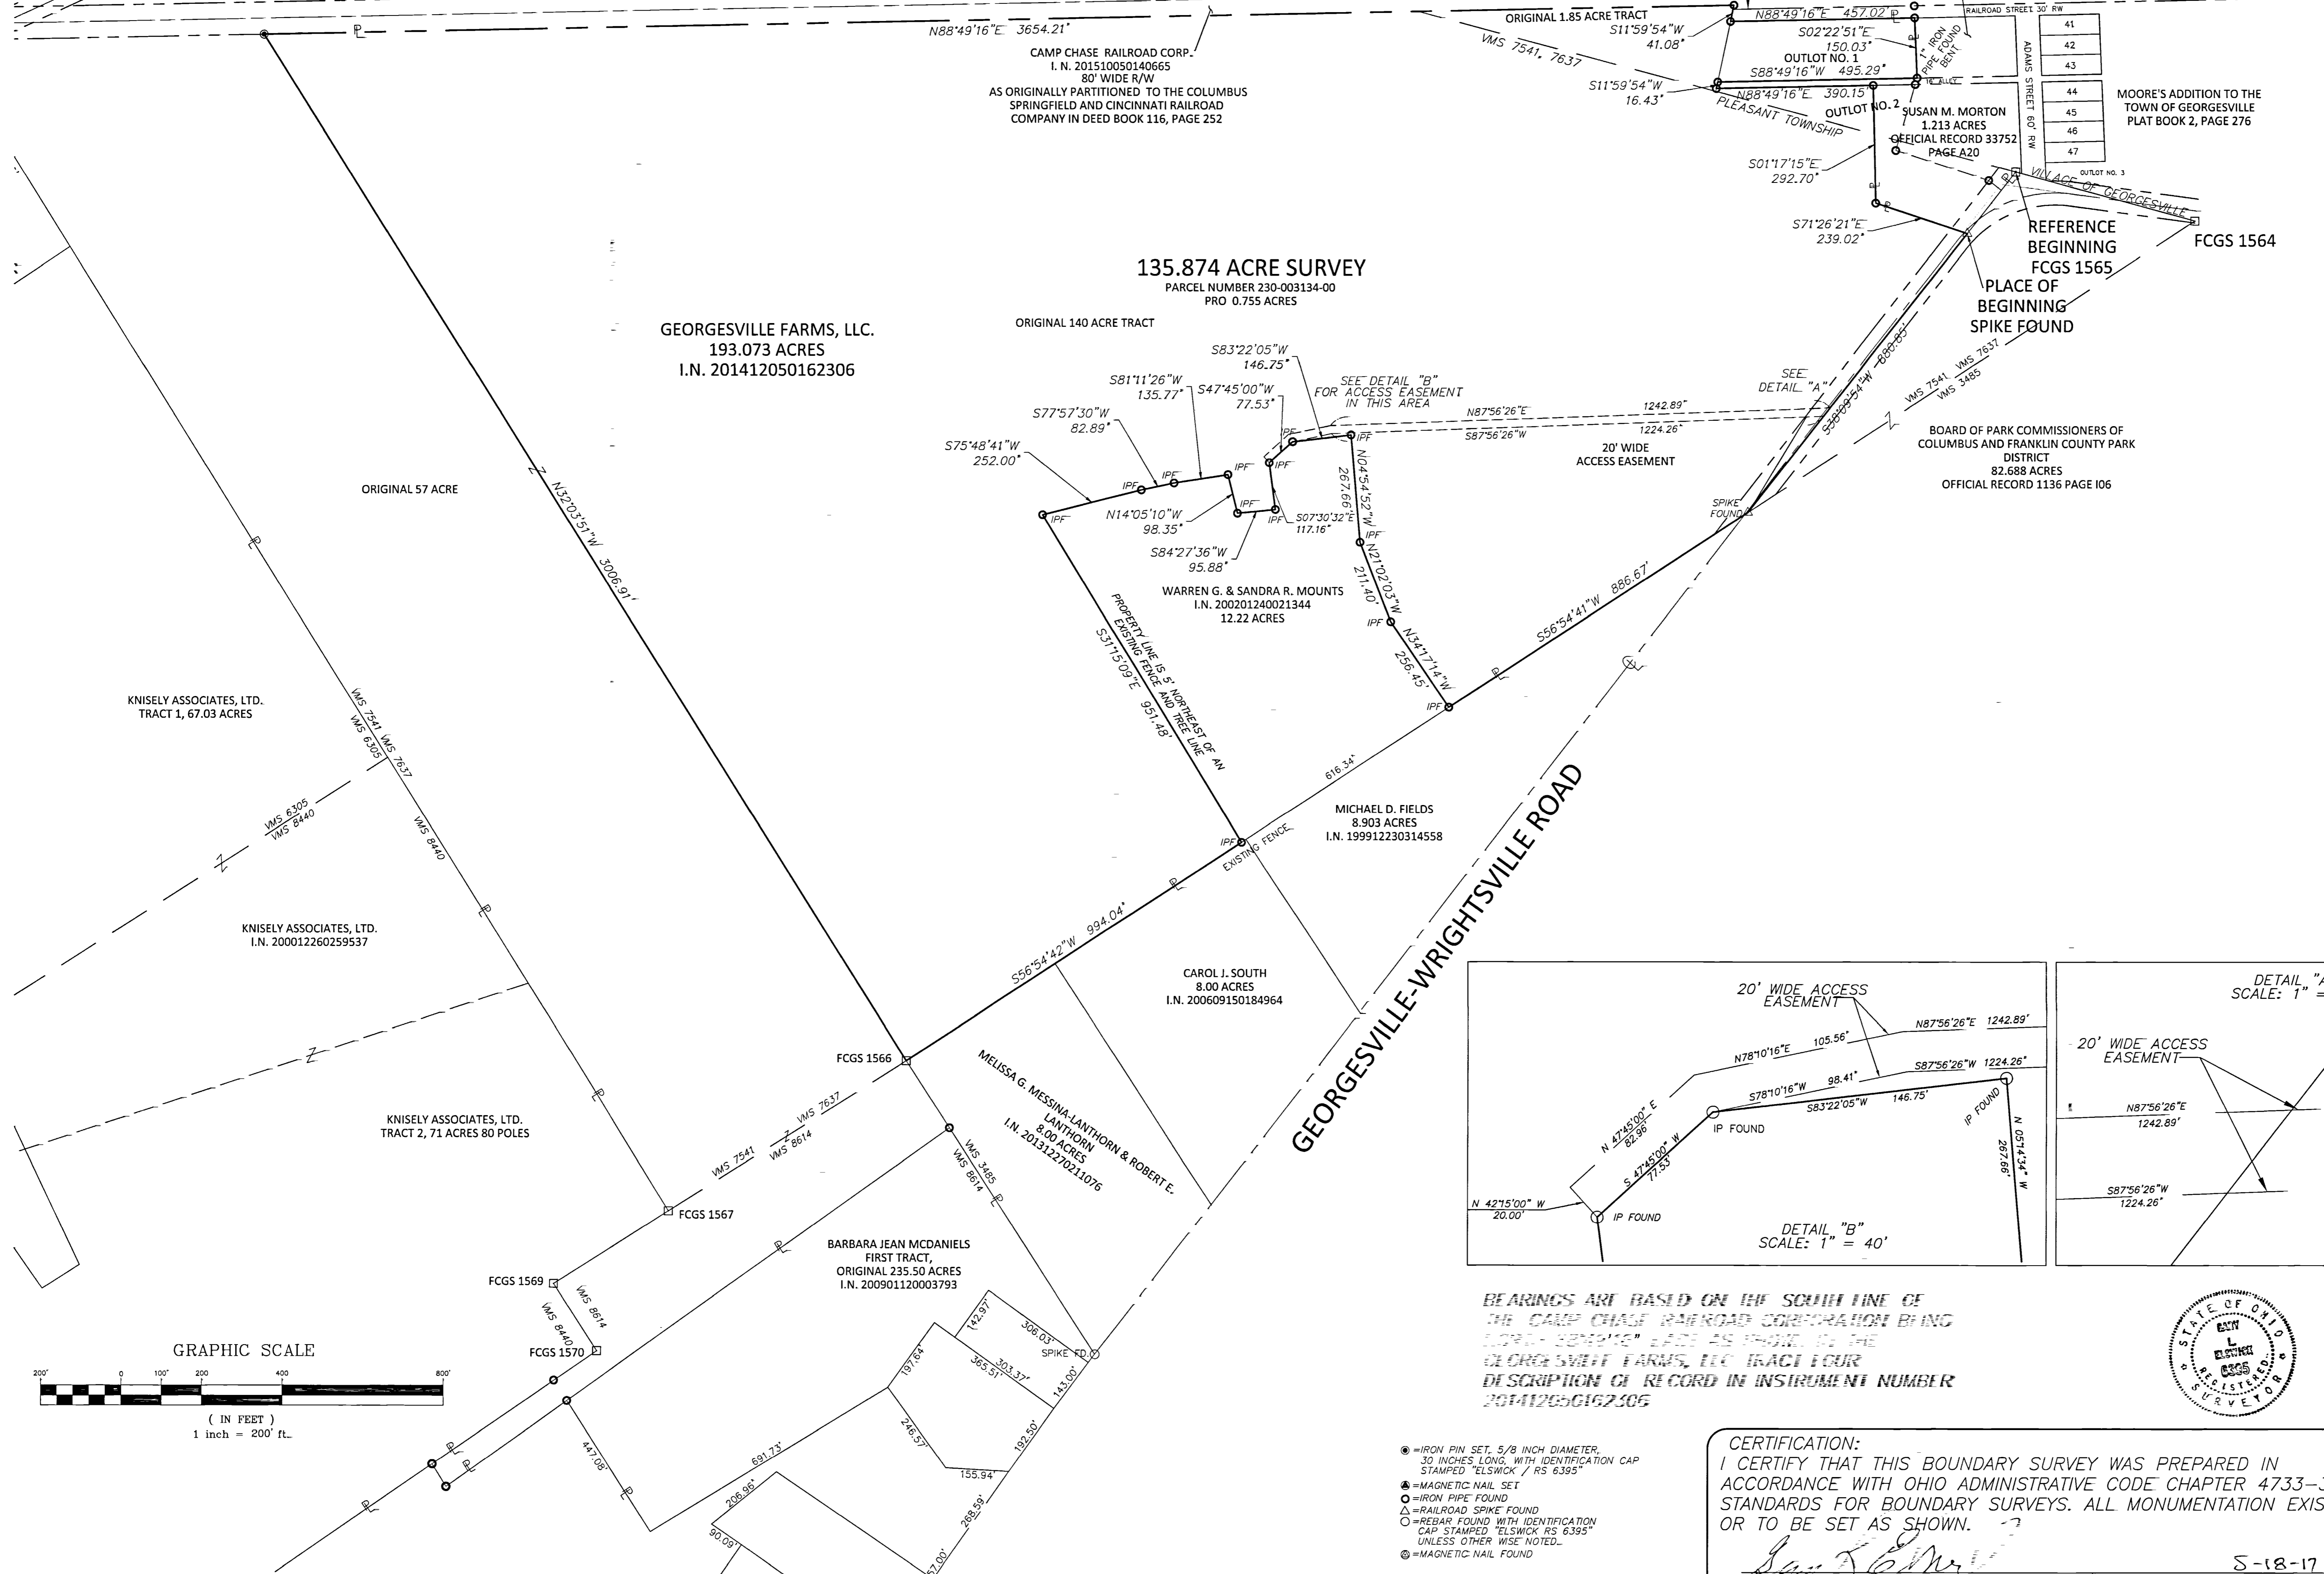

135.874 ACRE SURVEY
PARCEL NUMBER 230-003134-00
PRO 0.755 ACRES

GEORGESVILLE FARMS, LLC.
193.073 ACRES
I.N. 201412050162306

ORIGINAL 140 ACRE TRACT

KNISELY ASSOCIATES, LTD.
TRACT 1, 67.03 ACRES

KNISELY ASSOCIATES, LTD.
I.N. 200012260259537

KNISELY ASSOCIATES, LTD.
TRACT 2, 71 ACRES 80 POLES

BARBARA JEAN MCDANIELS
FIRST TRACT,
ORIGINAL 235.50 ACRES
I.N. 200901120003793

CAROL J. SOUTH
8.00 ACRES
I.N. 200609150184964

MICHAEL D. FIELDS
8.903 ACRES
I.N. 199912230314558

MELISSA G. MESSINA-LANTHORN & ROBERT E. LANTHORN
800 ACRES
I.N. 201312270211076




BROWN ADAMS REAL ESTATE LLC
0.861 ACRES
INSTRUMENT NUMBER
200706250109980

MOORE'S ADDITION TO THE
TOWN OF GEORGESVILLE
PLAT BOOK 2, PAGE 276

REFERENCE
BEGINNING
FCGS 1565
PLACE OF
BEGINNING
SPIKE FOUND

BOARD OF PARK COMMISSIONERS OF
COLUMBUS AND FRANKLIN COUNTY PARK
DISTRICT
82.688 ACRES
OFFICIAL RECORD 1136 PAGE 106

MAY 18 2017

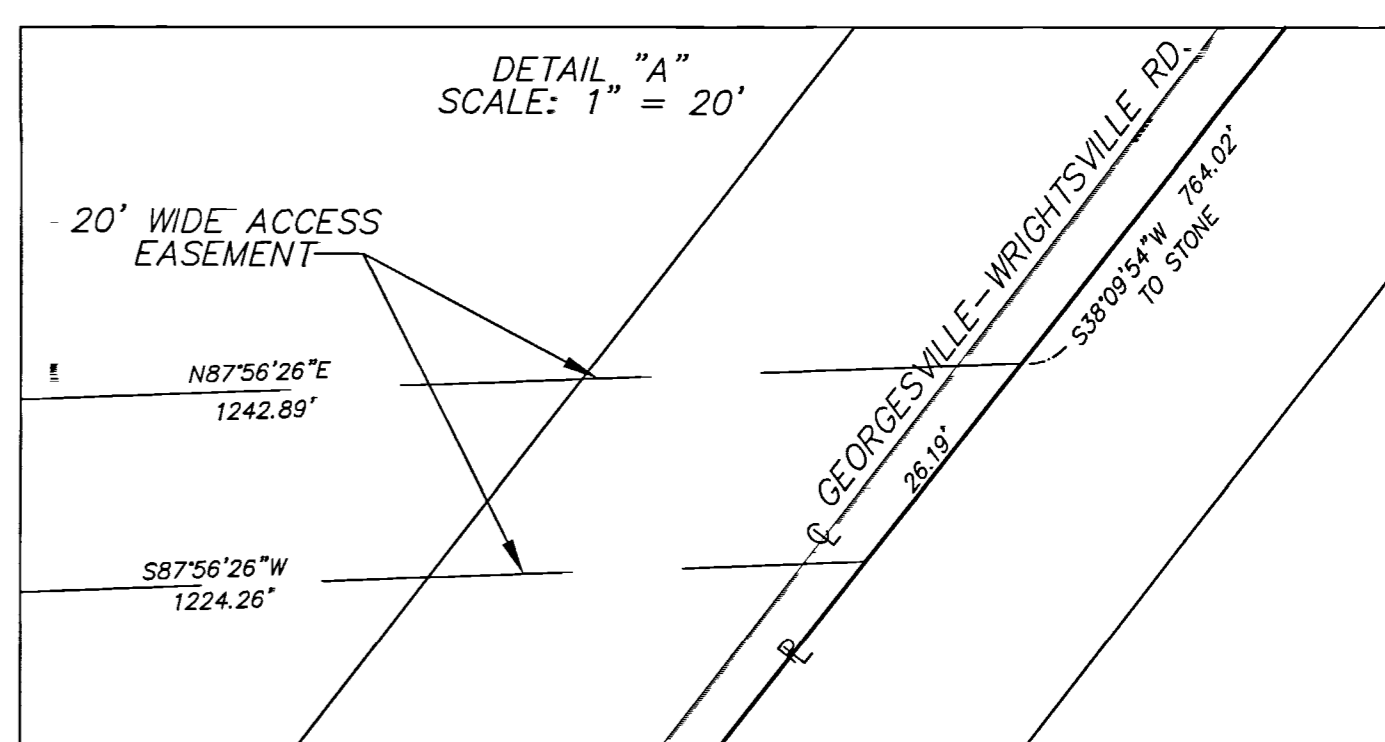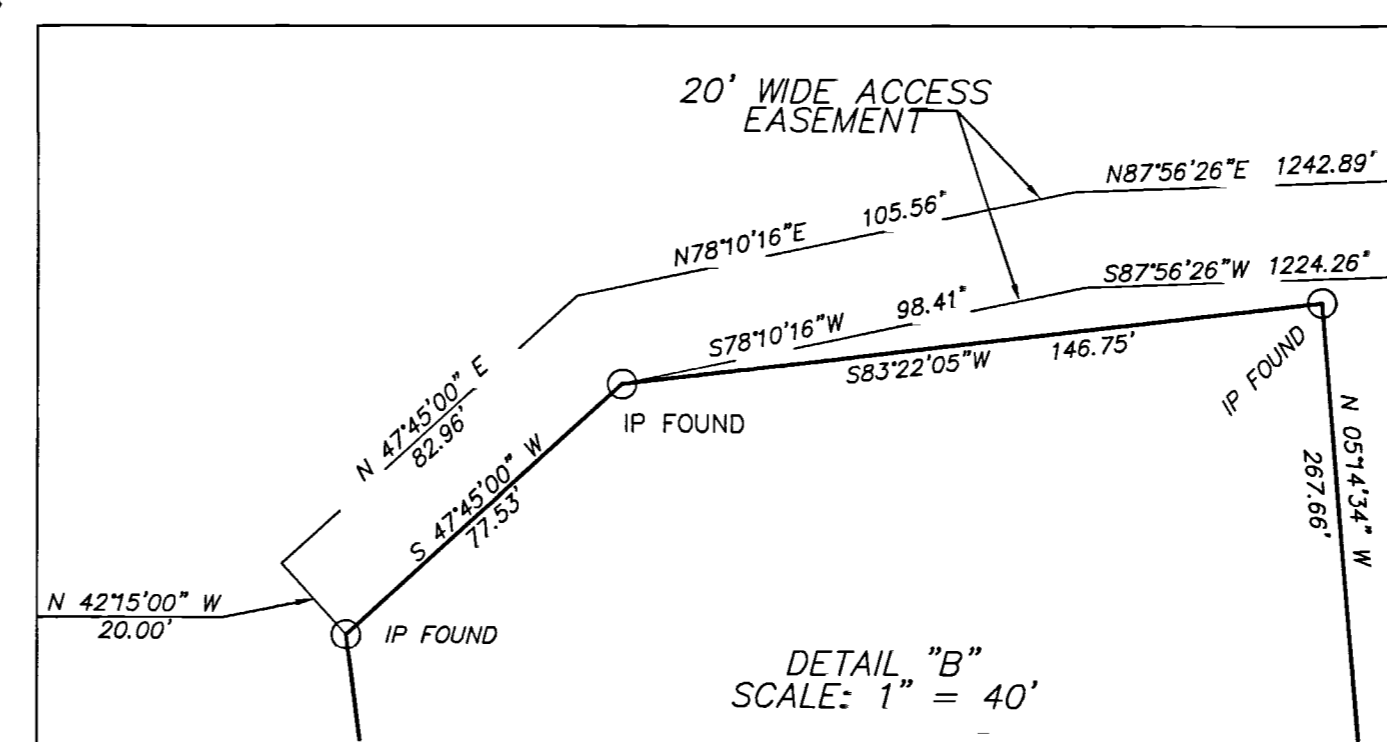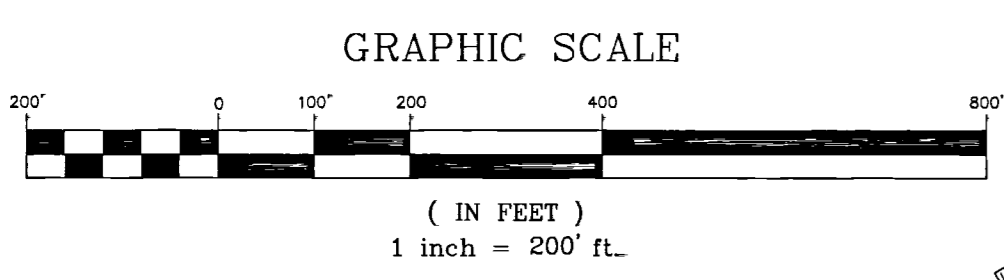

BEARINGS ARE BASED ON THE SOUTH LINE OF THE CAMP CHASE RAILROAD CORPORATION BEING LONG 3675.15' LAID AS PROVIDED BY THE GEORGESVILLE FARMS, LLC TRACT FOUR DESCRIPTION OF RECORD IN INSTRUMENT NUMBER 201412050162306

- = IRON PIN SET, 5/8 INCH DIAMETER, 30 INCHES LONG, WITH IDENTIFICATION CAP STAMPED "ELSWICK / RS 6395"
- ▲ = MAGNETIC NAIL SET
- = IRON PIPE FOUND
- △ = RAILROAD SPIKE FOUND
- = REBAR FOUND WITH IDENTIFICATION CAP STAMPED "ELSWICK RS 6395" UNLESS OTHER WISE NOTED.
- ⊙ = MAGNETIC NAIL FOUND

CERTIFICATION:
I CERTIFY THAT THIS BOUNDARY SURVEY WAS PREPARED IN ACCORDANCE WITH OHIO ADMINISTRATIVE CODE CHAPTER 4733-37 STANDARDS FOR BOUNDARY SURVEYS. ALL MONUMENTATION EXISTS OR TO BE SET AS SHOWN.
Gary L. Elswick
GARY L. ELSWICK, REGISTERED SURVEYOR #6395
DATE: 5-18-17



PLAN SHOWING SURVEY OF:
135.874 ACRE SURVEY
LOCATION: PLEASANT TWP.
COUNTY: FRANKLIN CO.
DRAWING #:
SHEET:
1 OF 1

R W S U R V E Y, L L C
L a n d S u r v e y o r s