

SITE ENGINEERING, INC.


7453 EAST MAIN STREET
REYNOLDSBURG, OHIO 43068
PHONE: (614) 759-9900

FILE #3927
DATE: APRIL 17

SCALE: 1"=150'

SITUATED IN THE STATE OF OHIO, COUNTY OF FRANKLIN, CITY OF GAHANNA, LOCATED IN LOT 20 OF DAVID TAYLOR'S SUBDIVISION OF QUARTER TOWNSHIP 3, TOWNSHIP 1, RANGE 16, UNITED STATES MILITARY LANDS OF RECORD IN PLAT BOOK 1, PAGE 10 IN THE RECORDER'S OFFICE, FRANKLIN COUNTY, OHIO.


N

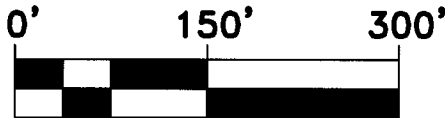

GRAPHIC SCALE

LEGEND

- I.P.S. \rightarrow Iron Pin Set
- I.P.Fd. \bullet Iron Pin Fd

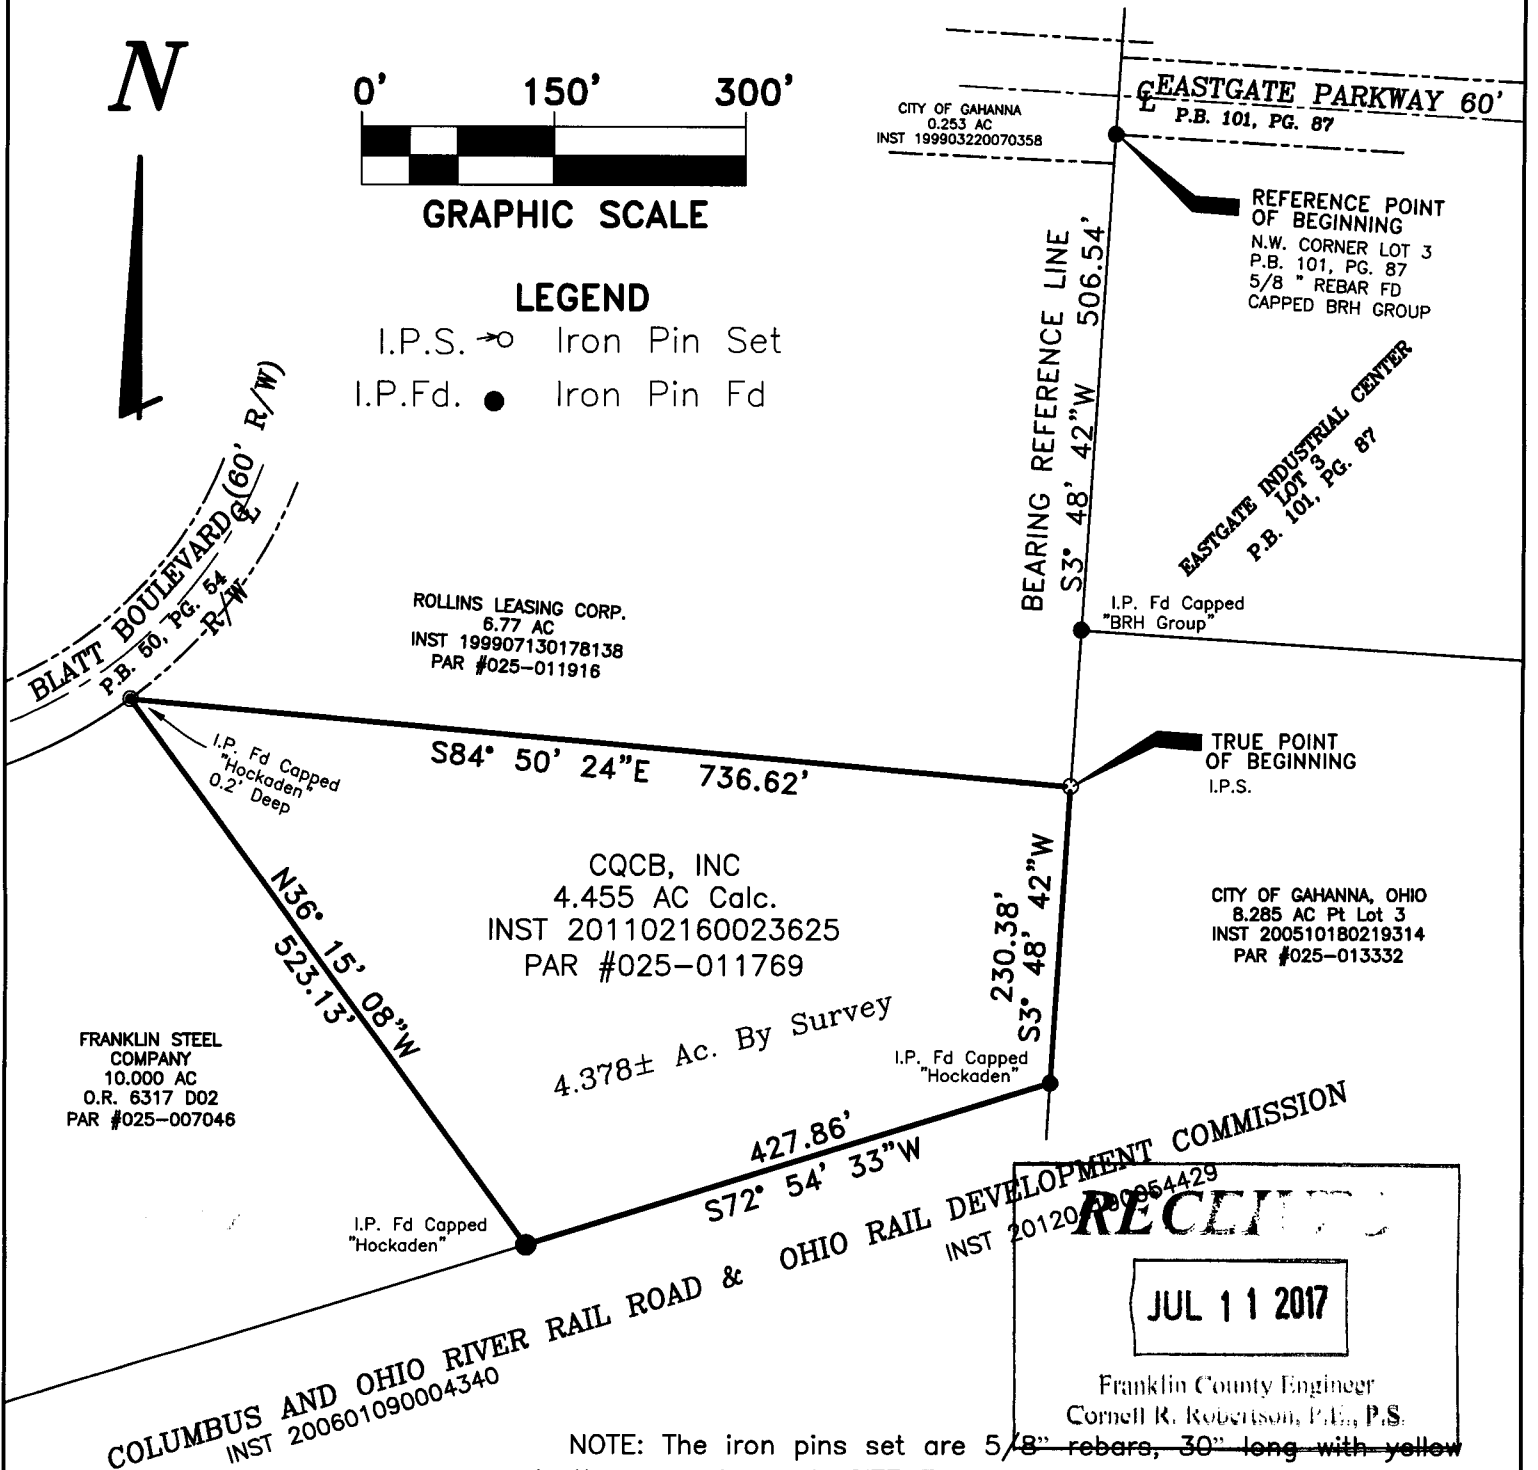

RECEIVED
JUL 11 2017
Franklin County Engineer
Cornell R. Robertson, P.E., P.S.

NOTE: The iron pins set are 5/8" rebar, 30" long with yellow plastic caps stamped "SITE ENG INC." Bearings are used for the determination of angles only. For the purpose of this survey, a bearing of South 03° 48' 42" West was used on the west line of Eastgate Industrial Center as shown on Plat Book 101, Page 87 Franklin County Recorder's Office.

The above description was prepared from an actual field survey during April, 2017 by Site Engineering, Inc.

SITE ENGINEERING, INC.

By Mark A Hazel, P.S. 5-1-17
Mark A. Hazel Date
Professional Surveyor No. 7039

