

Myers Surveying Company, Inc.

2740 East Main Street, Columbus 43209 (Bexley), Ohio

614-235-8677



FAX:614-235-4559

A Boundary Survey prepared for and certified to:



Land and Mortgage Title Agency

Legal Description: Situated in The State of Ohio, County of Franklin, Township of Prairie Being Lot 442 National Pike Little Farm Subdivision, Plat Book 12, Page 7

Posted Address: 274 Maple Drive

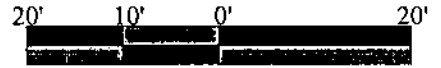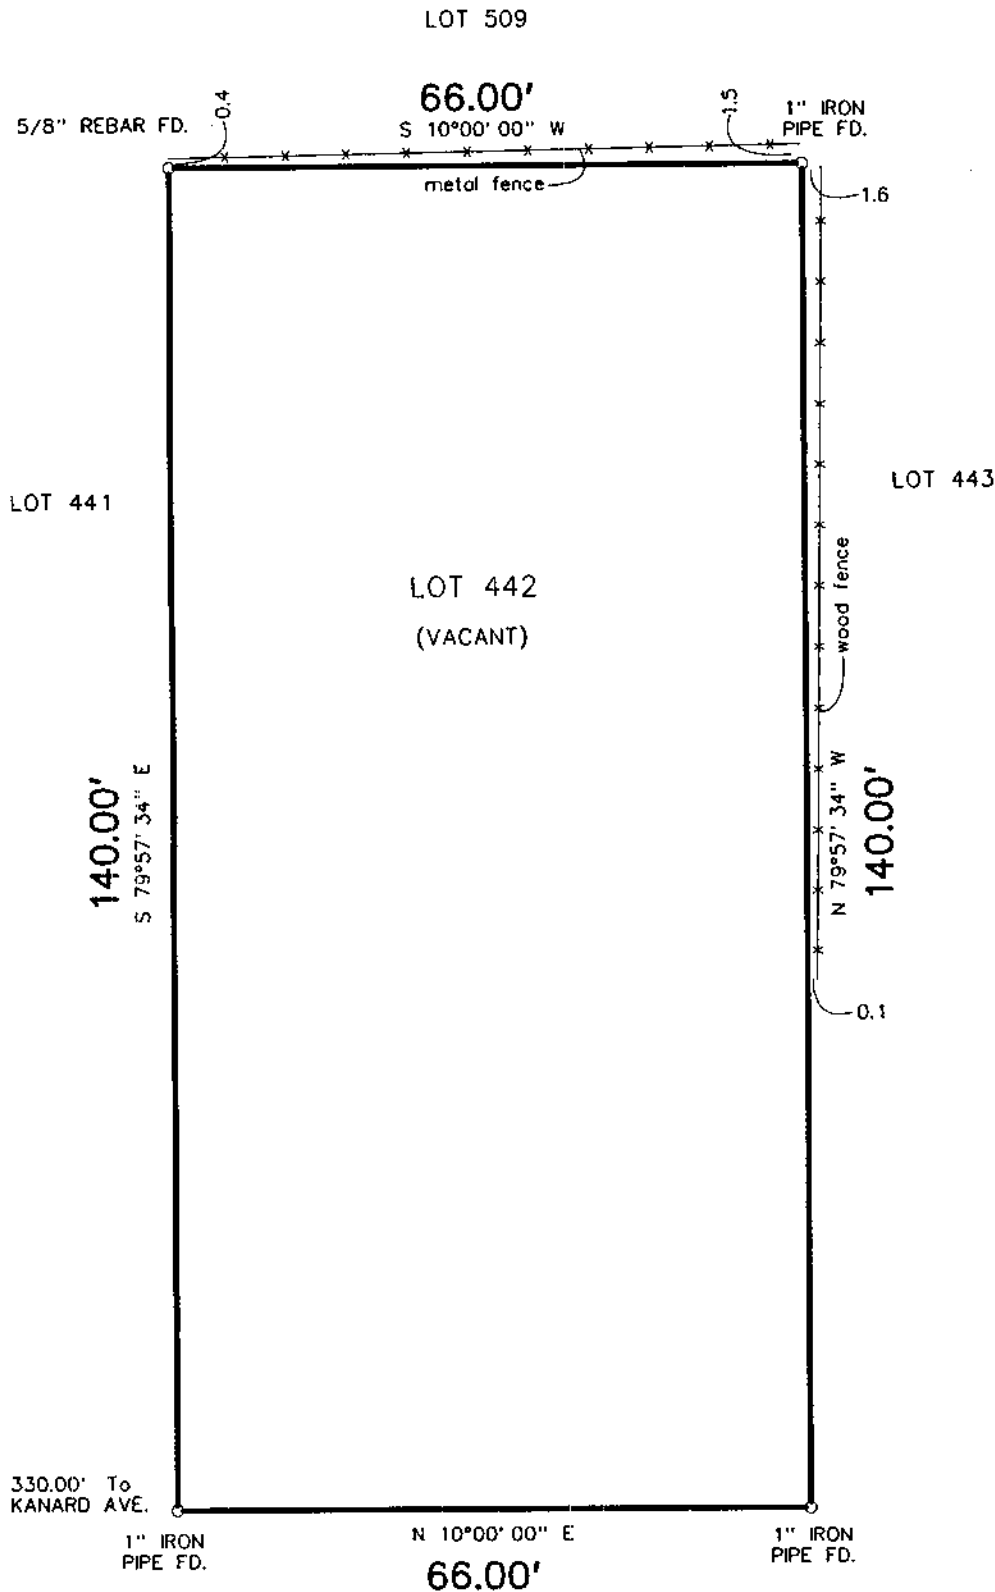

Scale 1" = 20'
Date: 06/09/2017

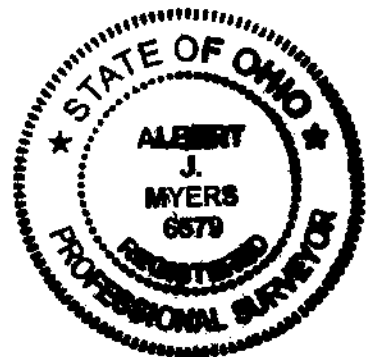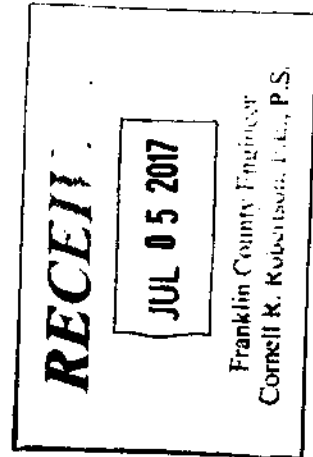

MAPLE DRIVE 50'

We hereby certify that the foregoing Boundary Survey was prepared from actual field measurements in accordance with Chapter 4733-37 Ohio Administrative Code. Iron pipes set are 30"x1" O.D. with an orange plastic plug inscribed "MYERS P.S. 6579", unless otherwise noted. Basis of bearings is the centerline of Maple Drive assumed as North 10° 00' 00" East.

Myers Surveying Co., Inc.

By *Albert J. Myers*
6/16/17
Professional Surveyor

Myers Order No. - 3-05/18/2017



201705183

Rec.	Field	DWG	Ltr.	Ck.
PD	Row	D 30	D 30	