J-3-B

EMH&T
Evans, Mechwart, Hambleton & Tilton, Inc.
Engineers • Surveyors • Planners • Scientists
5500 New Albany Road, Columbus, OH 43054
Phone: 614.775.4500 Toll Free: 888.775.3648
emht.com

SURVEY OF ACREAGE PARCEL

LOT 17, QUARTER TOWNSHIP 4, TOWNSHIP 2, RANGE 16
UNITED STATES MILITARY LANDS
TOWNSHIP OF PLAIN, COUNTY OF FRANKLIN, STATE OF OHIO

Date:	February 1, 2018
Scale:	1" = 100'
Job No:	2016-1270

SURVEY NOTE:
This survey was prepared using documents of record, prior plats of survey, and observed evidence located by an actual field survey in 2015 and 2017.

BASIS OF BEARINGS:
The Bearings shown hereon are based on the Ohio State Plane Coordinate System (South Zone) as per NAD83 (1986 Adjustment). Control for bearings was from coordinates of monuments FRANK80 and FRANK180, having a bearing of North 85° 57' 24" West, as established by the Franklin County Engineering Department using Global Positioning System procedures and equipment.

RECIEVED
Franklin County Engineer
Cornell R. Robertson, P.E., P.S.

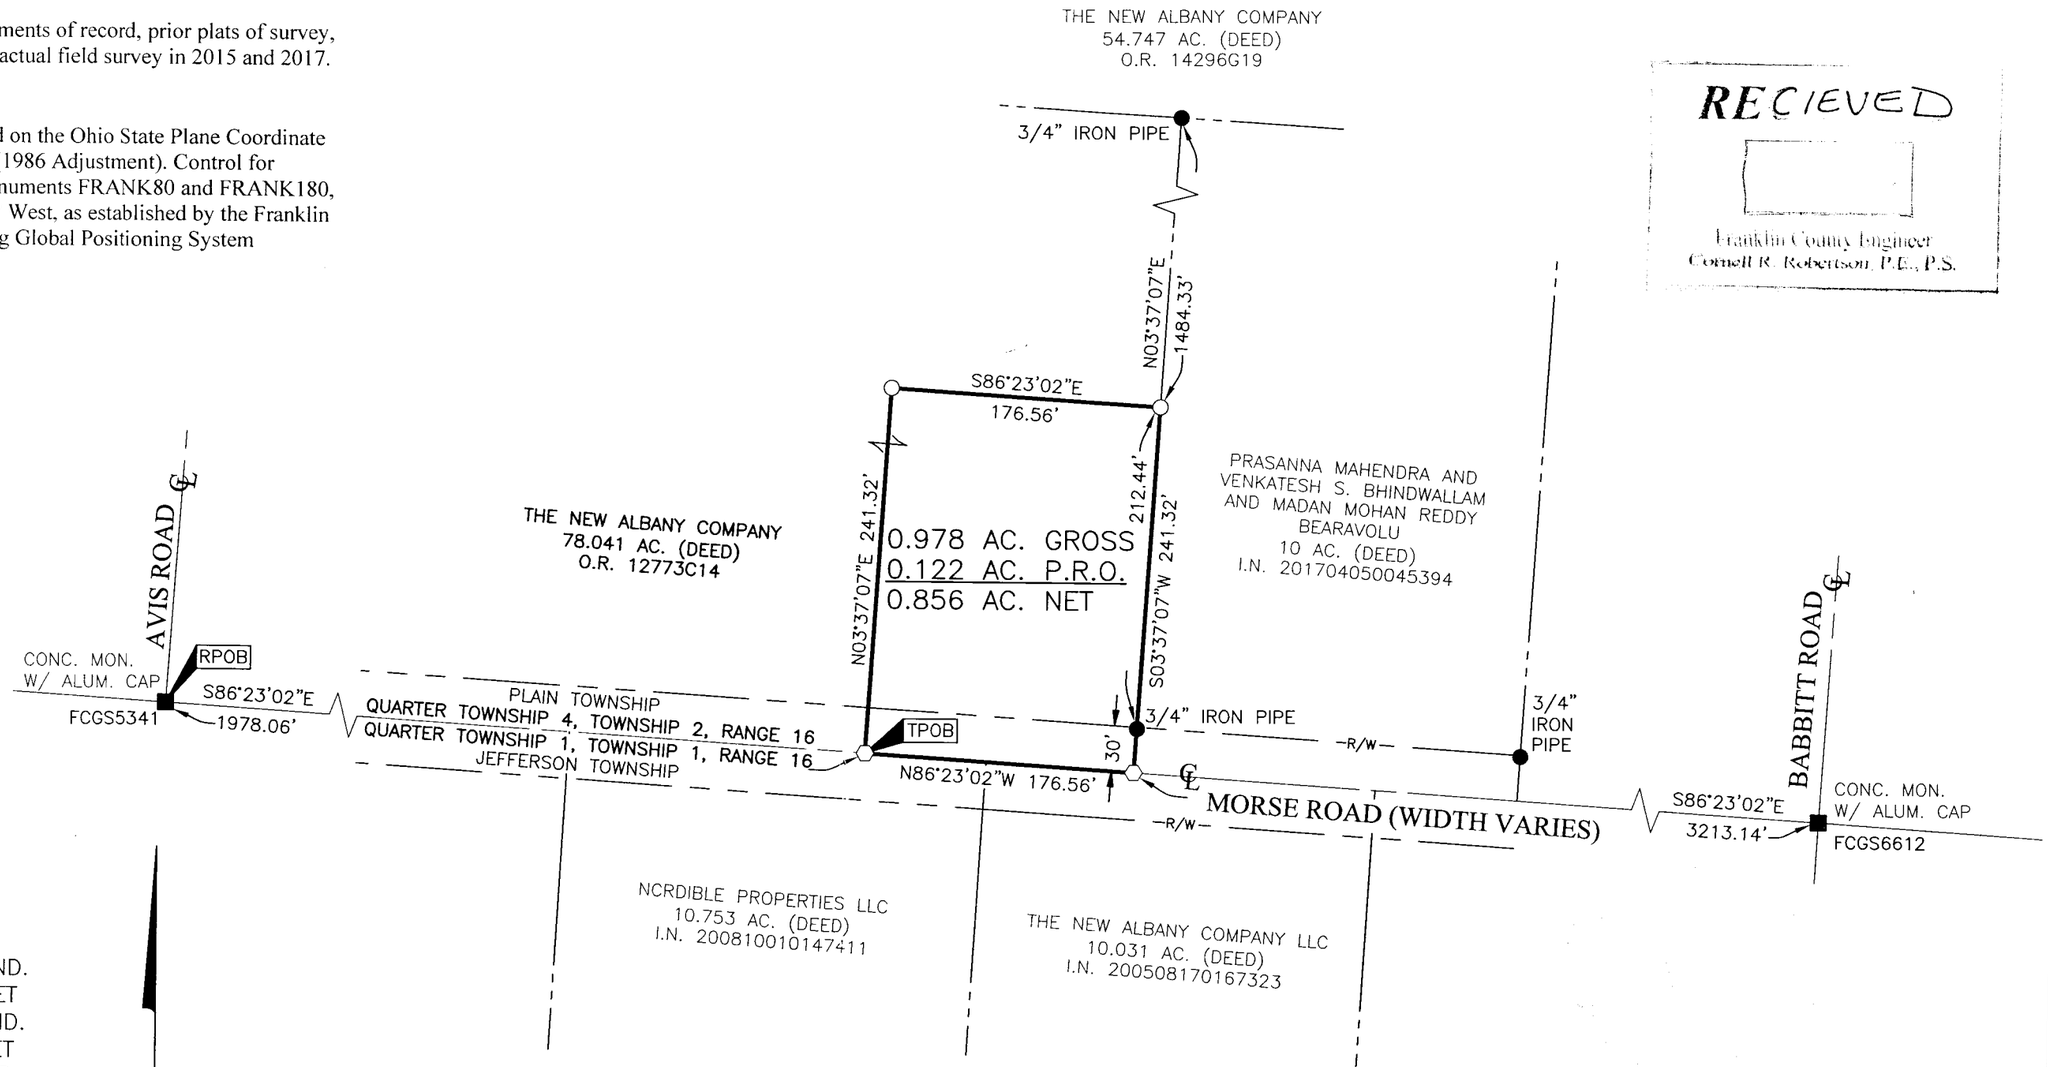

○ = STONE FND.
■ = MON. FND.
● = I.P. FND.
○ = I.P. SET
⬟ = MAG. NAIL FND.
⬡ = MAG. NAIL SET
▲ = R.R. SPK. FND.
△ = R.R. SPK. SET
⬟ = P.K. NAIL FND.

I.P. Set are 13/16" I.D. iron pipes 30" long with cap inscribed EMHT INC.

100 0 100 200
GRAPHIC SCALE (in feet)

By _____ 2-1-2018
Joshua M. Meyer
Professional Surveyor No. 8485
Date

NAPD Regional Water Booster Station / 20161270-VS-BNDY-01

J:\20161270\DWG\04SHEETS\BOUNDARY\20161270-VS-BNDY-01.DWG plotted by SCHROEDER, JACOB on 2/1/2018 9:06:00 AM last saved by JSCHROEDER on 2/1/2018 8:54:33 AM
Xrefs: 88607475.DWG & 88607450.DWG