



Evans, Mechwarl, Hambleton & Tillon, Inc.
 Engineers • Surveyors • Planners • Scientists
 5500 New Albany Road, Columbus, OH 43054
 Phone: 614.773.4500 Toll Free: 888.775.3648
 emht.com

SURVEY OF ACREAGE PARCEL

SURVEY NUMBER 6115


VIRGINIA MILITARY DISTRICT

CITY OF GROVE CITY, COUNTY OF FRANKLIN, STATE OF OHIO

Date: May 25, 2018

Job No: 2018-0153

Scale: 1" = 60'

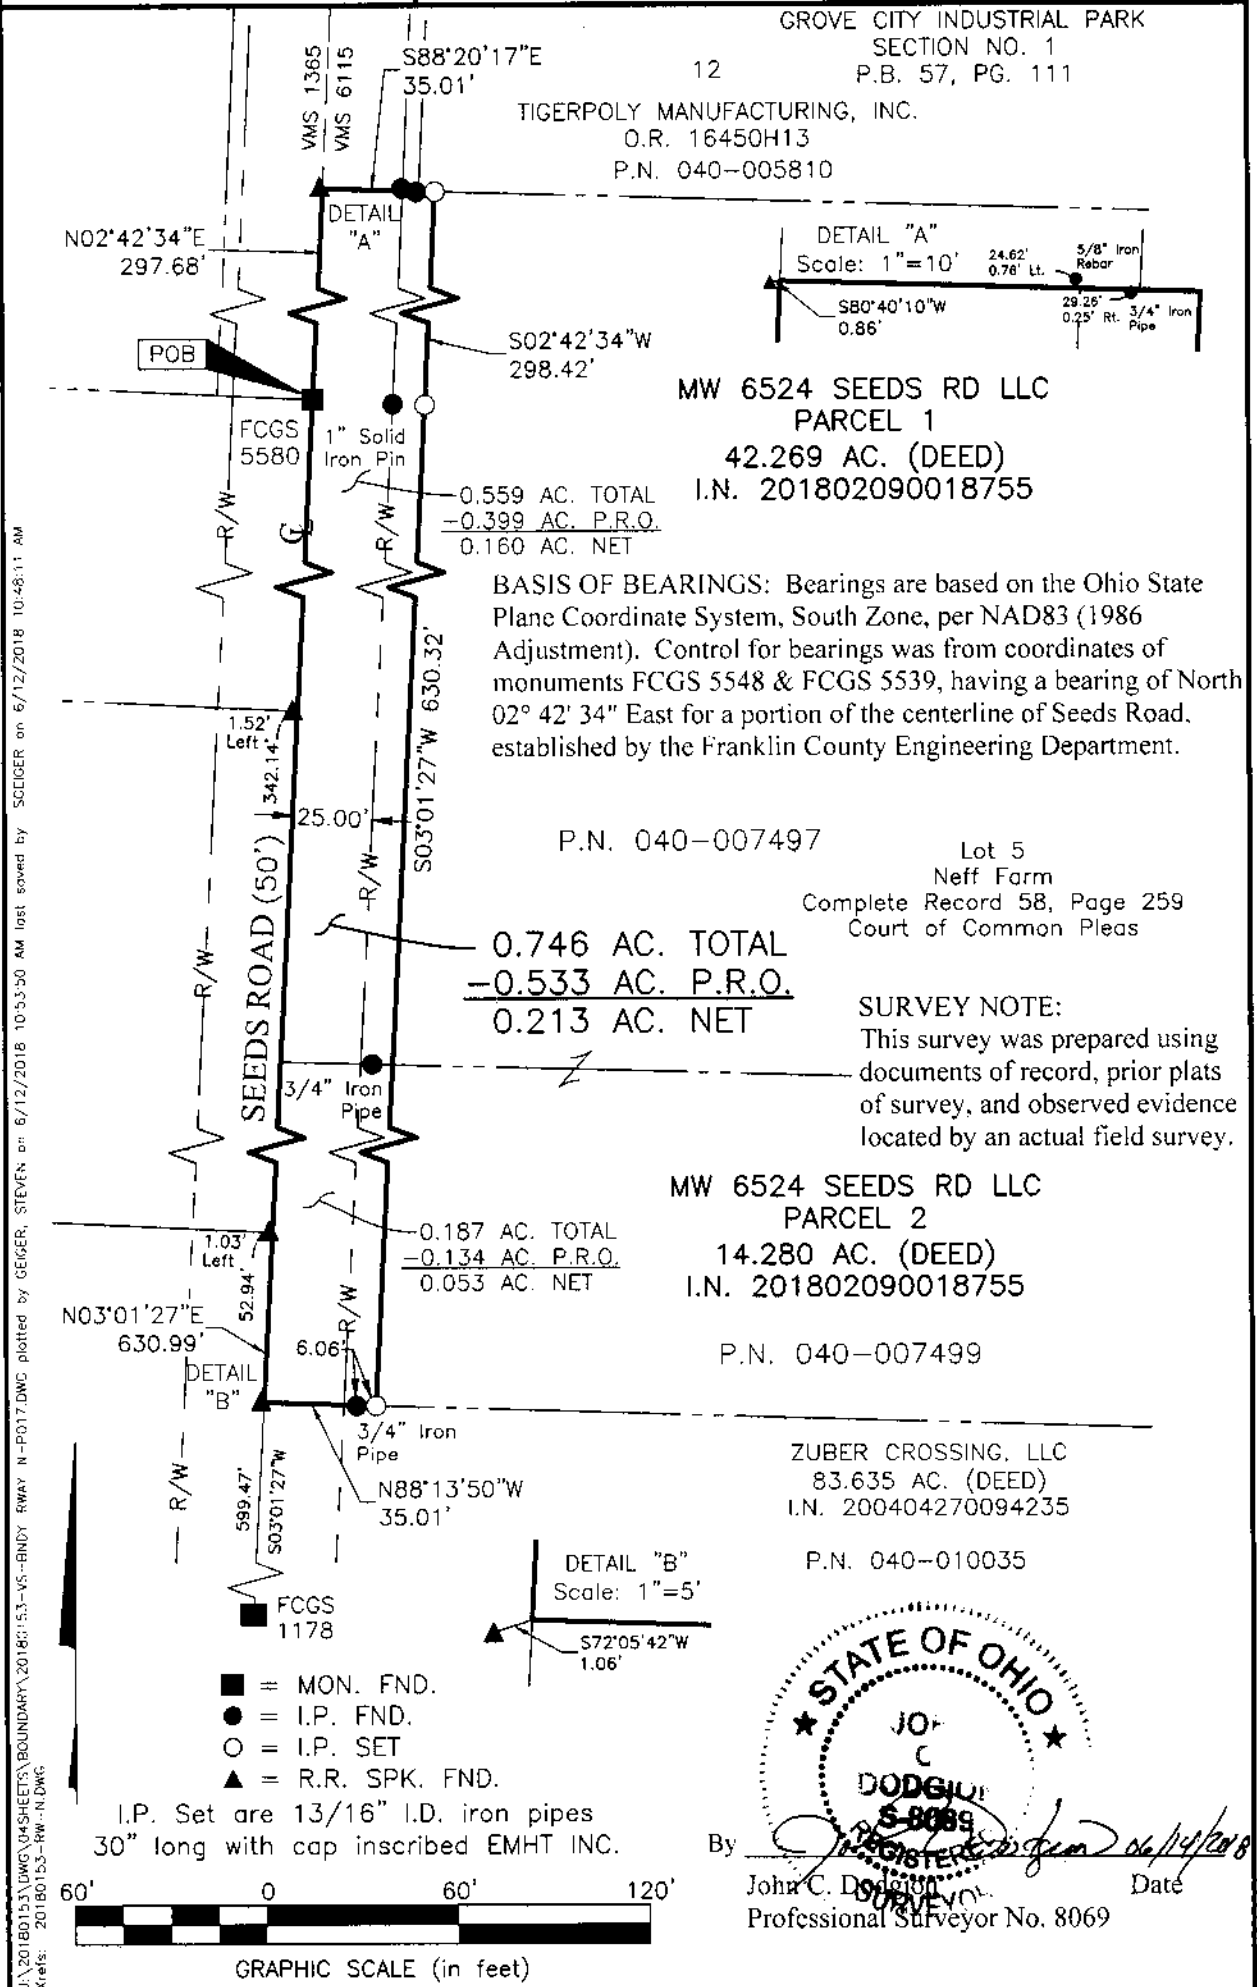

J:\20180153\DWG\USHSHEETS\BOUNDARY\20180153-VS-BNDY-RWAY-N-P017.DWG plotted by GEIGER, STEVEN on 6/12/2018 10:53:50 AM last saved by SCIEGER on 6/12/2018 10:48:11 AM
 Xrefs: 20180153-RW-N.DWG