


HILLIARD CHURCH OF CHRIST ~ ORIG 7.59 ACRE
 OFF. REC. 26026 B09
 P.I.D. 050-002286

FRANKLIN COUNTY COMMISSIONERS
 ORIG. 42.815 ACRES
 OFF. REC. 06656 F01
 P.I.D. 050-003349

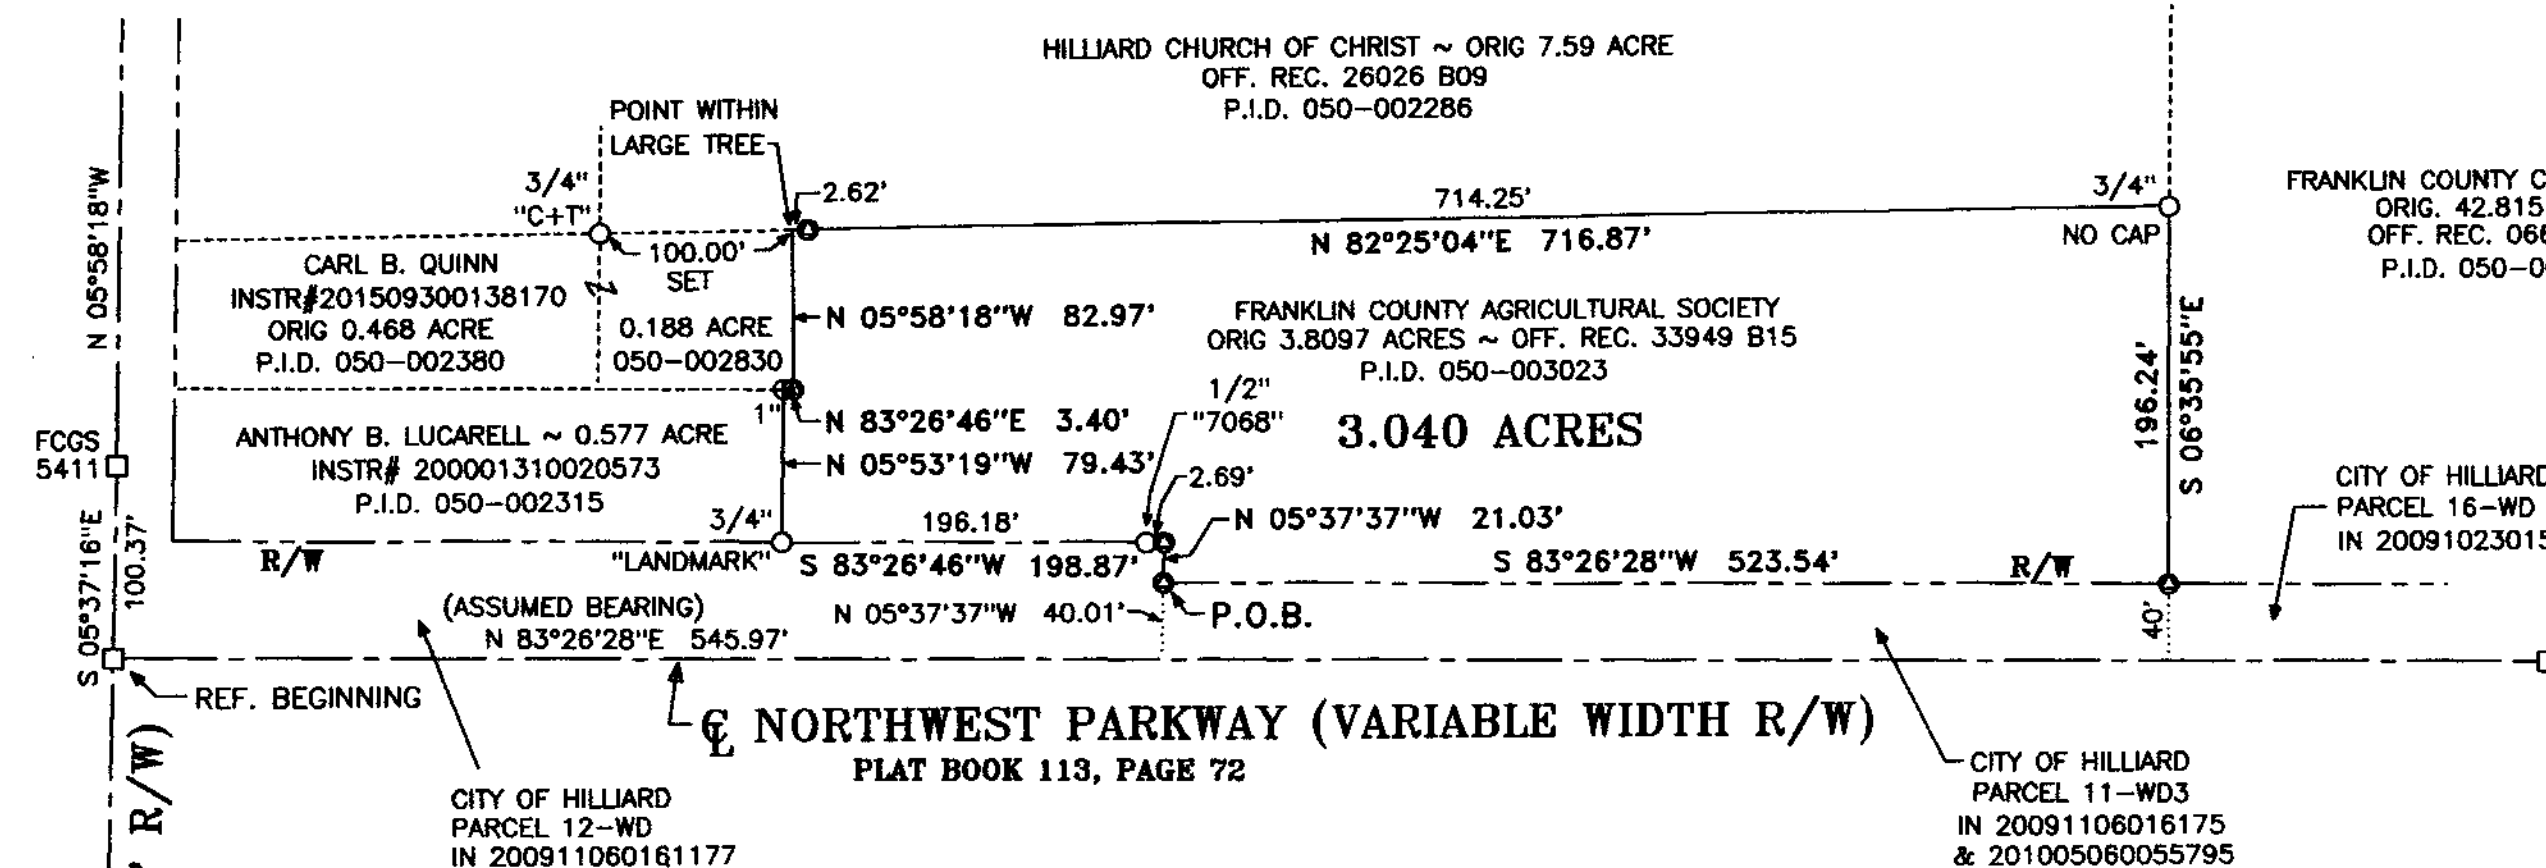

VMS 3453
 AVERY ROAD (60' R/W)
 VMS 3002

☪ NORTHWEST PARKWAY (VARIABLE WIDTH R/W)
 PLAT BOOK 113, PAGE 72

CITY OF HILLIARD
 PARCEL 12-WD
 IN 200911060161177

CITY OF HILLIARD
 PARCEL 11-WD3
 IN 20091106016175
 & 201005060055795



- NOTES:
- 1) ○ IRON PIPE FOUND
 - 2) □ IRON ROD FOUND IN MONUMENT BOX
 - 3) ⊕ IRON ROD FOUND
 - 4) ⊗ 5/8" X 30" IRON ROD WITH PLASTIC ID CAP SET "PRIDAY S-7277"
 - 5) BEARING ASSUMED FROM INSTR# 201005060055795

PLAT OF SURVEY FOR:
FRANKLIN COUNTY
AGRICULTURAL SOCIETY
CITY OF HILLIARD
NORWICH TOWNSHIP ~ V.M.S. 3002
FRANKLIN COUNTY, OHIO
PART OF ORIG 3.8097 ACRE TRACT
OFF. REC. 33949 B15
P.I.D. 050-003023

Joseph P. Priday 6-28-2018

JOSEPH P. PRIDAY (S-7277)
 JUNE 13, 2018 JN 18-31

I HEREBY CERTIFY THAT THIS PLAT WAS PREPARED FROM AN ACTUAL FIELD SURVEY AND MONUMENTS WERE SET AS INDICATED.

PRIDAY SURVEYING INC
P.O. BOX 192
MARYSVILLE, OHIO 43040
937-642-3400

