

E-9-F



Evans, Mechwart, Hambleton & Tilton, Inc.
Engineers • Surveyors • Planners • Scientists
5500 New Albany Road, Columbus, OH 43054
Phone: 614.775.4300 Toll Free: 888.775.3648
emht.com


SURVEY OF ACREAGE PARCEL

FARM LOT 7, QUARTER TOWNSHIP 3, TOWNSHIP 2, RANGE 17
UNITED STATES MILITARY LANDS
CITY OF COLUMBUS, COUNTY OF FRANKLIN, STATE OF OHIO

Date: July 25, 2018

Job No: 2018-0770

Scale: 1" = 30'

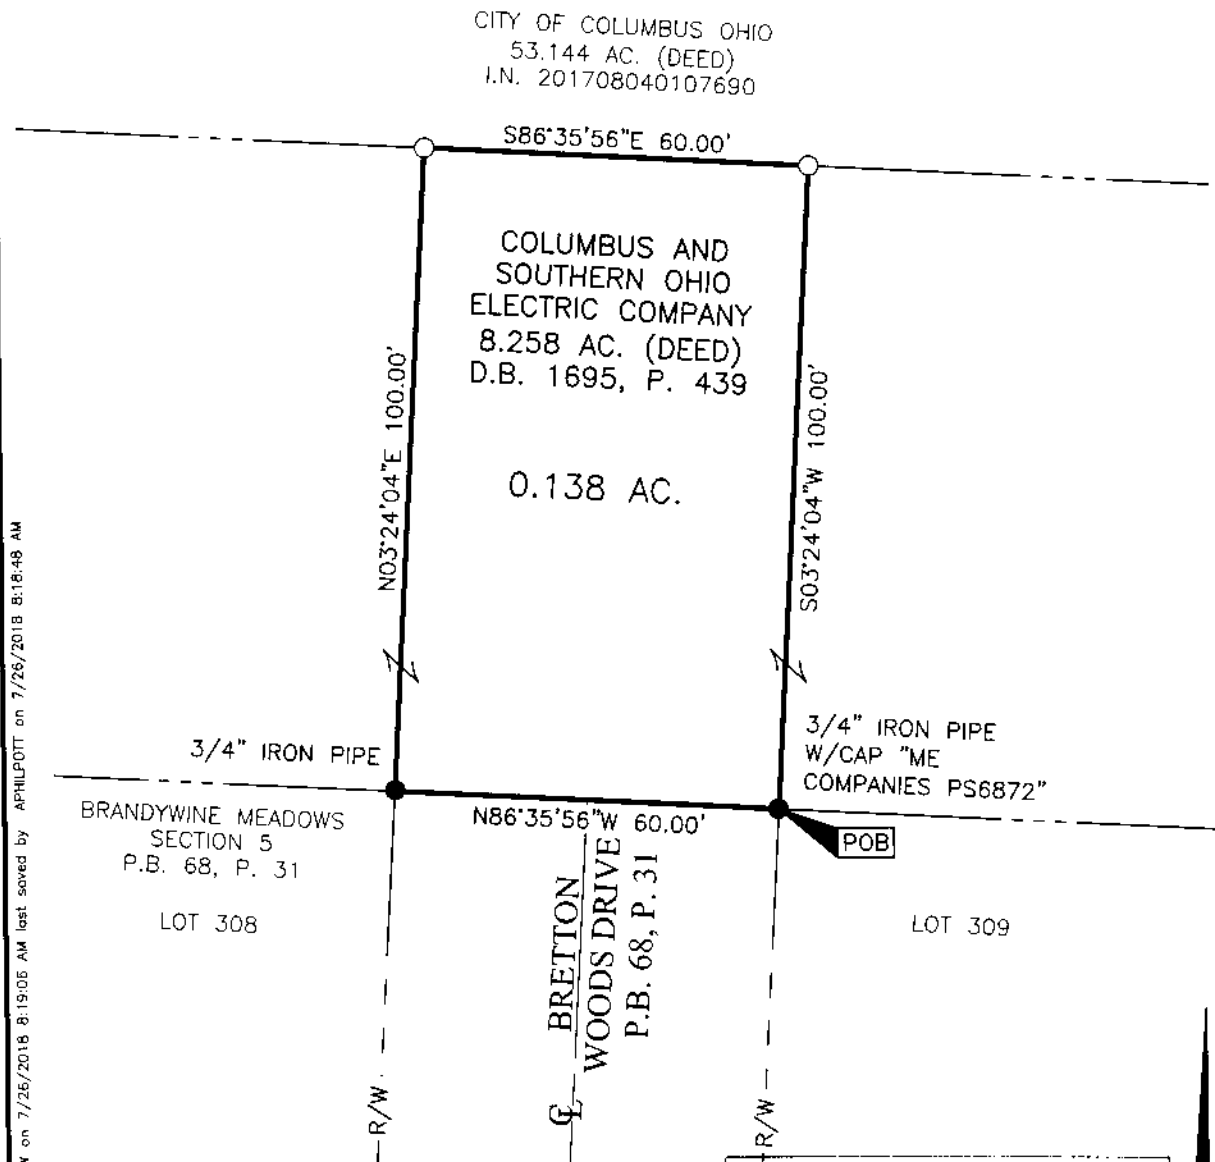

BASIS OF BEARING:

The bearings shown hereon are based on the bearing of North 86° 35' 56" West for the northerly line of "BRANDYWINE MEADOWS - SECTION 5", a subdivision of record in Plat Book 68, Page 31


SURVEY NOTE:

This survey was prepared using documents of record, prior plats of survey, and observed evidence located by an actual field survey on July 9, 2018

- = STONE FND.
- = MON. FND.
- = I.P. FND.
- = I.P. SET
- = MAG. NAIL FND.
- = MAG. NAIL SET
- ▲ = R.R. SPK. FND.
- △ = R.R. SPK. SET
- ◆ = P.K. NAIL FND.

I.P. Set are 13/16" I.D. iron pipes 30" long with cap inscribed EMHT INC.

RECEIVED

 

Franklin County Engineer
Cornell R. Robertson, P.L., P.S.



By

John C. Dodgion
Professional Surveyor No. 8069

07/31/2018
Date



GRAPHIC SCALE (in feet)

J:\20180770\DWG\04-SHEETS\BOUNDARY\20180770-VS-BNDY-01.DWG plotted by PHILPOIT, ANDREW on 7/26/2018 8:19:05 AM last saved by PHILPOIT, ANDREW on 7/26/2018 8:18:48 AM