
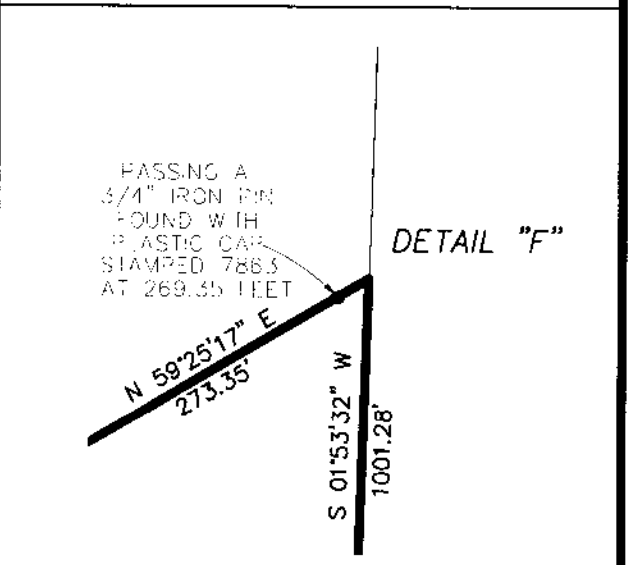
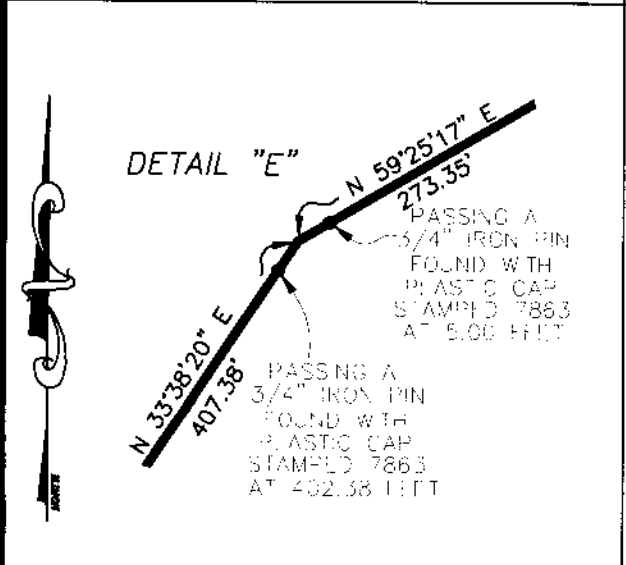
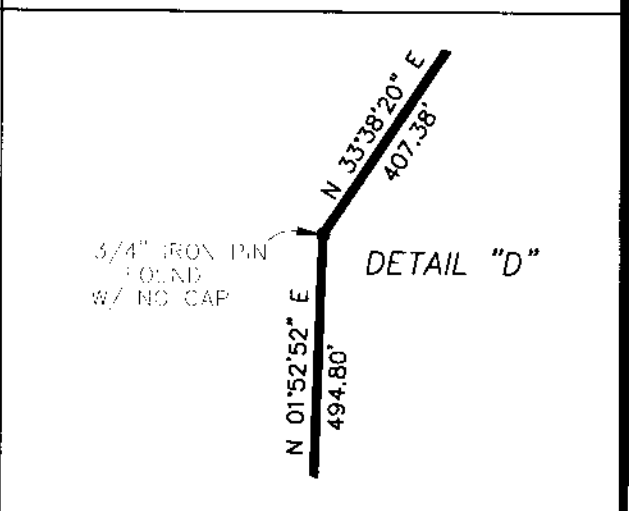
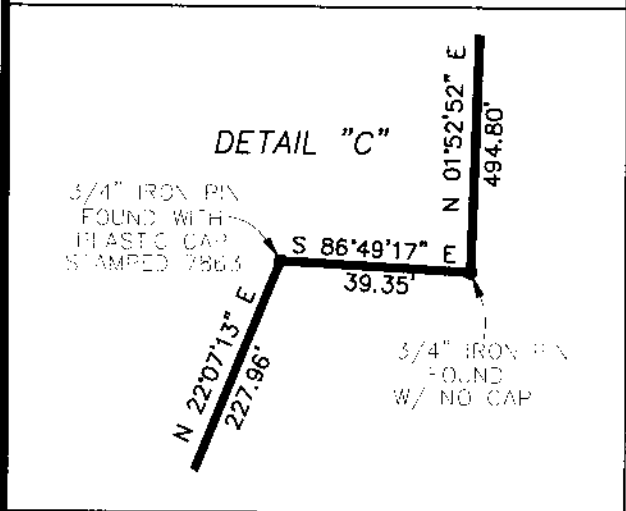
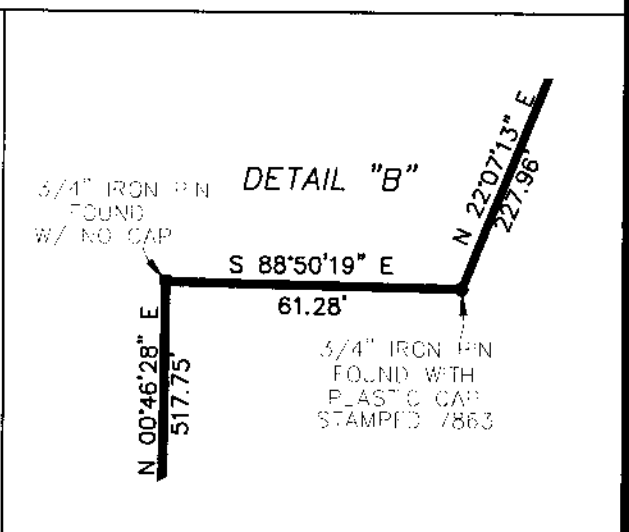


SURVEY OF 41.657 ACRES
VIRGINIA MILITARY SURVEY 5273
TOWNSHIP OF BROWN, COUNTY OF FRANKLIN, STATE OF OHIO

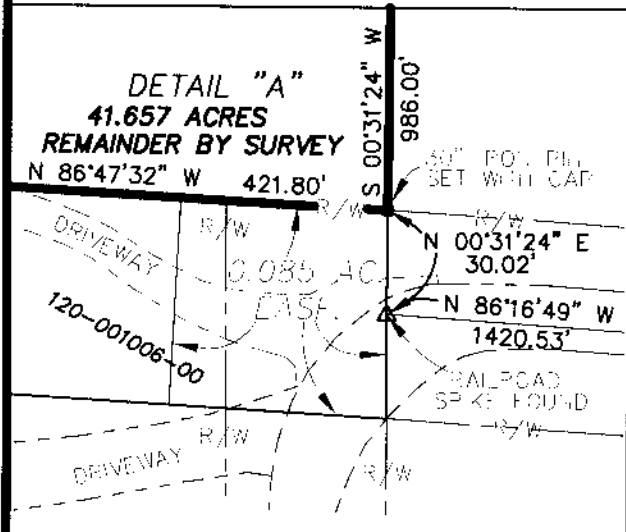

RECEIVED

Franklin County Engineer
 Cornell R. Robertson, P.E., P.S.

CLIENT				
JESSIE B. CROOK, TRUSTEE				
PRECISION SURVEYING SERVICES, LLC.				
9055 S.R. 56 S.E.				
MT. STERLING, OHIO 43143				
CELL ~ (614) 595-9412		OFFICE ~ (740) 845-1422		
DRAWN BY: JWE	CHECKED BY: JWE	ORDER No.	AREA No.	SHEET
SCALE: NONE	DATE: SEPT. 20, 2018		FRA	2 OF 2