L-5-B, C

# 0.076 Acre Exhibit

QUARTER TOWNSHIP 2,
TOWNSHIP 2, RANGE 18
UNITED STATES MILITARY DISTRICT
CITY OF WORTHINGTON, SHARON TWP.,
FRANKLIN COUNTY, OHIO

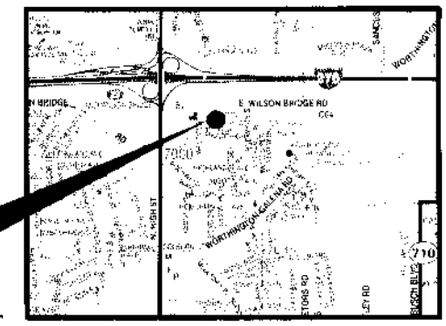


**VICINITY MAP**
SCALE: NTS

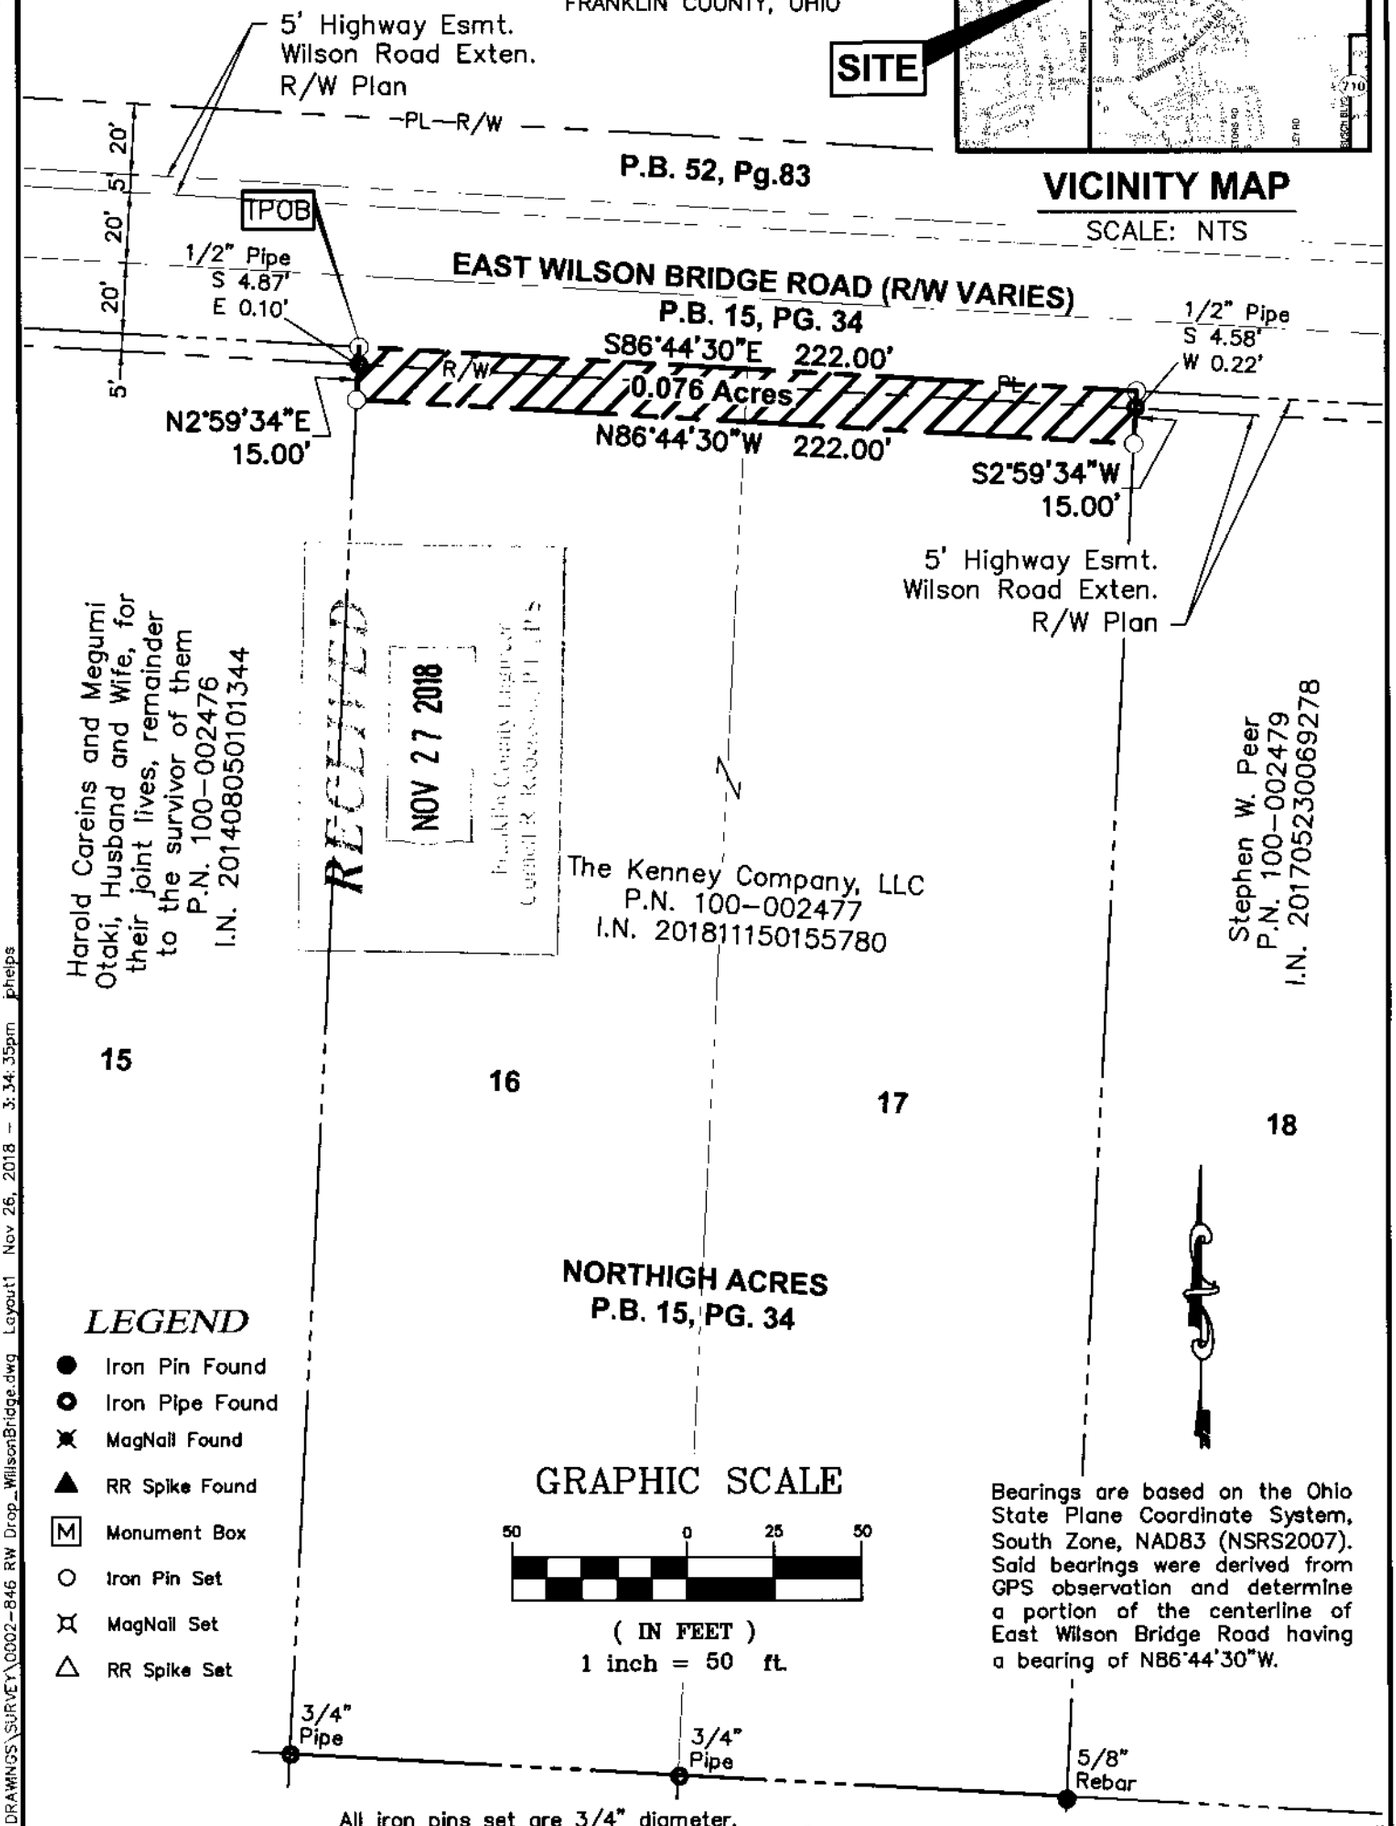


Bearings are based on the Ohio State Plane Coordinate System, South Zone, NAD83 (NSRS2007). Said bearings were derived from GPS observation and determine a portion of the centerline of East Wilson Bridge Road having a bearing of N86°44'30"W.

All iron pins set are 3/4" diameter, 30" long iron pipe with plastic cap inscribed "Advanced 7661".

This Survey is based on existing records from Franklin County, and from actual field survey work.

ADVANCED CIVIL DESIGN, INC.

Jonathan E. Phelps 11/26/18
Jonathan E. Phelps Date
Reg. No. 8241

| | |
|---|---|
| DRAWN BY: JEP | JOB NO.: 18-0002-846 |
| DATE: 11/26/2018 | CHECKED BY: JEP |

ADVANCED CIVIL DESIGN
ENGINEERS SURVEYORS
422 Beecher Road
Gahanna, Ohio 43230
ph 614.428.7750
fax 614.428.7755

Z:\18-0002-846\DWG\PRODUCTION DRAWINGS\SURVEY\0002-846 RW Drop_WilsonBridge.dwg Layout1 Nov 26, 2018 - 3:34:35pm jphelps