


Parcel Exhibit

City of Gahanna, Franklin County, Ohio
 Quarter Township 2, Township 1, Range 16

LEGEND

- Iron Pipe Found
- Iron Pin Found
- Iron Pin Set
- ⊗ P.K. Nail Set
- Ⓜ Monument Found

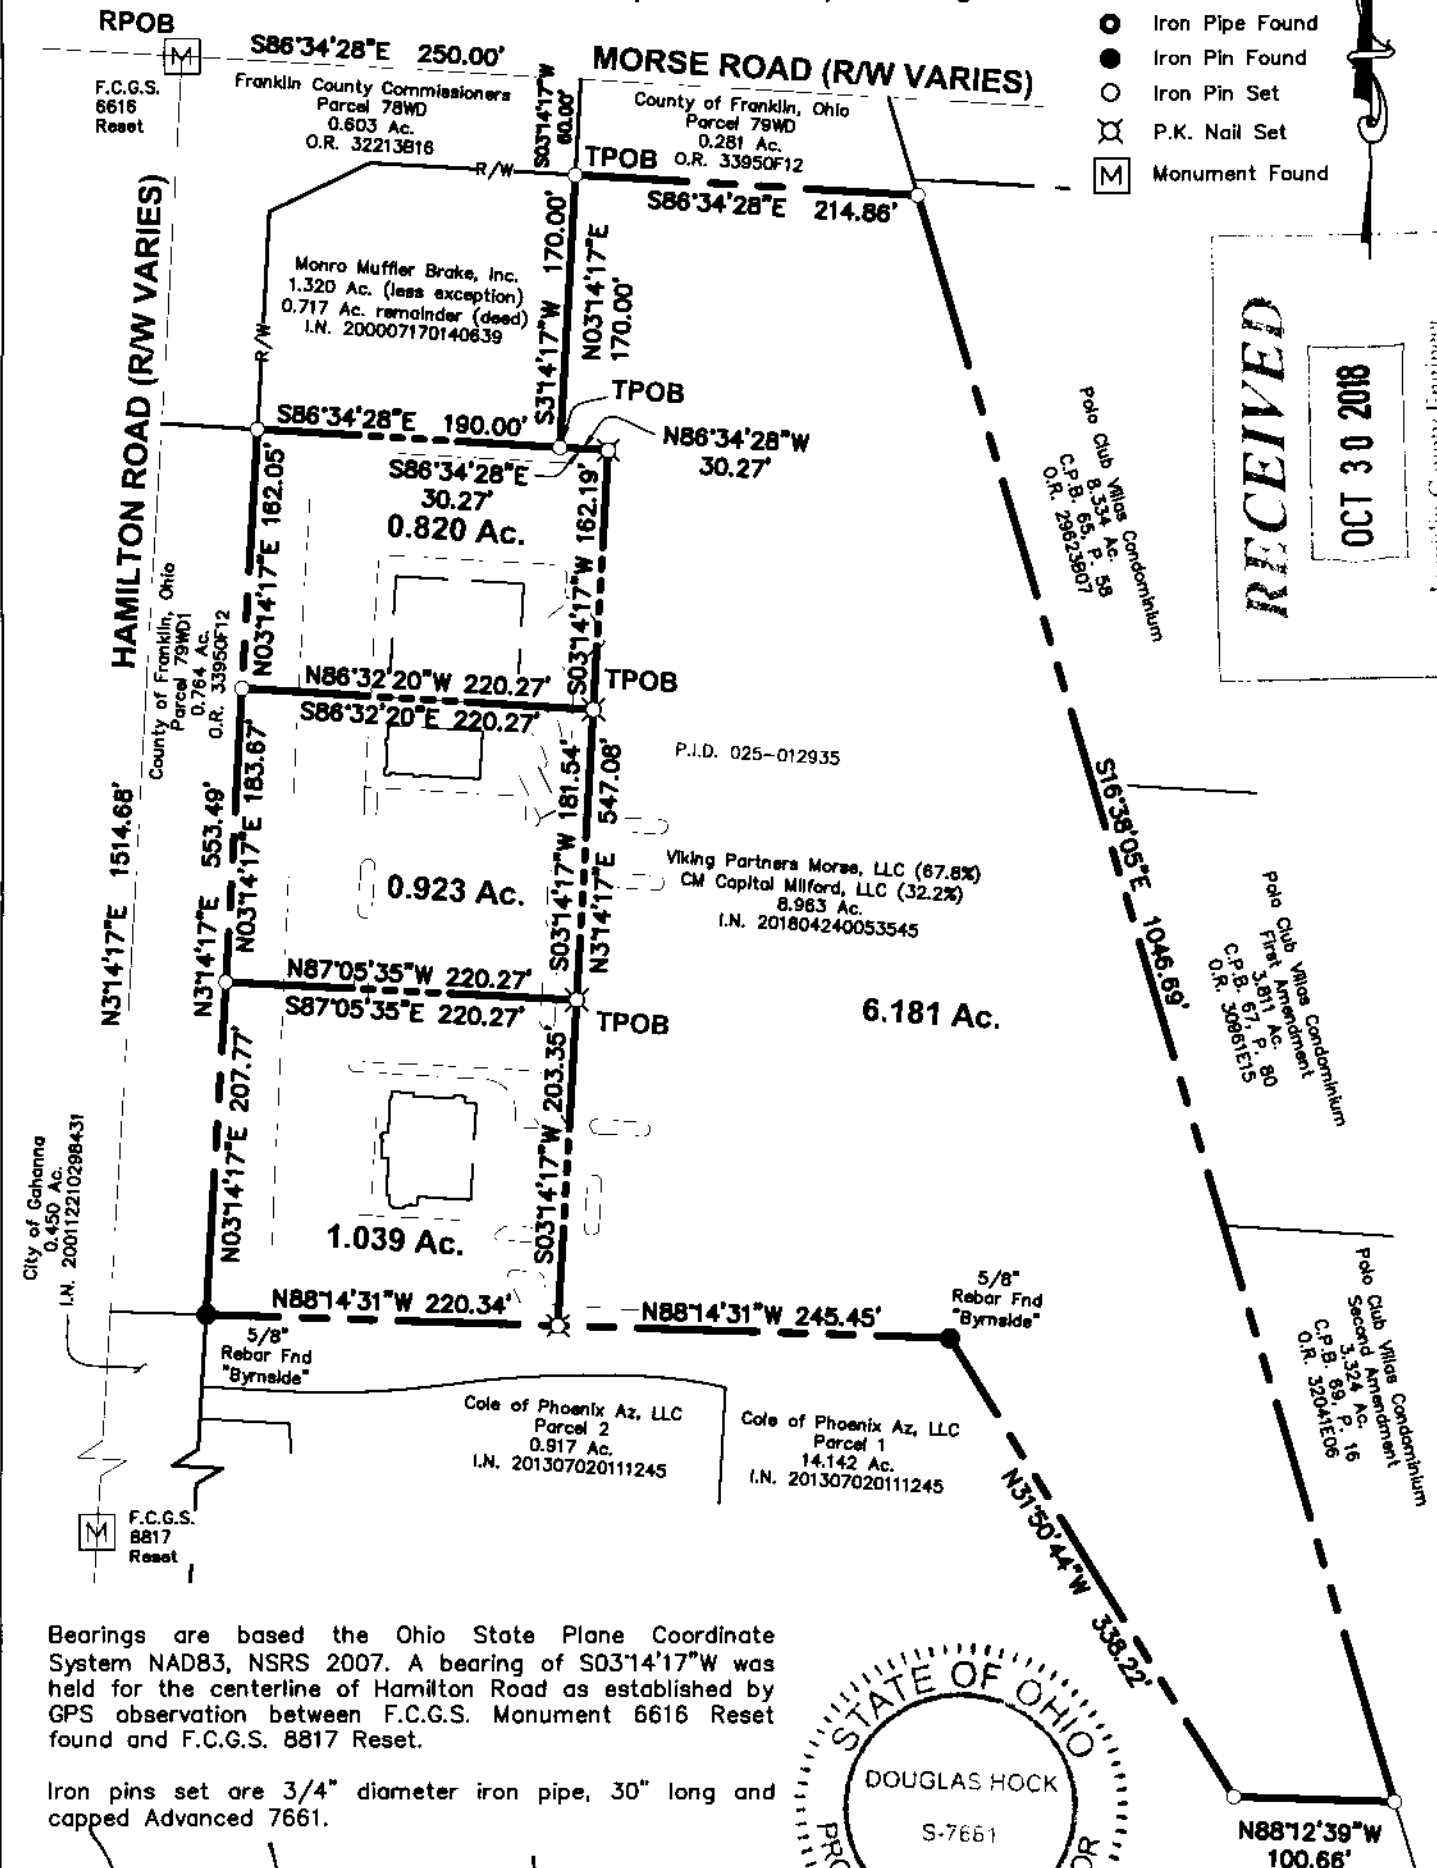

RECEIVED


OCT 30 2018

Franklin County Engineer
 Cornell R. Robertson, P.E., P.S.

Bearings are based the Ohio State Plane Coordinate System NAD83, NSRS 2007. A bearing of S03°14'17"W was held for the centerline of Hamilton Road as established by GPS observation between F.C.G.S. Monument 6616 Reset found and F.C.G.S. 8817 Reset.


Iron pins set are 3/4" diameter iron pipe, 30" long and capped Advanced 7661.

[Signature] 10/29/18
 Douglas R. Hock, P.S. 7661 Date:

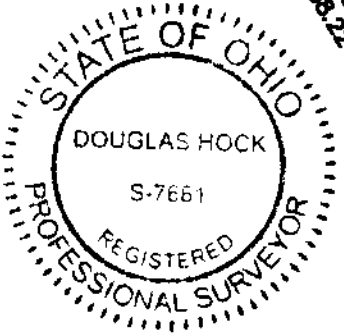

DRAWN BY: BCK	JOB NO.: 18-0001-957
DATE: 10/29/2018	CHECKED BY: DRB

This drawing is based on existing Franklin County Auditor and Recorder records and a field survey by Advanced Civil Design in September of 2018.

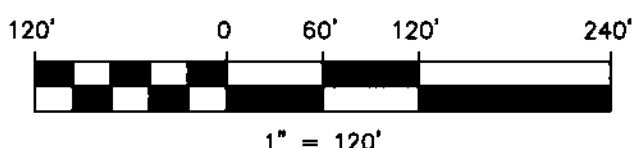

ADVANCED CIVIL DESIGN
 ENGINEERS SURVEYORS

422 Beecher Road
 Gahanna, Ohio 43230
 ph 614.428.7750
 fax 614.428.7755