I-2-D
I-5-B

EMH&T
Evans, Mechwart, Hambleton & Tilton, Inc.
Engineers • Surveyors • Planners • Scientists
5500 New Albany Road, Columbus, OH 43054
Phone: 614.775.4500 Toll Free: 888.775.3648
emht.com

SURVEY OF ACREAGE PARCEL

LOTS 24 & 25, QUARTER TOWNSHIP 1, TOWNSHIP 2, RANGE 17 UNITED STATES MILITARY LANDS CITY OF COLUMBUS, COUNTY OF FRANKLIN, STATE OF OHIO

Date: March 11, 2019 | Job No: 2017-0716 | Scale: 1" = 200'

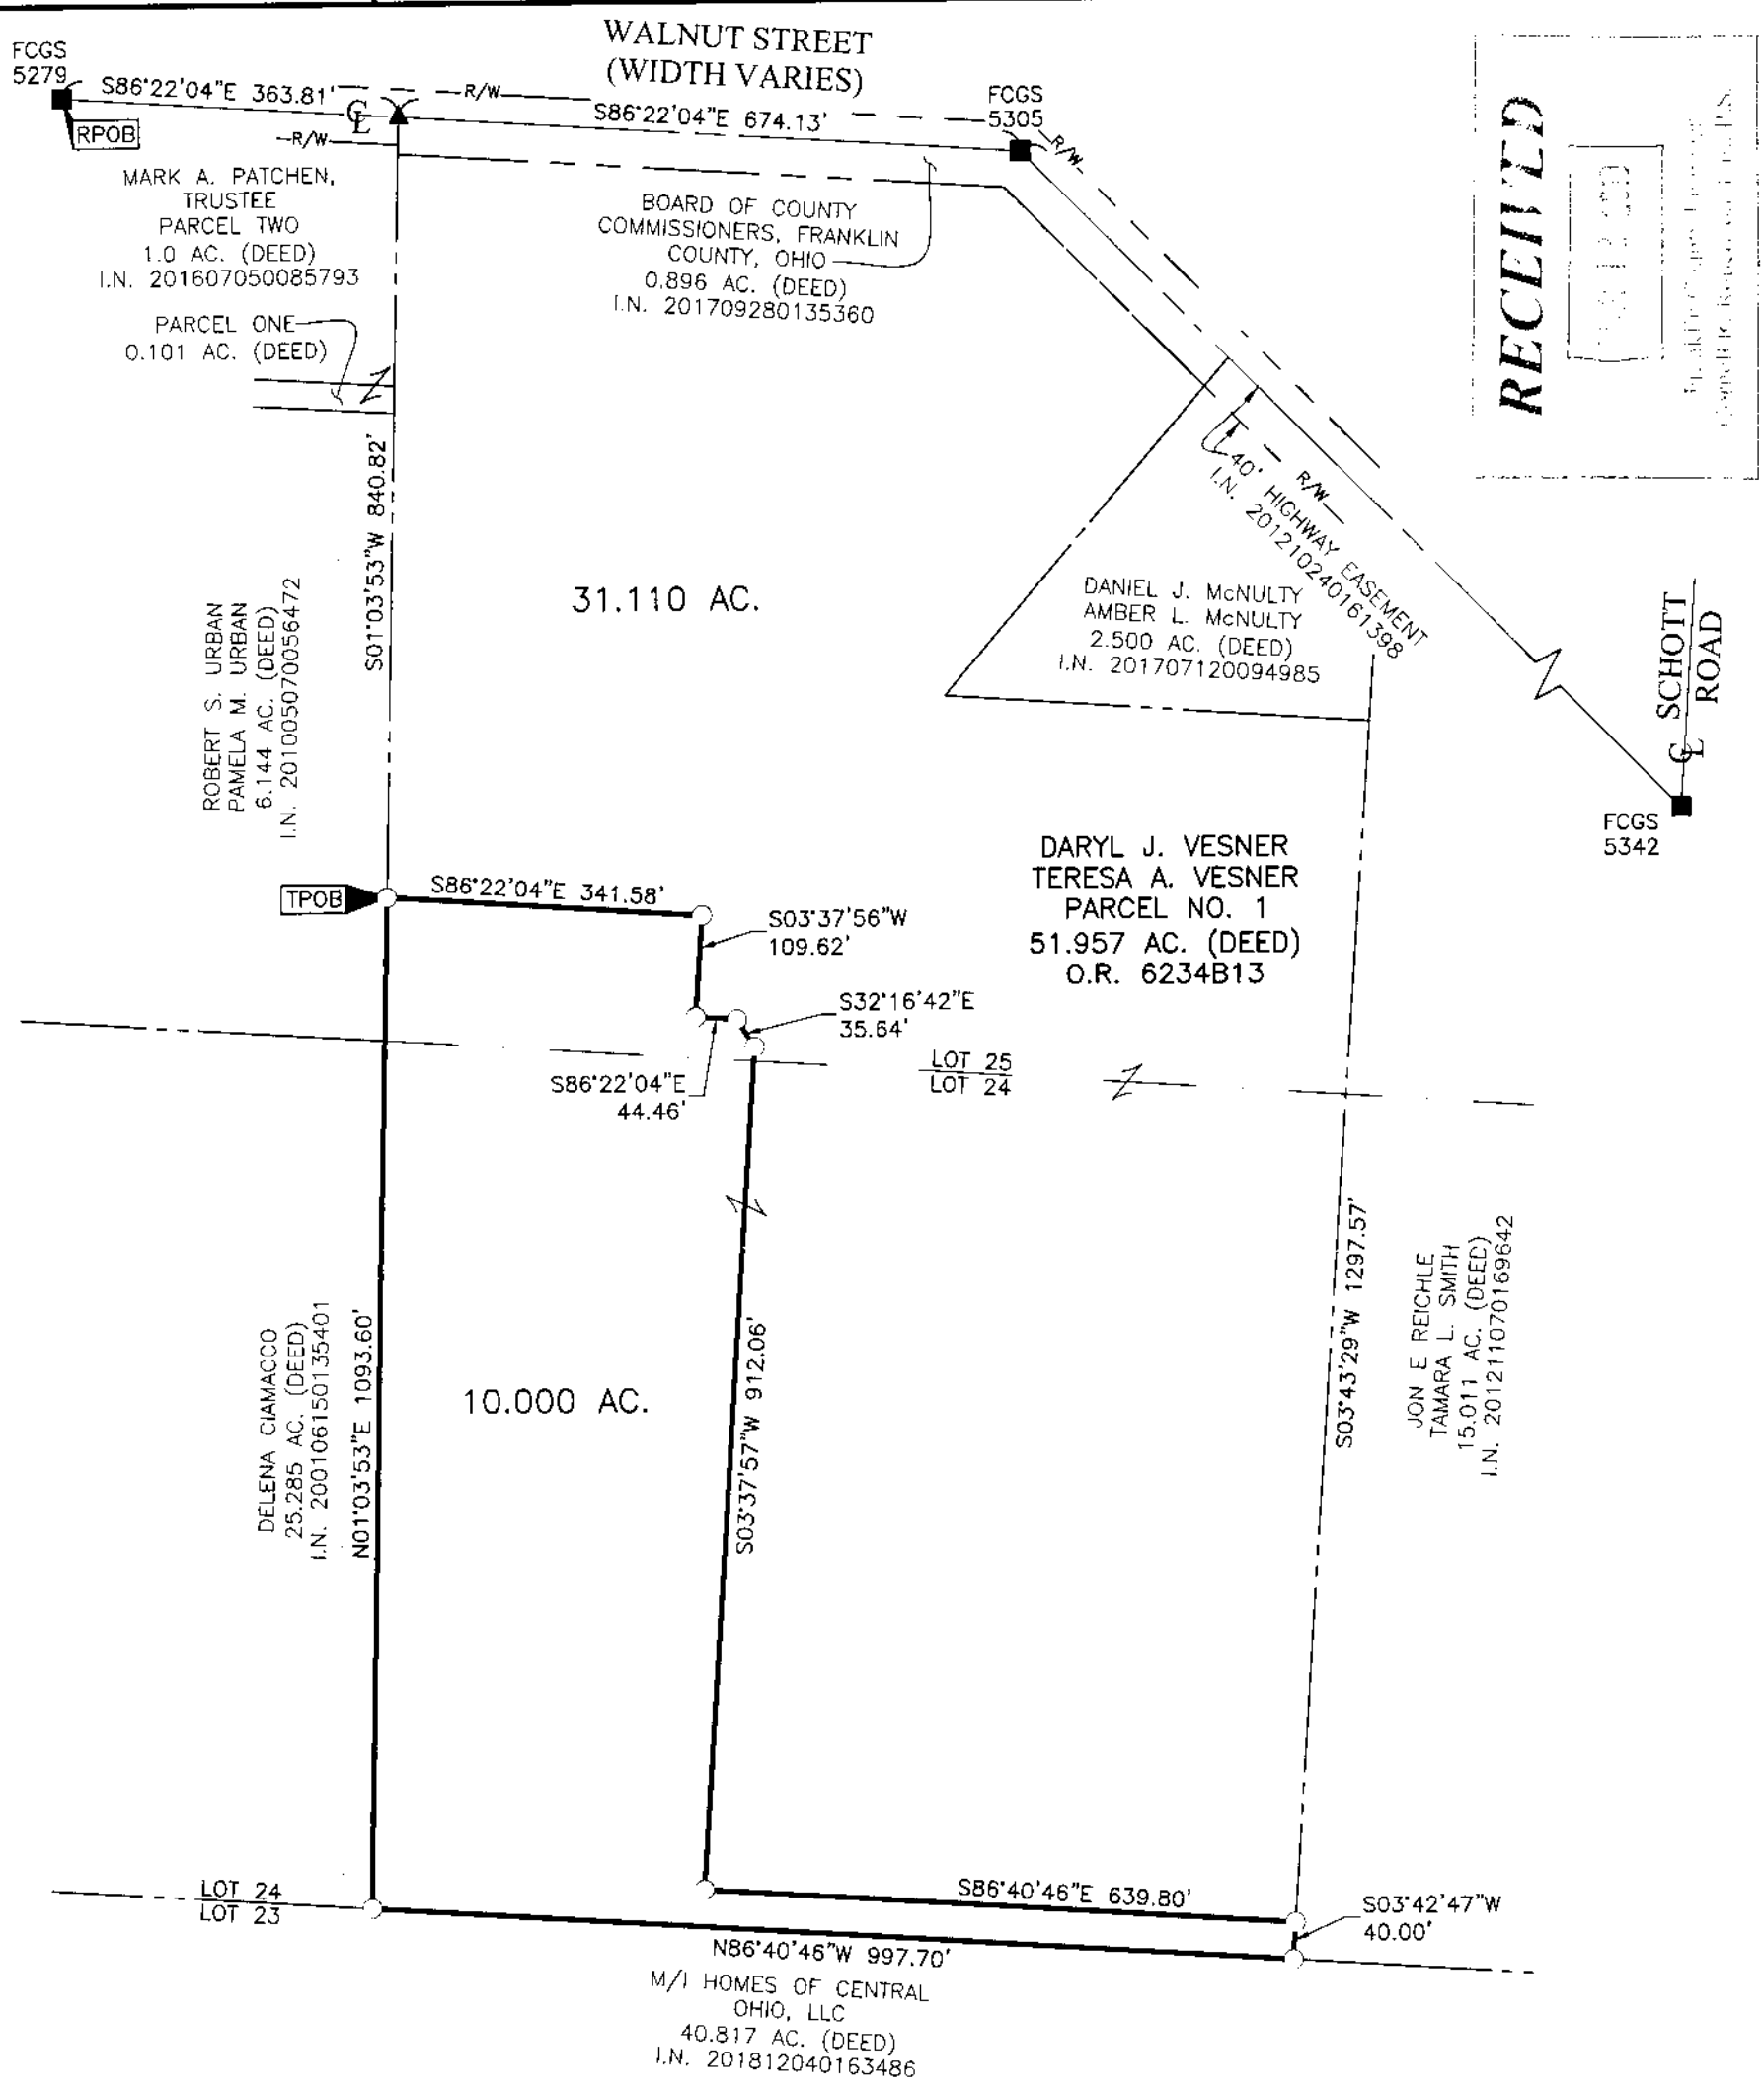

RECEIVED

= STONE FND.
■ = MON. FND.
● = I.P. FND.
○ = I.P. SET
⬟ = MAG. NAIL FND.
⬡ = MAG. NAIL SET
▲ = R.R. SPK. FND.
△ = R.R. SPK. SET
⬟ = P.K. NAIL FND.

I.P. Set are 13/16" I.D. iron pipes 30" long with cap inscribed EMHT INC.

200 0 200 400
GRAPHIC SCALE (in feet)

BASIS OF BEARINGS:
The bearings shown hereon are based on the Ohio State Plane Coordinate System, South Zone, NAD83 (2007). Said bearings originated from a field traverse which was tied (referenced) to said coordinate system by GPS observations of FCGS Monument Numbers 5279 and 5305, having a bearing of South 86° 22' 04" East between said monuments.

SURVEY NOTE:
This survey was prepared using documents of record, prior plats of survey, and observed evidence located by an actual field survey.

STATE OF OHIO
MATTHEW A. KIRK
S-7865
REGISTERED
PROFESSIONAL SURVEYOR

By Matthew A. Kirk 11 MARCH 19
Matthew A. Kirk, Professional Surveyor No. 7865 — Date

J:\20170716\DWG\04SHEETS\BOUNDARY\20170716-VS-BNDY-01.DWG plotted by KIRK, MATTHEW on 3/11/2019 12:18:24 PM last saved by MKIRK on 3/8/2019 3:01:15 PM
Xrefs: