I-7-c

# 11.429 Acre Exhibit

QUARTER TOWNSHIP 4, TOWNSHIP 2, RANGE 17
UNITED STATES MILITARY DISTRICT
CITY OF COLUMBUS, FRANKLIN COUNTY, OHIO

Bearings are based on the Ohio State Plane Coordinate System, South Zone, NAD83 (NSRS2007). Said bearings were derived from GPS observation and determine a portion of the westerly right of way line of Cherry Bottom Road having a bearing of S04°45'12"E.

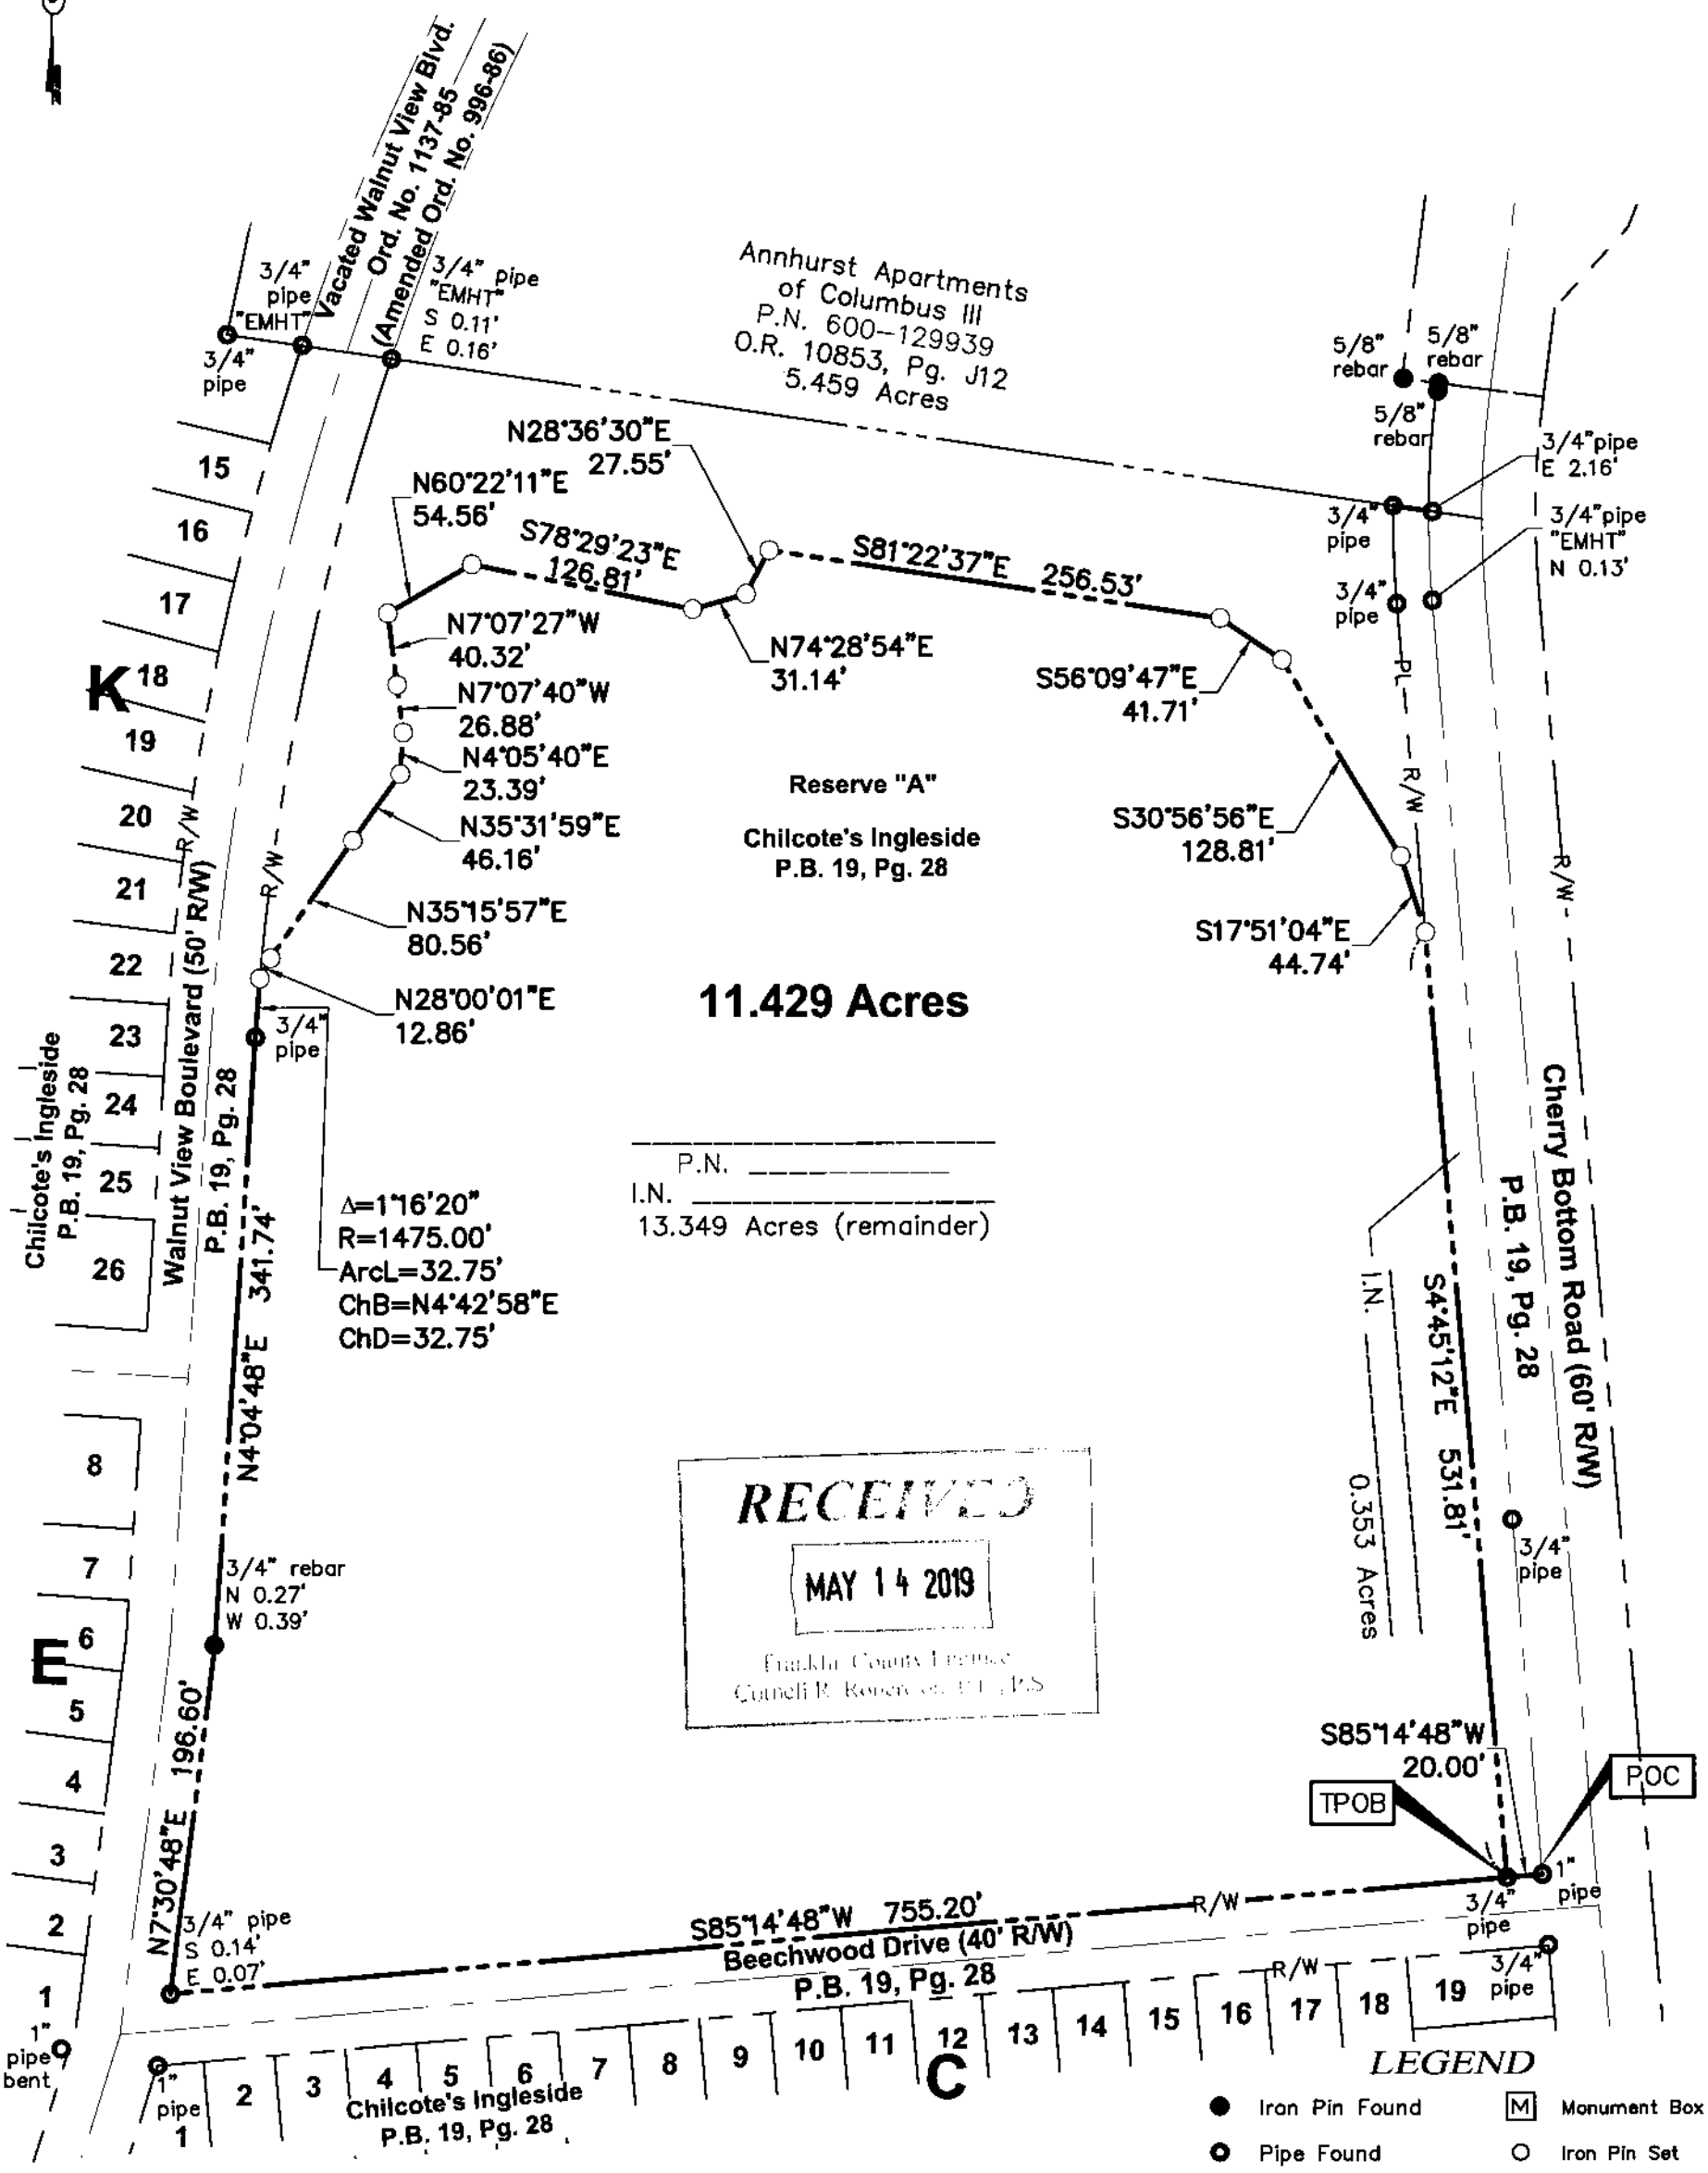


RECEIVED
MAY 14 2019
Franklin County Engineer
Cornell R. Robertson, P.E., P.S.

All iron pins set are 3/4" diameter, 30" long iron pipe with plastic cap inscribed "Advanced 7661".

This Survey is based on existing records from Franklin County, and from actual field survey work.

ADVANCED CIVIL DESIGN, INC.

Jonathan E. Phelps 5/14/19
Jonathan E. Phelps Date
Reg. No. 8241

GRAPHIC SCALE
100 0 50 100
( IN FEET )
1 inch = 100 ft.

| | |
|---|---|
| DRAWN BY: JEP | JOB NO.: 18-0025-414 |
| DATE: 05/14/2019 | CHECKED BY: JEP |


ADVANCED CIVIL DESIGN
ENGINEERS SURVEYORS
422 Beecher Road
Gahanna, Ohio 43230
ph 614.428.7750
fax 614.428.7755


Z:\18-0025-414\DWG\PRODUCTION DRAWINGS\SURVEY\0025-414 11.429 Ac Split_South.dwg 11by17 SOUTH SPLIT May 14, 2019 - 9:02:57am jphelps