

Myers Surveying Company, Inc.

2740 East Main Street, Columbus 43209 (Bexley), Ohio

614-235-8677

FAX: 614-235-4559


A Boundary Survey prepared for and certified to:

William B. Ingold

Legal Description: Situated in The State of Ohio, County of Franklin, City of Groveport Being 5.134 Acres & 5.201 Acres, Part of Section 19, Township 11, Range 21, Congress Lands

Applicant:

Posted Address: Old Groveport Rd., Groveport, Ohio

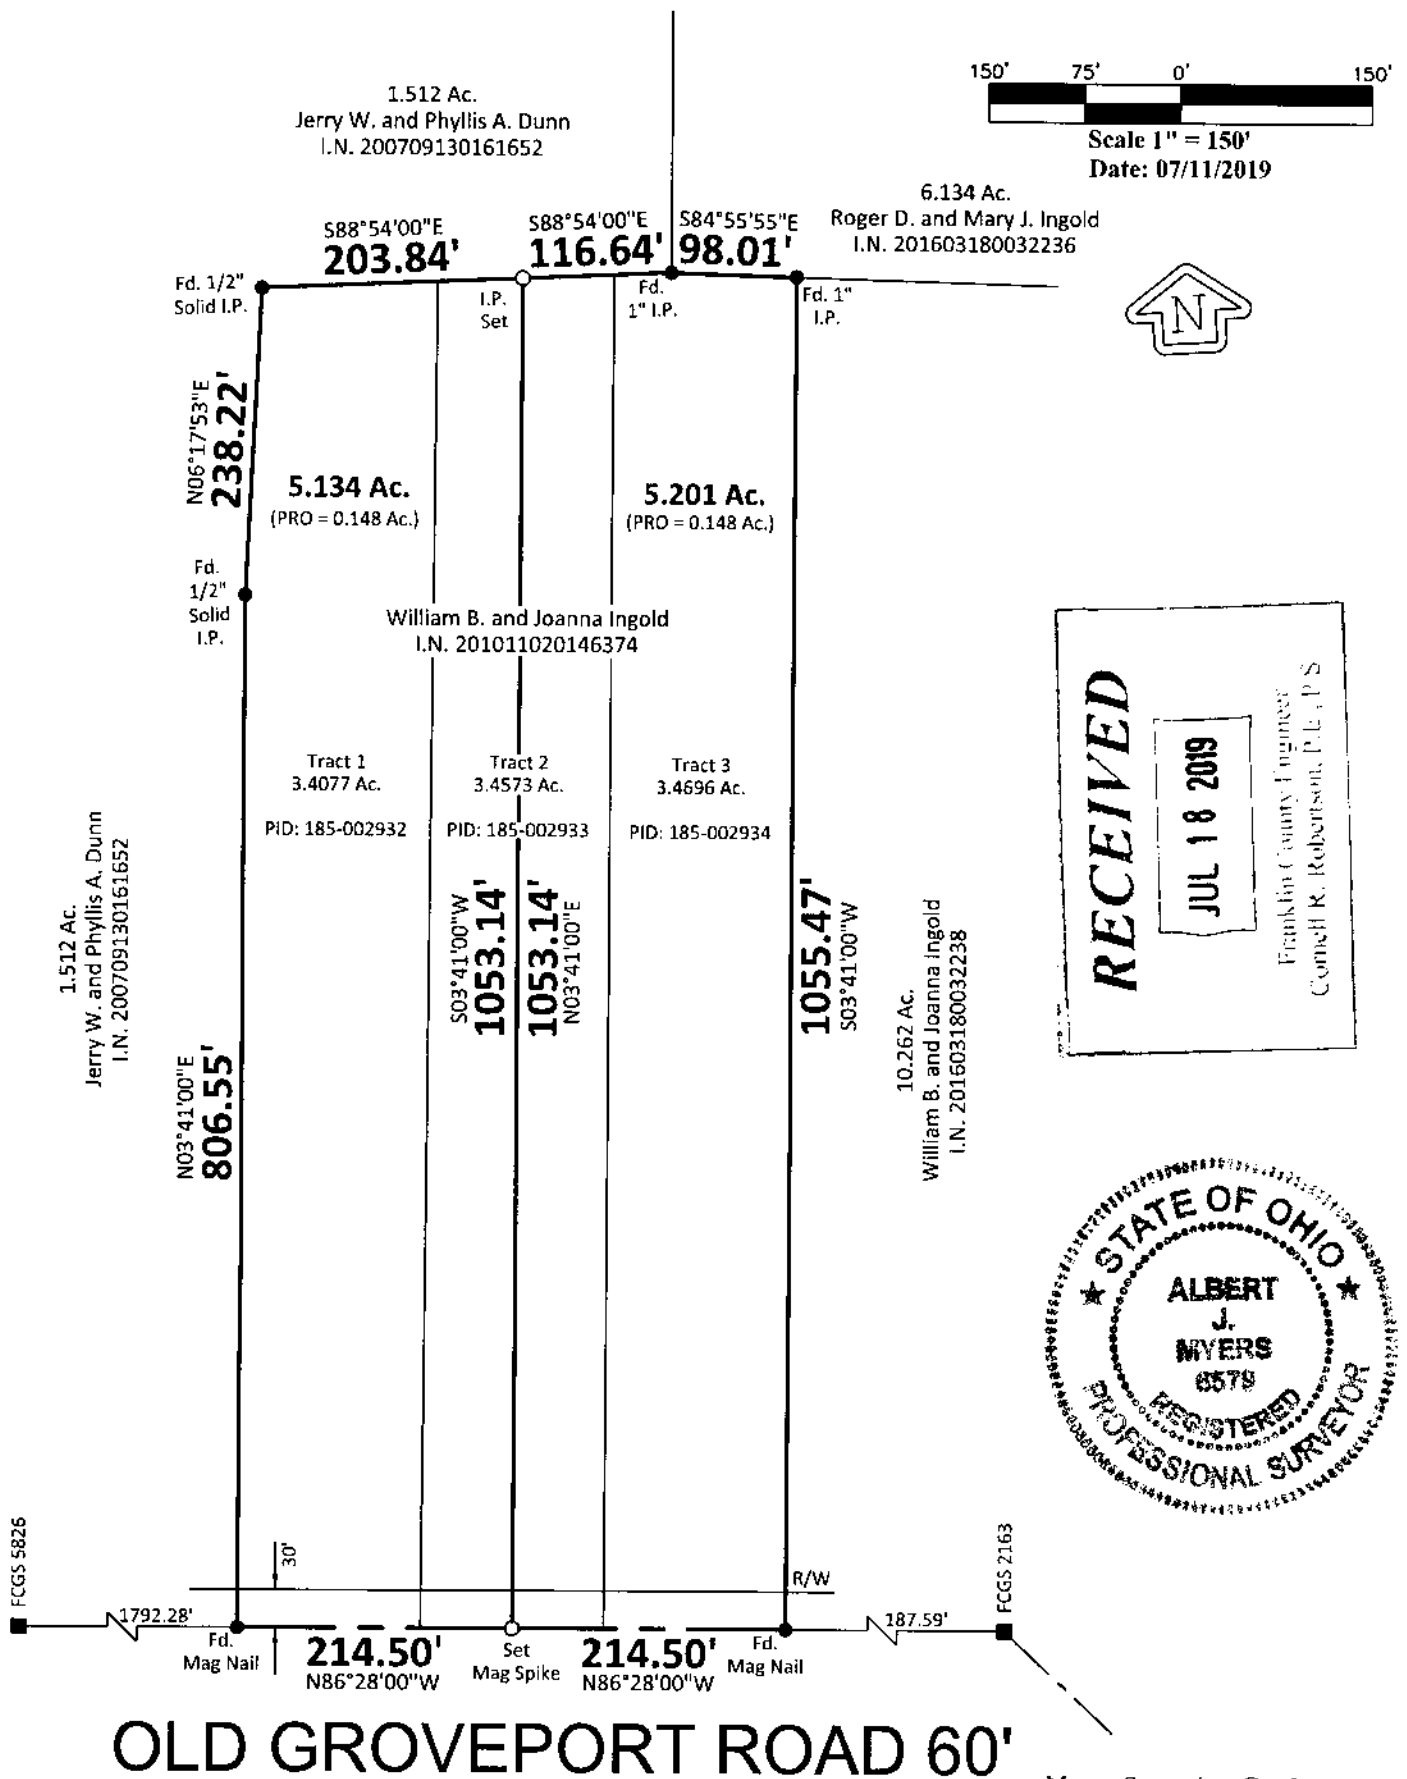

Myers Surveying Co., Inc

By Albert J. Myers
Professional Surveyor
7/11/19

We hereby certify that the foregoing Boundary Survey was prepared from actual field measurements in accordance with Chapter 4733-37 Ohio Administrative Code. Iron pipes set are 30"x1" O.D. with an orange plastic plug inscribed "MYERS P.S. 6579", unless otherwise noted. Basis of bearings is N86°28'00"W on the centerline of Old Groveport Road as recorded in Instrument Number 201011020146374, Tract 2.

| | | | | | |
|------------------------------|------|-------|------|------|-----|
| Myers Order No.-7-05/20/2019 | Rec. | Field | DWG. | Ltr. | Ck. |
|------------------------------|------|-------|------|------|-----|