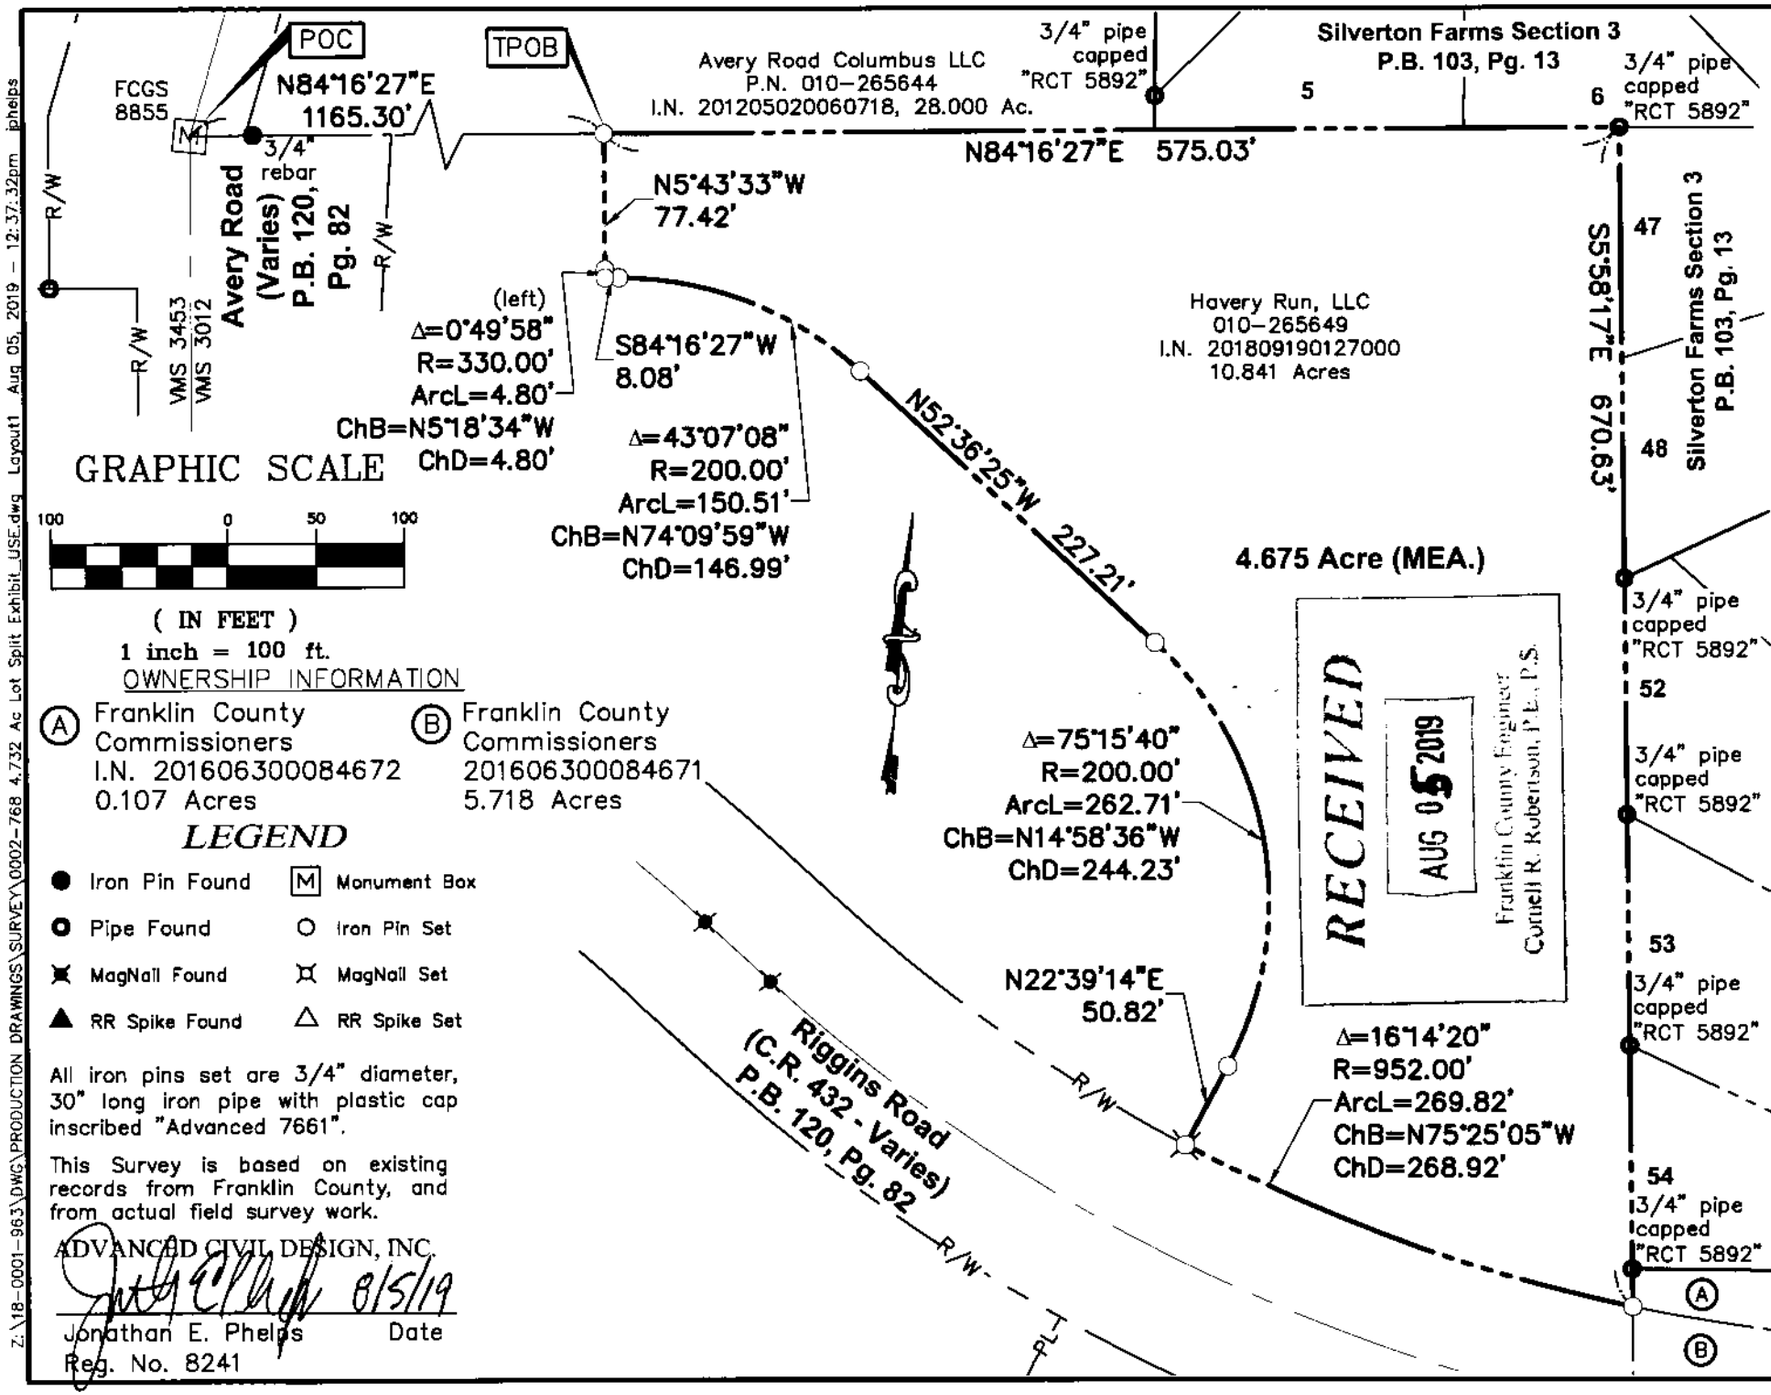

Z:\18-0001-963\DWG\PRODUCTION DRAWINGS\SURVEY\0002-768 4.732 Ac Lot Split Exhibit_USE.dwg Layout1 Aug 05, 2019 - 12:37:32pm jphelps