




6121 Huntley Road - Columbus, Ohio 43229-1003
Ph.: (614) 888-0040 Fax: (614) 848-6712

TREMBLY FAMILY LIMITED PARTNERSHIP TWO

STATE OF OHIO, FRANKLIN COUNTY,
CITY OF COLUMBUS, VIRGINIA MILITARY
SURVEY NO. 1425, 12394 & 13950

1.865 ACRE TRACT

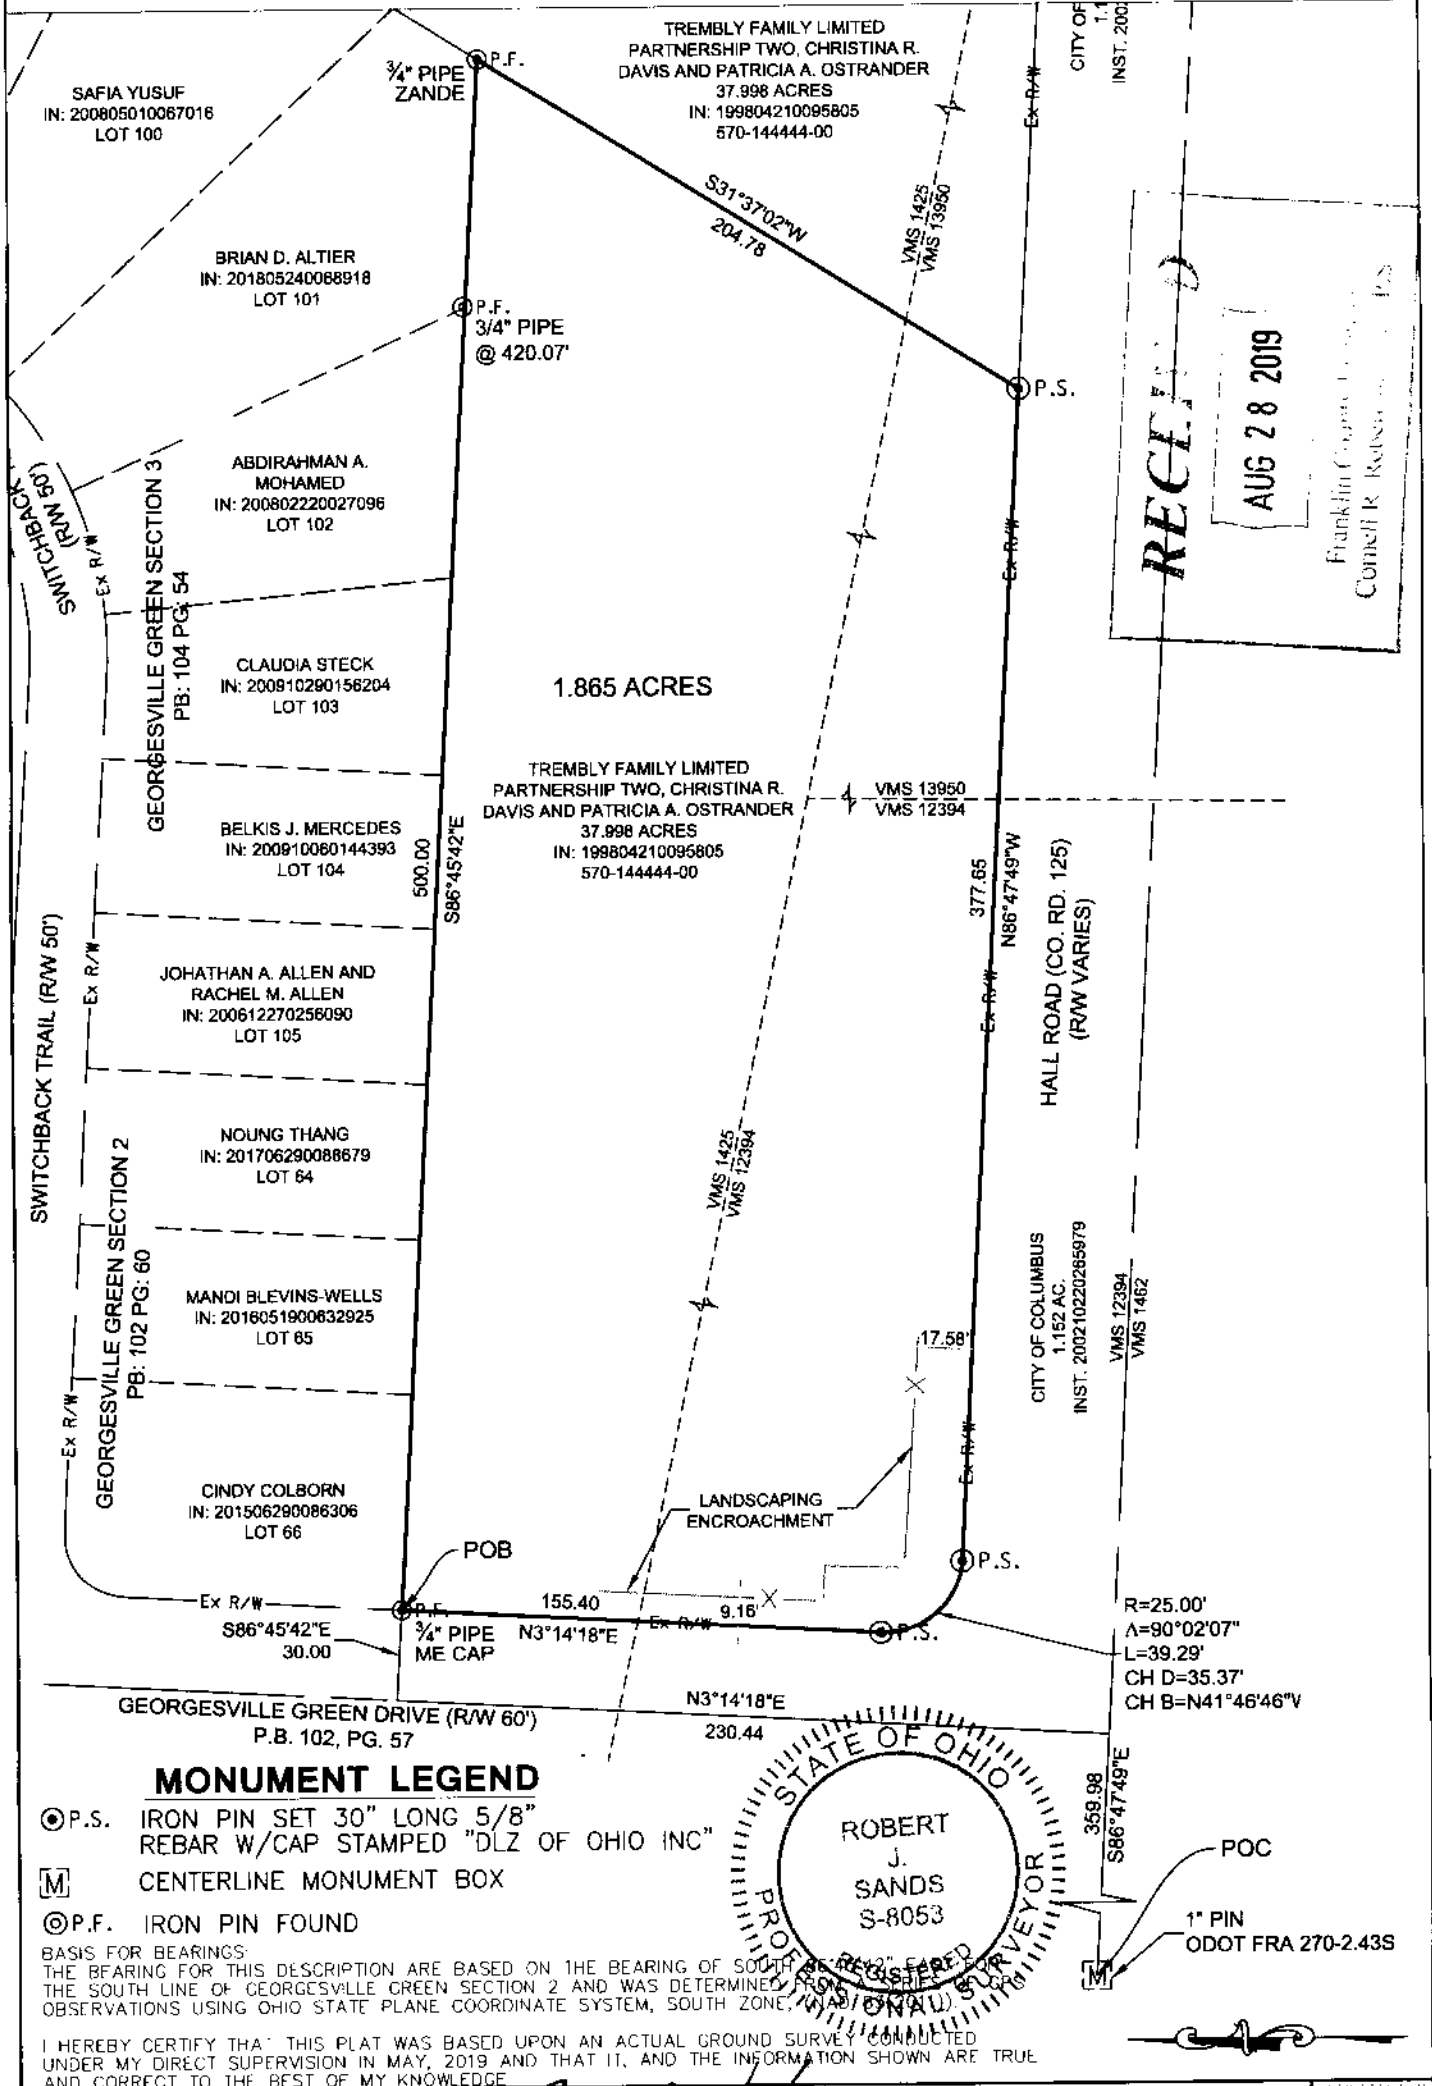



RECEIVED
AUG 28 2019
Franklin County Surveyor
Cornell R. Roberts, S-8053

MONUMENT LEGEND

- ⊙ P.S. IRON PIN SET 30" LONG 5/8" REBAR W/CAP STAMPED "DLZ OF OHIO INC"
- [M] CENTERLINE MONUMENT BOX
- ⊙ P.F. IRON PIN FOUND

BASIS FOR BEARINGS:
THE BEARING FOR THIS DESCRIPTION ARE BASED ON THE BEARING OF SOUTH AS RECORDED FROM THE SOUTH LINE OF GEORGESVILLE GREEN SECTION 2 AND WAS DETERMINED FROM THE OBSERVATIONS USING OHIO STATE PLANE COORDINATE SYSTEM, SOUTH ZONE.

I HEREBY CERTIFY THAT THIS PLAT WAS BASED UPON AN ACTUAL GROUND SURVEY CONDUCTED UNDER MY DIRECT SUPERVISION IN MAY, 2019 AND THAT IT, AND THE INFORMATION SHOWN ARE TRUE AND CORRECT TO THE BEST OF MY KNOWLEDGE.

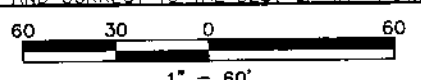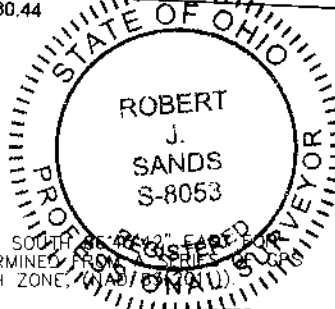

Robert J. Sands
ROBERT J. SANDS, OHIO REGISTERED PROFESSIONAL SURVEYOR, S-8053 DATE: 06/14/19

DLZ
RJS