




Evans, Mechwart, Hambleton & Tilton, Inc.  
Engineers • Surveyors • Planners • Scientists  
5500 New Albany Road, Columbus, OH 43054  
Phone: 614.775.4500 Toll Free: 888.775.3648  
emht.com

# SURVEY OF ACREAGE PARCEL

## VIRGINIA MILITARY DISTRICT SURVEY NO. 6115

### CITY OF GROVE CITY, COUNTY OF FRANKLIN, STATE OF OHIO


Date: November 14, 2019  
Scale: 1" = 40'  
Job No: 2019-0225

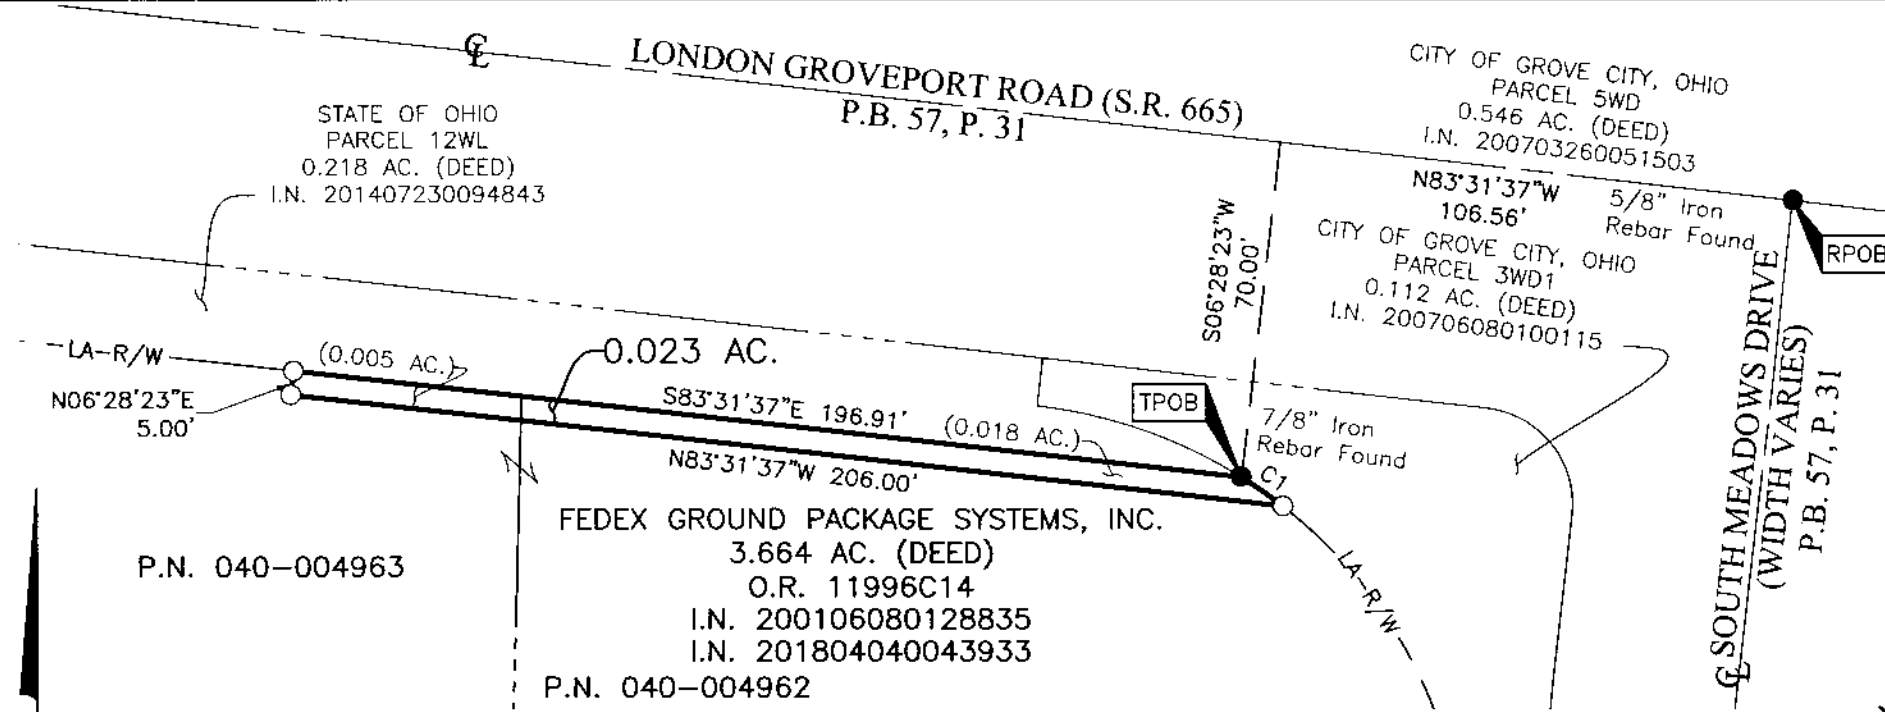

**BASIS OF BEARINGS:**  
Bearings are based on the Ohio State Plane Coordinate System, South Zone, per NAD83 (1986 Adjustment). Control for bearings was from coordinates of monuments FCGS 5548 & FCGS 5539, having a bearing of North 00°21'40" East for a portion of the centerline of Hoover Road, established by the Franklin County Engineering Department.

● = I.P. FND.  
○ = I.P. SET

I.P. Set are 13/16" I.D. iron pipes 30" long with cap inscribed EMHT INC.

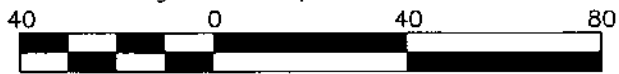


GRAPHIC SCALE (in feet)

**SURVEY NOTE:**  
This survey was prepared using documents of record, prior plats of survey, and observed evidence located by an actual field survey in April 2019.

CURVE TABLE					
CURVE	DELTA	RADIUS	ARC	CH. BEARING	CH. DIST.
C1	5°56'47"	100.00'	10.38'	S54°42'43"E	10.37'

By   
Joshua M. Meyer  
Professional Surveyor No. 8485

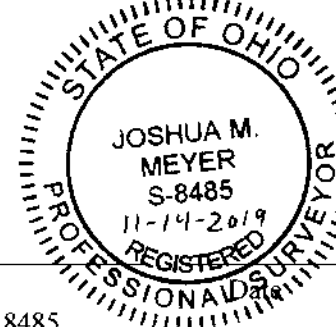

RECEIVED