


Plat of Survey
For

Richard Brungarth

Situate in the State of Ohio, Franklin County, Pleasant Township and being a part of Virginia Military Survey #'s 5178 and 978, being a part of Lot 15 of the Starling Subdivision (Plat Book 1, page 82 Destroyed by fire) and the remainder of an 120.83 acre tract conveyed to Richard and Mary Brungarth as recorded in Deed Book 2249 page 271 (Auditors Parcel # 230-001488

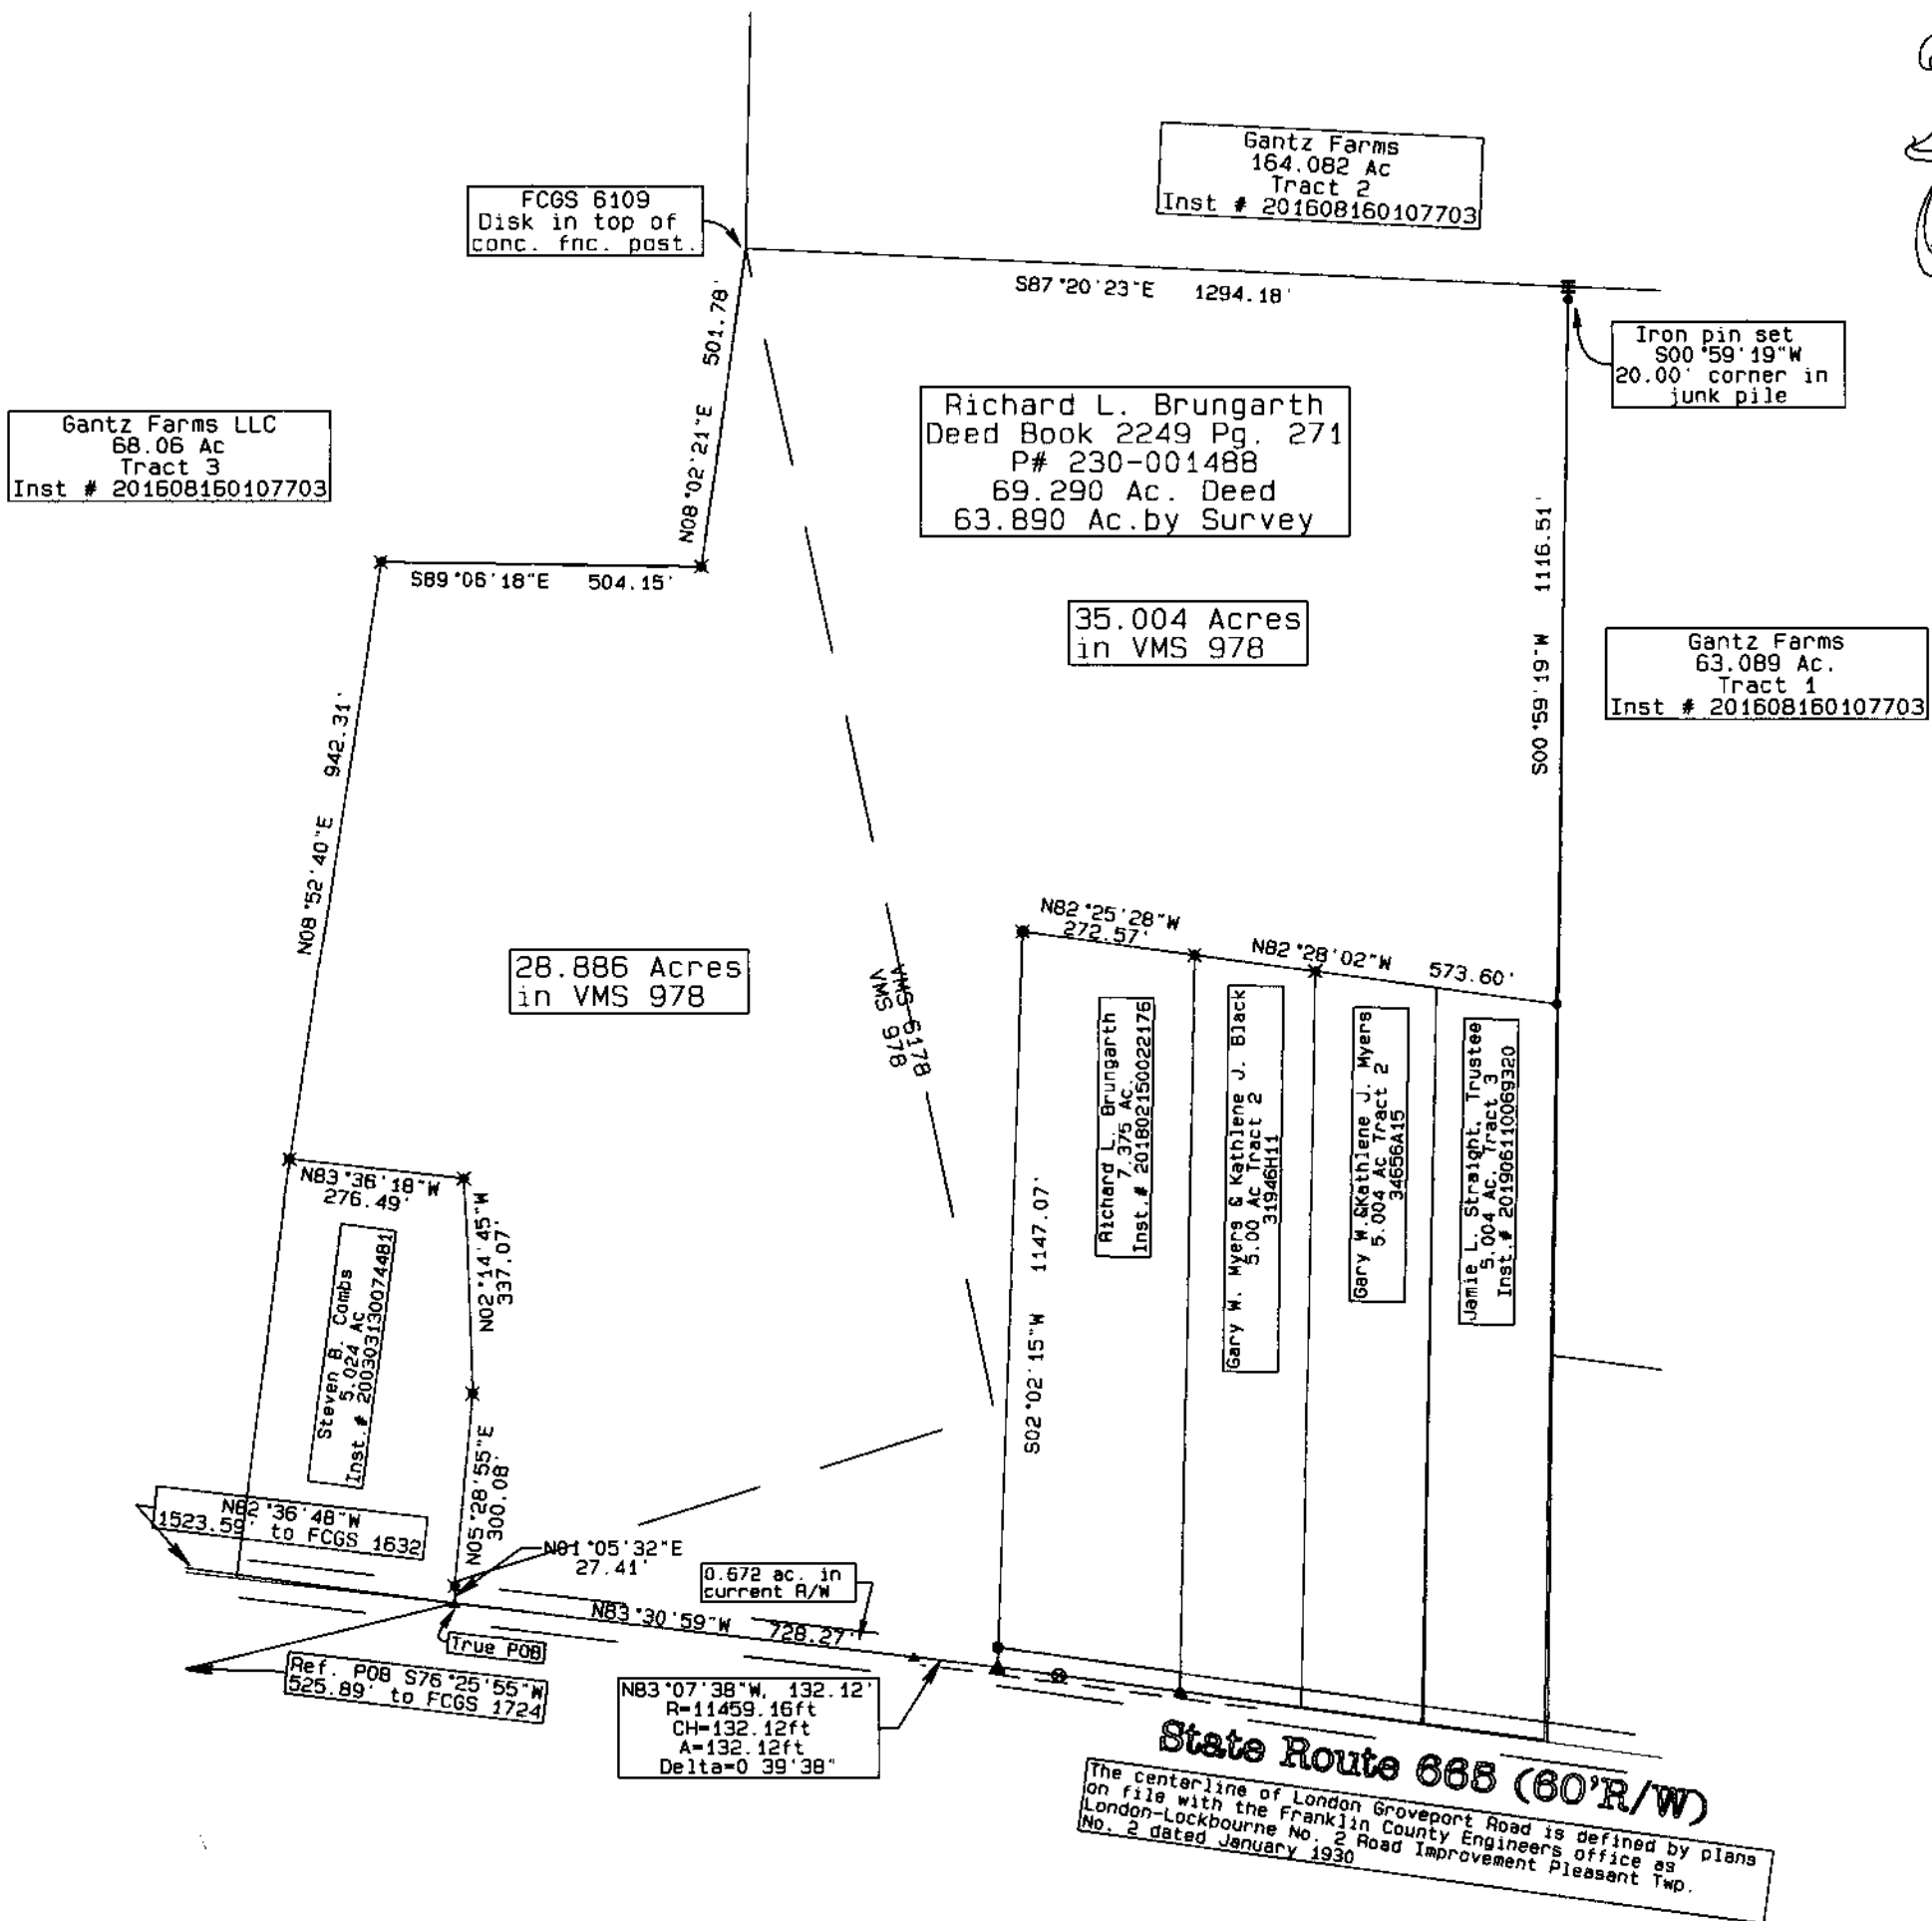

RECEIVED

GRAPHIC SCALE 1"=200'



Basis Of Bearing: The centerline of SR 665 as N83°30'59"W, based on GPS field observations using US State Plane NAD 83 (CORS 2011 adjustment), Ohio South Zone 3402 Coordinate system.

Douglas L. Moore Ohio PS 7011
Douglas L. Moore 11-13-19

I certify the above plat to be the result of an actual field survey performed under my direct knowledge and supervision in November 2019, and meets the minimum standards for boundary surveys in the state of Ohio as adopted and set forth by Ohio Revised Code chapter 4733-37, and local governing requirements if more stringent shall be adhered to.

Reference Materials:
Deeds listed on this plat
Private Surveys on file with
Franklin County Engineers Office
Franklin County GIS
Interviews with property owners

Legend

- 30" x 5/8" rebar Set w/ 1" plastic ID cap inscribed "Moore 7011"
- ▲ Mag Spike Set
- ⊗ Iron Pin Found Properties Noted on Plat

License Survey Services
8311 Harrisburg-London Rd
Orient, Ohio 43146
740-868-7888
Email: dmoore7011@yahoo.com